



NE 1/4 SECTION 26 T13S R31E WM

CURVE TABLE				
NO.	DELTA	RADIUS	LENGTH	CHORD/BEARING
C5	(23°19'02"X48)	(240.50'X48)	(97.87'X48)	N63°30'42"W, 97.20' (S63°01'56"E, 97.20'X48)
C6	5°09'40"	(240.50'X48)	21.66'	N77°45'03"W, 21.66'

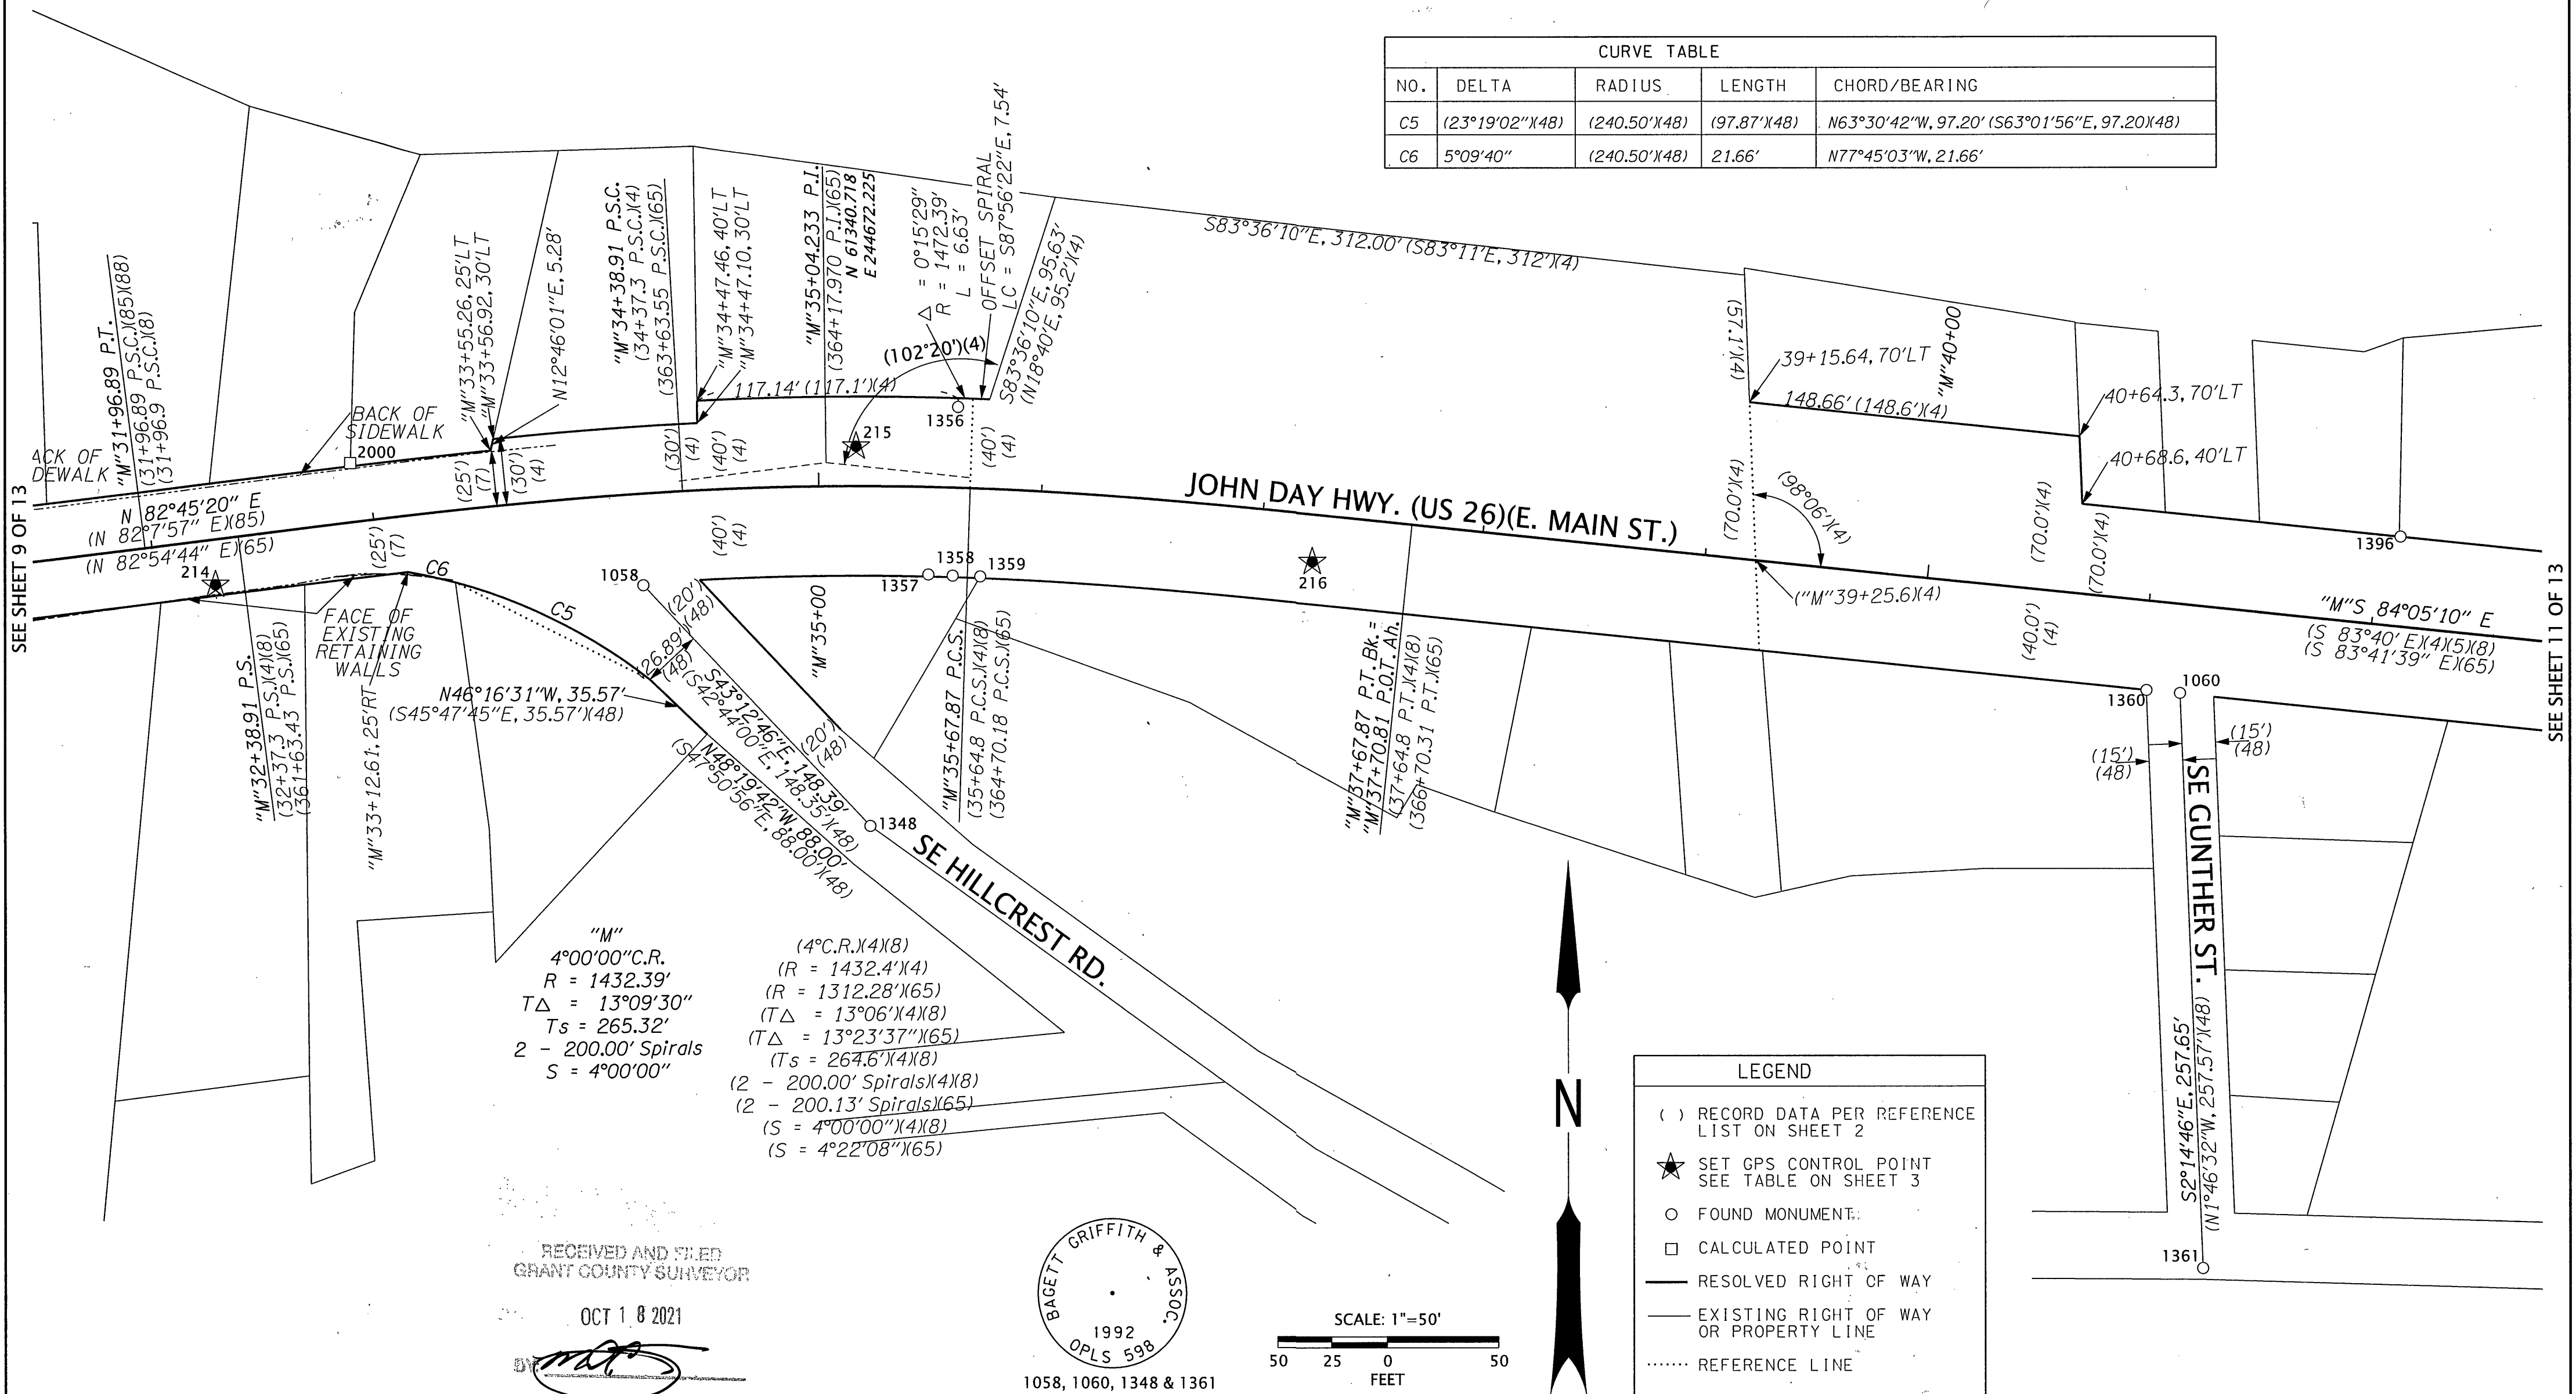

RECEIVED AND FILED
GRANT COUNTY SURVEYOR

OCT 1 8 2021

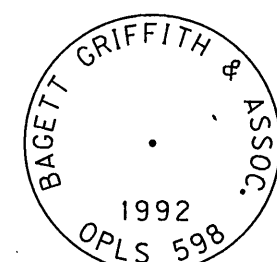

1058, 1060, 1348 & 1361

SCALE: 1"=50'
50 25 0 50
FEET

LEGEND	
()	RECORD DATA PER REFERENCE LIST ON SHEET 2
★	SET GPS CONTROL POINT SEE TABLE ON SHEET 3
○	FOUND MONUMENT
□	CALCULATED POINT
—	RESOLVED RIGHT OF WAY
—	EXISTING RIGHT OF WAY OR PROPERTY LINE
.....	REFERENCE LINE

RECOVERED MONUMENT LIST

PT ID	NORTHING	EASTING	STATION	OFFSET	DATE	DESCRIPTION & REFERENCE DOCUMENTS	FD = FOUND MON. = MONUMENT MOS# = MAP OF SURVEY NO. YPC = YELLOW PLASTIC CAP
1058	61285.85	244590.39	"M"34+18.48	40.81' RT	7/29/2020	FD 2-1/2" BRASS CAP IN MON. BOX MARKED AS SHOWN, DOWN 0.6', MOS#1211	
1060	61237.72	245280.16	"M"41+20.80	39.81' RT	7/29/2020	FD 2-1/2" BRASS CAP IN MON. BOX MARKED AS SHOWN, DOWN 0.5', MOS#1211	
1348	61177.70	244691.99	N/A	N/A	10/20/2020	FD 2-1/2" BRASS CAP IN MON. BOX MARKED AS SHOWN, DOWN 1.6', MOS#1211	
1356	61365.66	244731.41	"M"35+61.42	36.12' LT	10/20/2020	FD 5/8" IRON ROD, BENT NORTH, POST/PADDLE MARKED "SHRP PCS 35+64.8, 35LT" NO RECORD FD	
1357	61290.79	244718.06	"M"35+49.91	39.06' RT	10/20/2020	FD 5/8" IRON ROD, NO CAP, DOWN 0.1', MOS#249	
1358	61290.30	244728.94	"M"35+61.11	39.28' RT	10/20/2020	FD 5/8" IRON ROD WITH YPC MARKED "BGF SURVEY MARKER", DOWN 1.0', MOS#249	
1359	61289.94	244741.30	"M"35+73.82	39.23' RT	10/20/2020	FD 5/8" IRON ROD WITH YPC MARKED "BENCHMARK SURVEYING INC.", FLUSH, MOS#1954	
1360	61239.09	245265.16	"M"41+05.74	40.00' RT	10/20/2020	FD 5/8" IRON ROD, NO CAP, DOWN 0.2', MOS#616	
1361	60980.26	245290.26	N/A	N/A	10/20/2020	FD 2-1/2" BRASS CAP IN MON. BOX MARKED AS SHOWN, DOWN 1.8', MOS#1211	
1396	61307.81	245378.89	"M"42+11.78	40.08' LT	9/9/2021	FD 5/8" IRON ROD WITH YPC MARKED "PLS 848", UP 0.2', MOS#1396	
2000	61340.25	244459.13	"M"32+92.65	26.50' LT	N/A	CALCULATED POINT, NOTHING FOUND OR SET. SEE NARRATIVE	

REGISTERED
PROFESSIONAL
LAND SURVEYOR

Bret N. Elithorp
OREGON
JAN. 14, 2003
BRET N. ELITHORP
63148
EXPIRES: 12-31-2021

OREGON DEPARTMENT OF TRANSPORTATION

HORIZONTAL CONTROL, RECOVERY AND RETRACEMENT MAP
JOHN DAY HIGHWAY (US26) : NW JOHNSON DR. TO SE GUNTHER ST.
JOHN DAY - BURNS HWY. (US395): MAIN ST. TO SW. SECOND AVE.
GRANT COUNTY, OREGON



ODOT REGION 5 TECH CENTER
3012 ISLAND AVENUE
LA GRANDE, OR 97850
KEY NO. 21494

OCTOBER 14, 2021
SCALE: 1"=50'
SHEET 10 OF 13