


NE 1/4 SECTION 26 T13S R31E WM

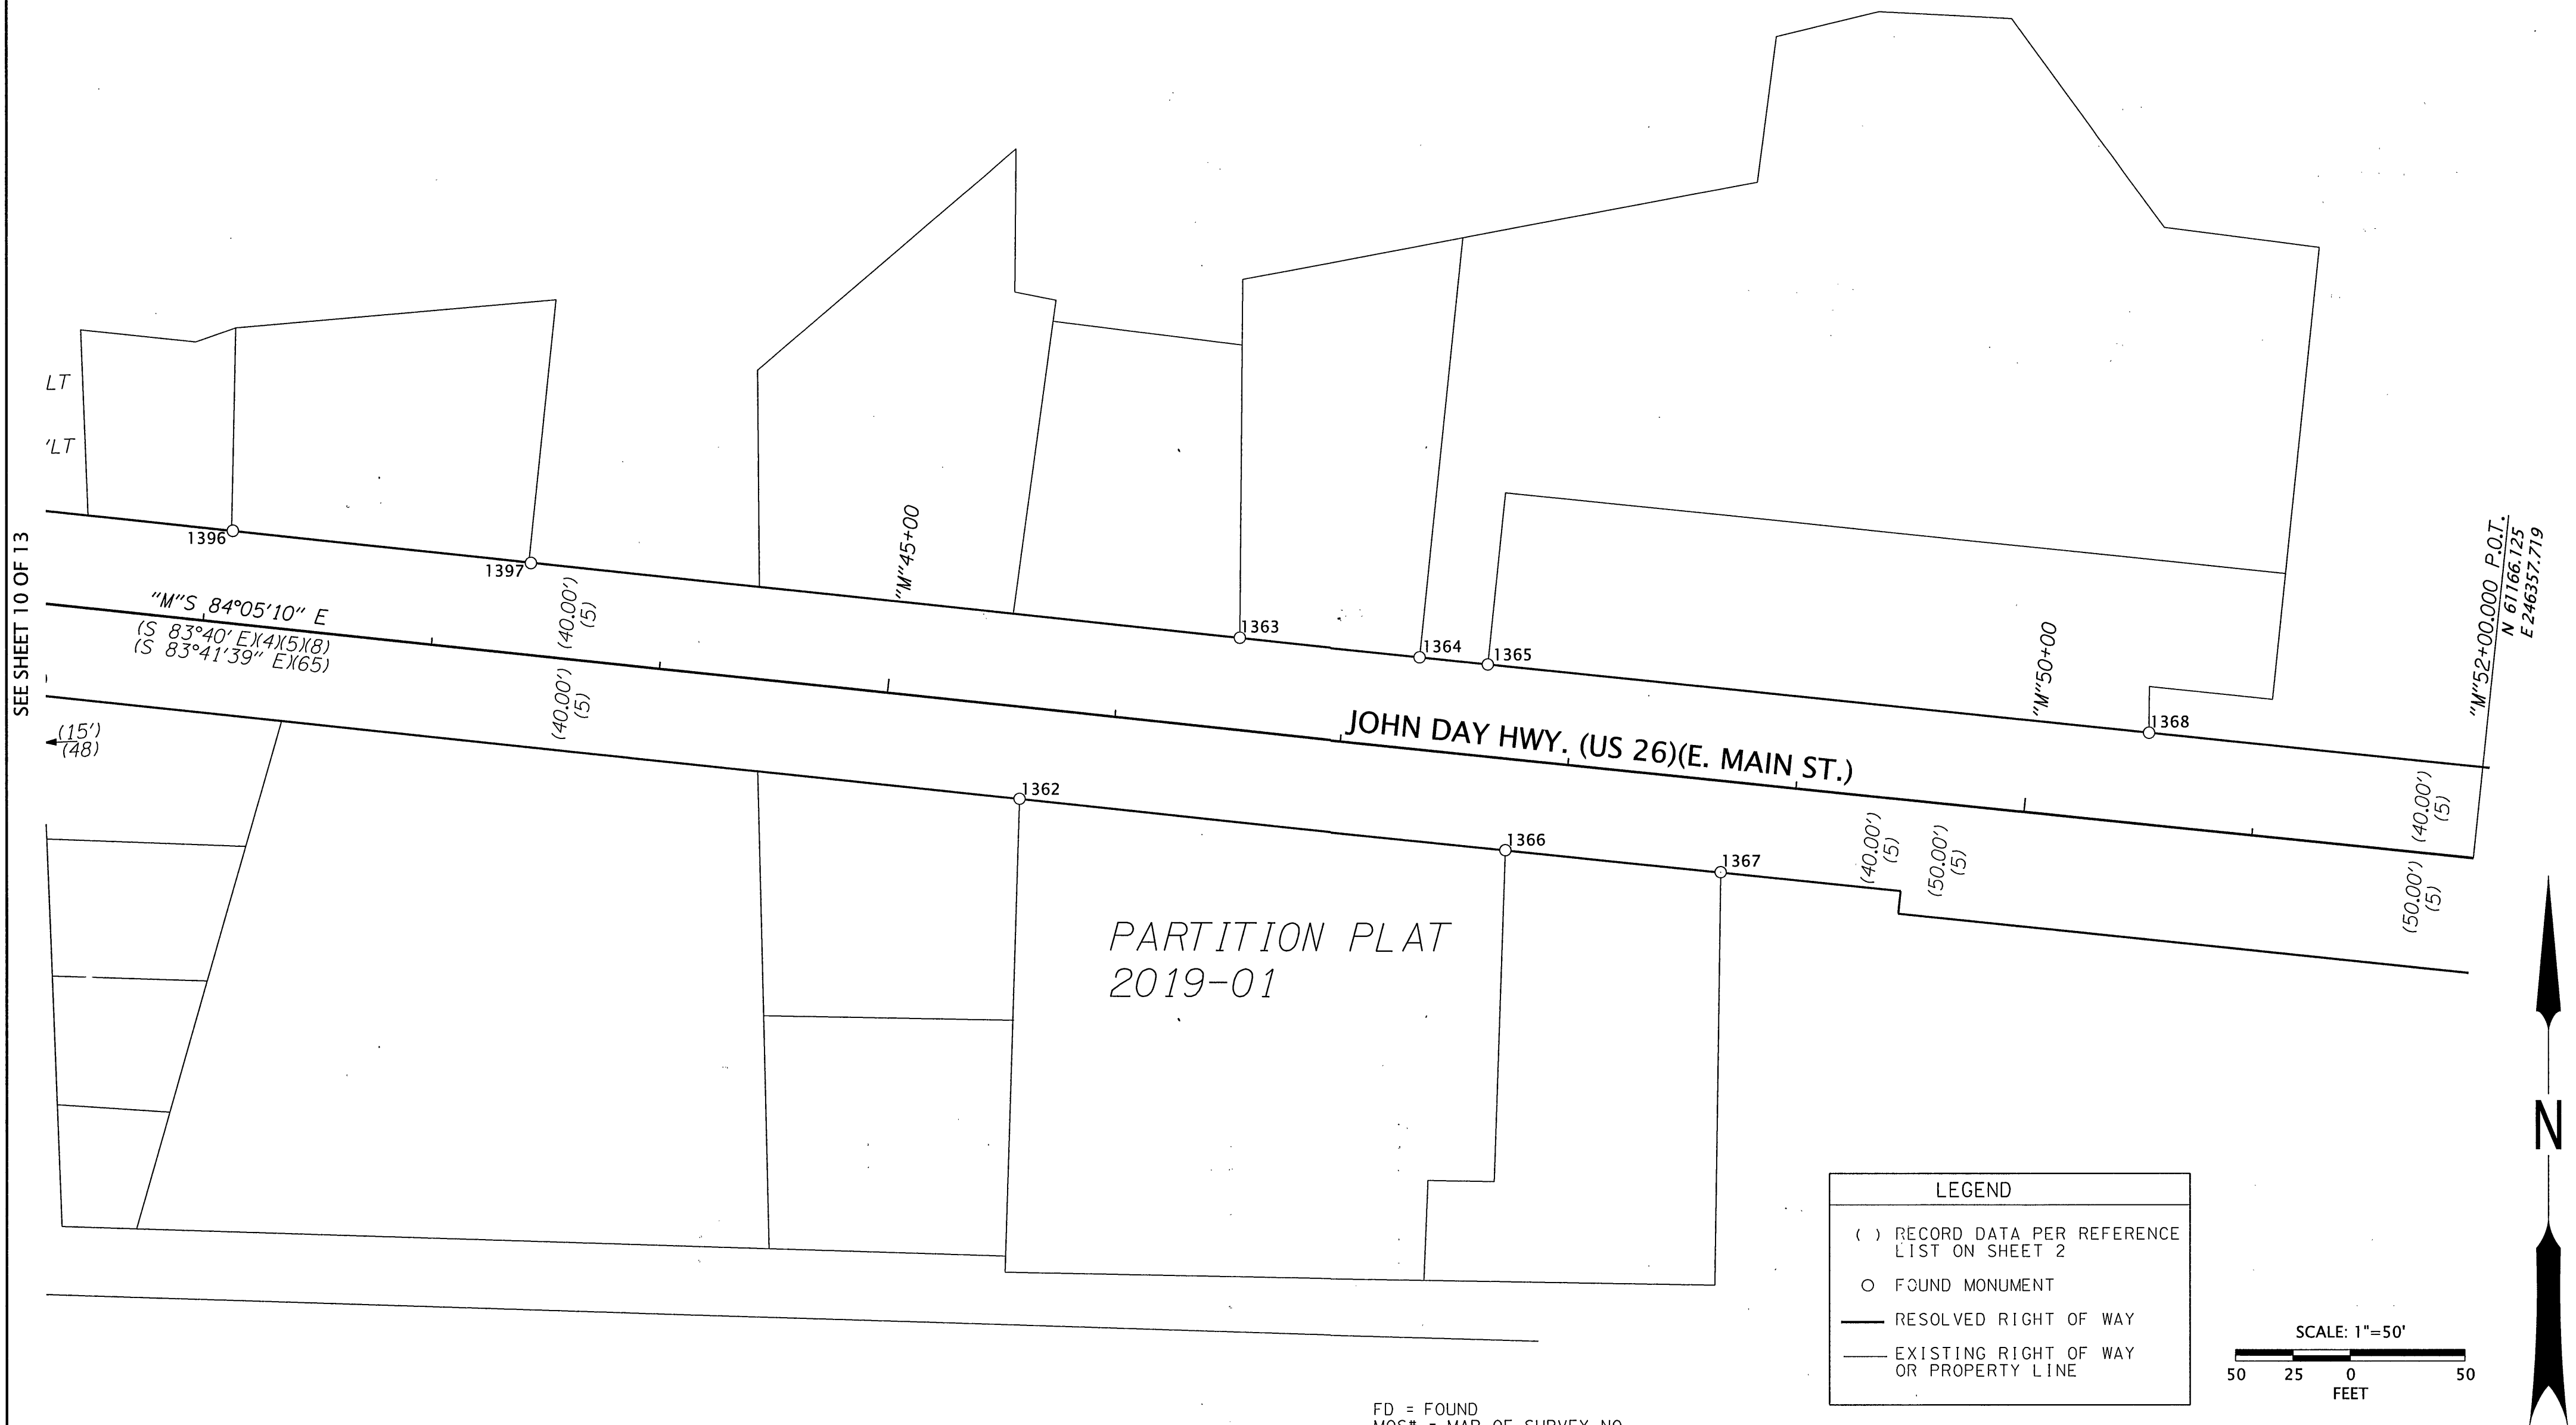

RECOVERED MONUMENT LIST

PT ID	NORTHING	EASTING	STATION	OFFSET	DATE	DESCRIPTION & REFERENCE DOCUMENTS
1362	61191.87	245722.04	"M" 45+65.06	39.88' RT	10/20/2020	FD 5/8" IRON ROD WITH YPC MARKED "BENCHMARK SURVEYING", FLUSH, PP#2019-01
1363	61262.32	245818.46	"M" 46+53.70	40.12' LT	10/20/2020	FD 5/8" IRON ROD, NO CAP, DOWN 0.6', MOS#364
1364	61254.02	245898.03	"M" 46+33.70	40.06' LT	10/20/2020	FD 5/8" IRON ROD, NO CAP, DOWN 0.5', MOS#468
1365	61250.91	245927.85	"M" 47+63.69	40.05' LT	10/20/2020	FD 5/8" IRON ROD WITH RPC MARKED "CORNERSTONE SURVEYING INC.", FLUSH, MOS#1886
1366	61169.77	245935.50	"M" 47+79.65	39.88' RT	10/20/2020	FD 5/8" IRON ROD WITH BROKEN YPC, FLUSH, PP#2019-01
1367	61160.11	246029.37	"M" 48+74.02	39.82' RT	10/20/2020	FD 3/4" IRON PIPE, MOS#89
1368	61220.98	246216.38	"M" 50+53.76	40.00' LT	10/20/2020	FD 5/8" IRON ROD WITH RPC MARKED "CORNERSTONE SURVEYING INC.", FLUSH, MOS#1886
1396	61307.81	245378.89	"M" 42+11.78	40.08' LT	9/9/2021	FD 5/8" IRON ROD WITH YPC MARKED "PLS 848", UP 0.2', MOS#1396
1397	61294.17	245508.85	"M" 43+42.46	39.90' LT	9/9/2021	FD 5/8" IRON ROD WITH YPC MARKED "SURVEY MARKER PLS 848", UP 0.2', MOS#1396

FD = FOUND
MOS# = MAP OF SURVEY NO.
PP# = PARTITION PLAT NO.
RPC = RED PLASTIC CAP
YPC = YELLOW PLASTIC CAP

REGISTERED
PROFESSIONAL
LAND SURVEYOR

Bret N. Elithorp

OREGON
JAN. 14, 2003
BRET N. ELITHORP
63148

EXPIRES: 12-31-2021

OREGON DEPARTMENT OF TRANSPORTATION

HORIZONTAL CONTROL, RECOVERY AND RETRACEMENT MAP
JOHN DAY HIGHWAY (US26) : NW JOHNSON DR. TO SE GUNTHER ST.
JOHN DAY - BURNS HWY. (US395): MAIN ST. TO SW. SECOND AVE.
GRANT COUNTY, OREGON



ODOT REGION 5 TECH CENTER
3012 ISLAND AVENUE
LA GRANDE, OR 97850
KEY NO. 21494

OCTOBER 14, 2021
SCALE: 1"=50'
SHEET 11 OF 13