

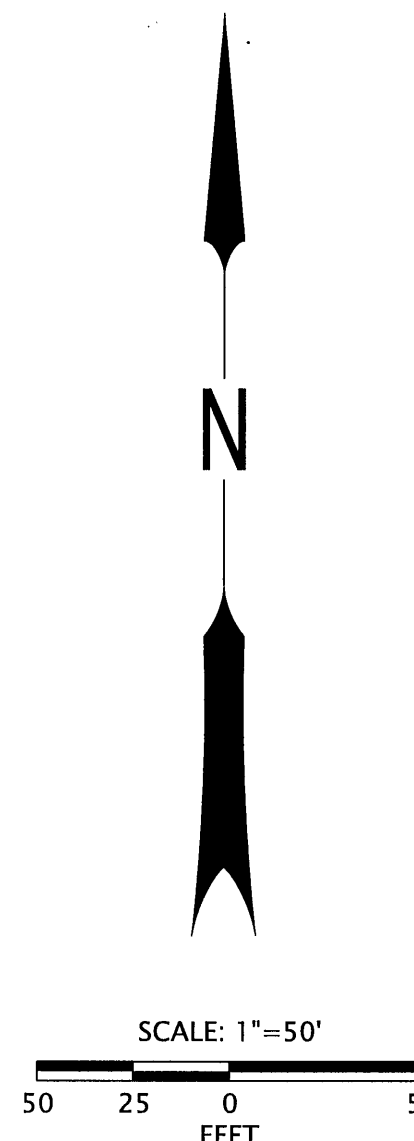
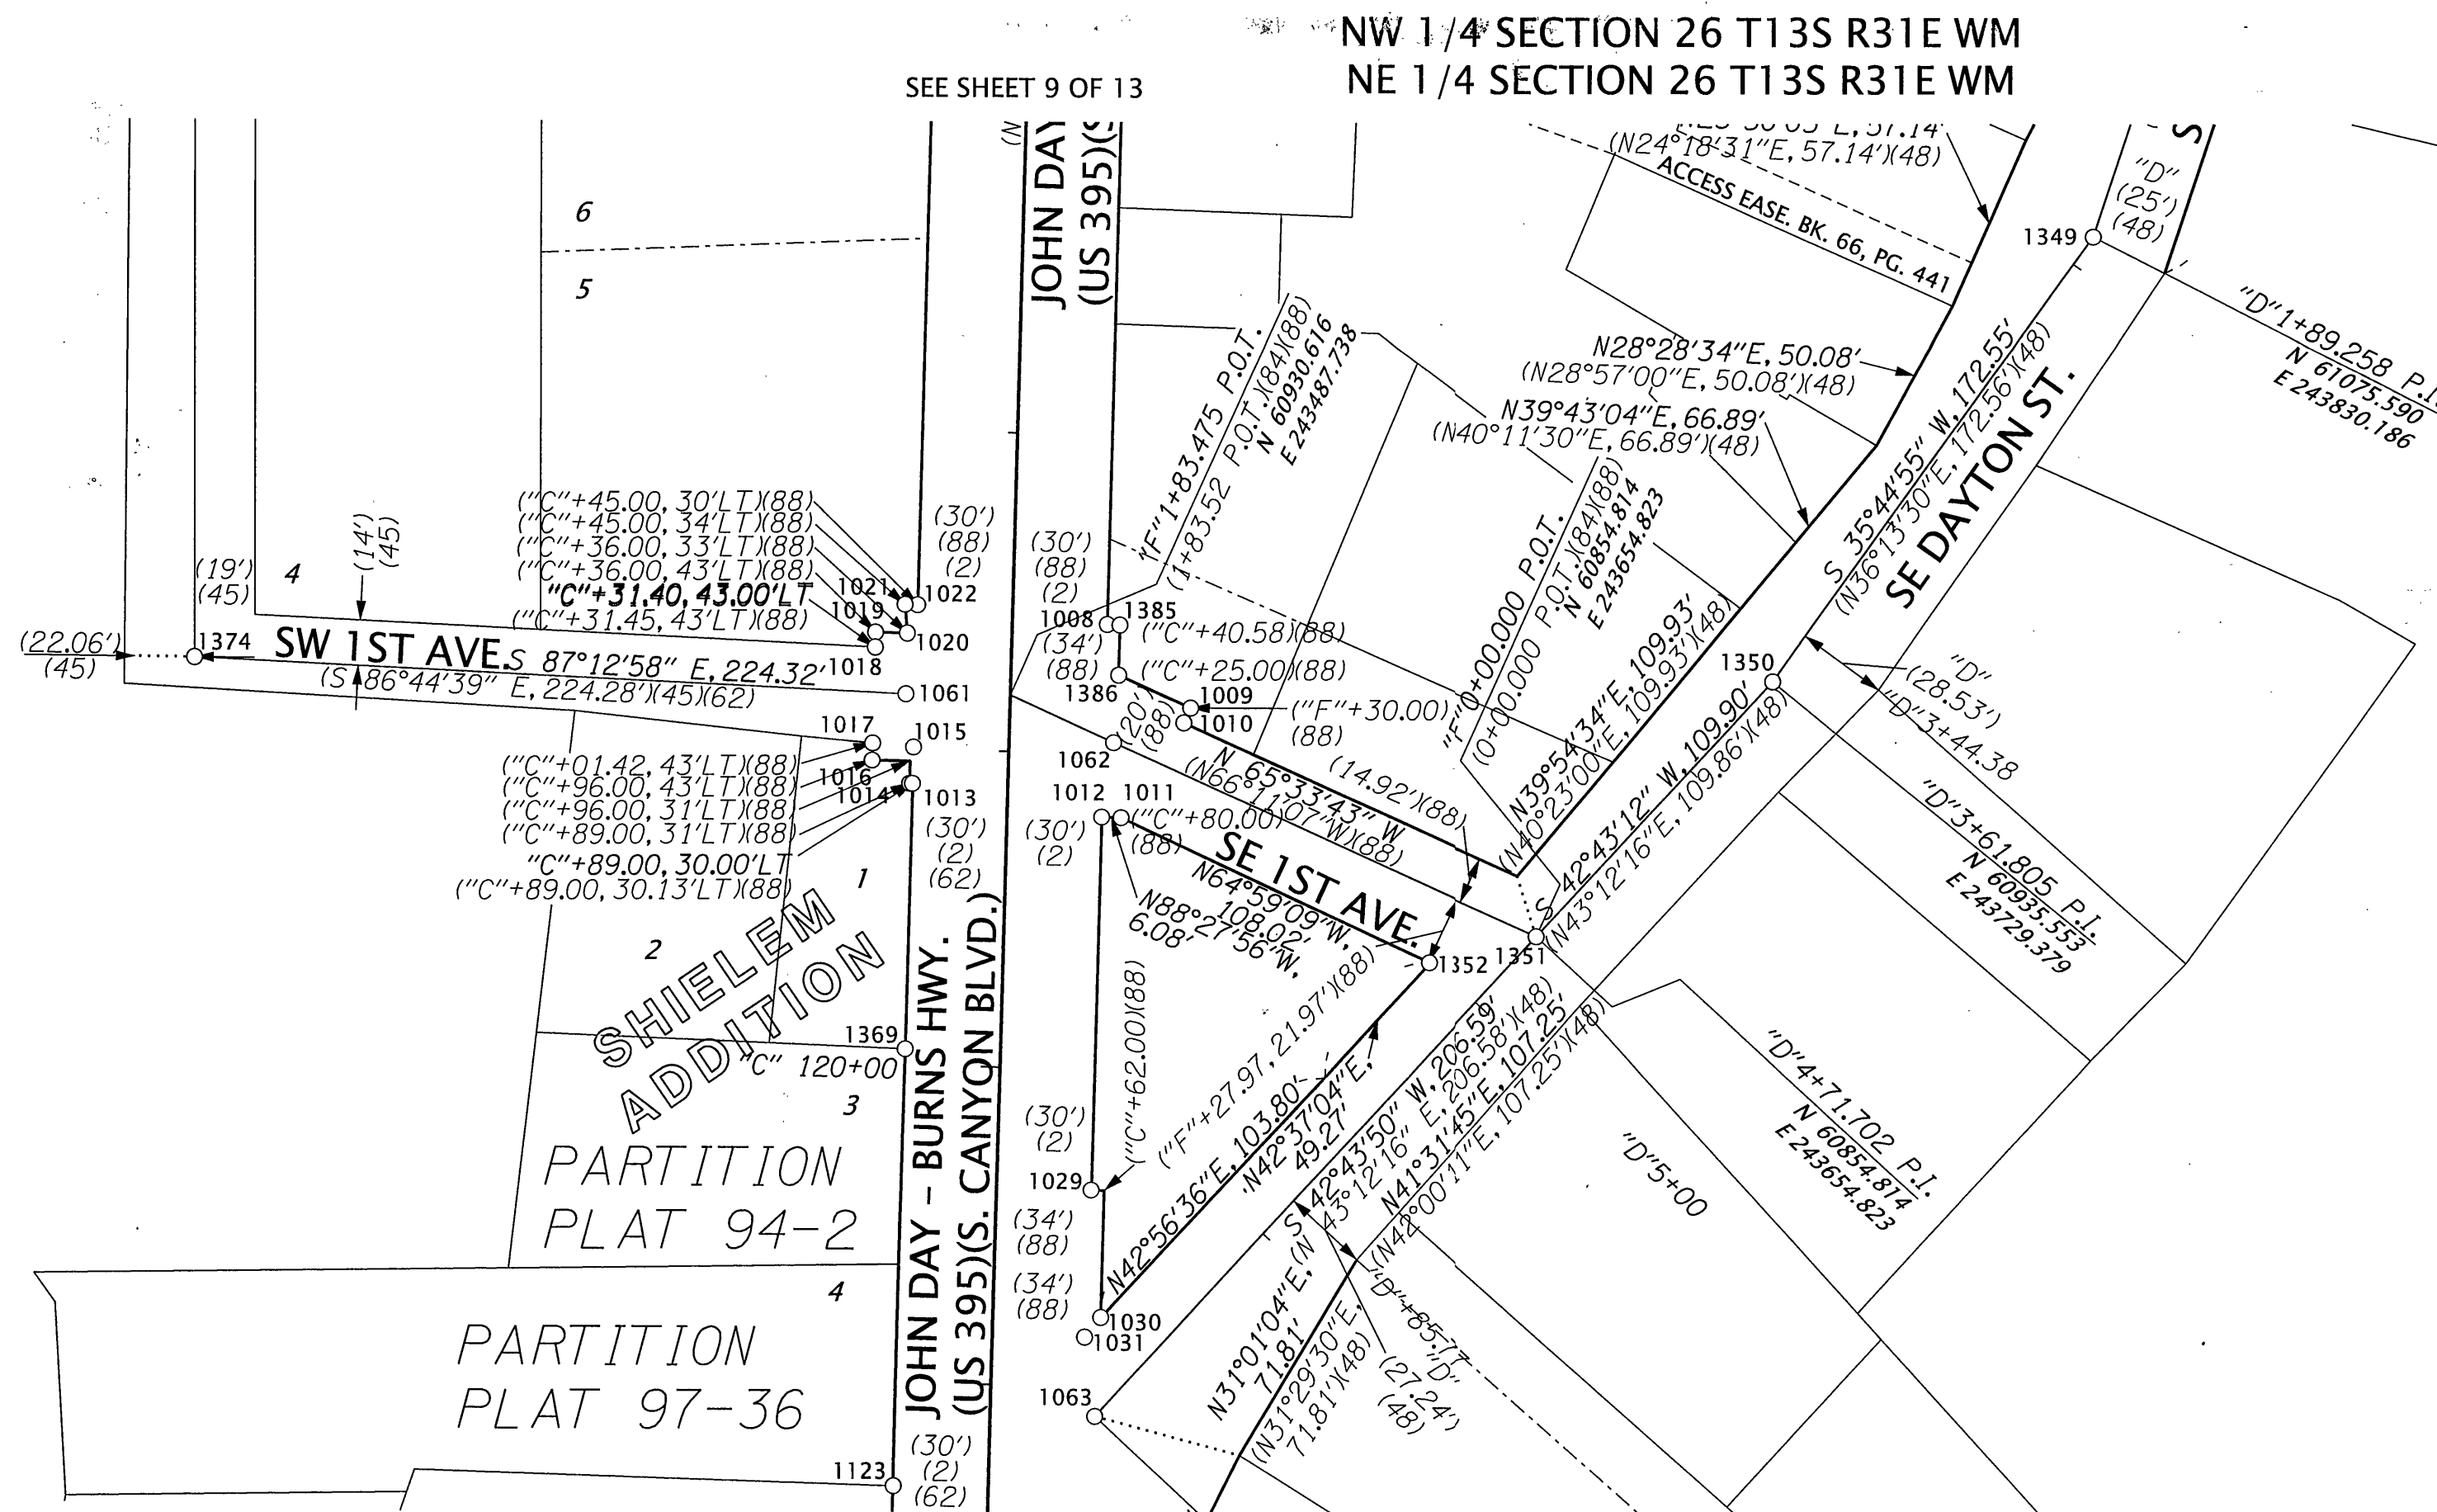


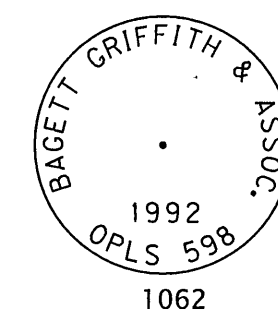

RECOVERED MONUMENT LIST

PT ID	NORTHING	EASTING	STATION	OFFSET	DATE	DESCRIPTION & REFERENCE DOCUMENTS
1008	60952.65	243518.34	"C"121+40.60	30.01' RT	7/29/2020	FD 1-1/8" COPPER DISK FLUSH IN SIDEWALK MARKED "ODOT", MOS#2035
1009	60926.76	243544.76	"F"1+29.96	20.04' RT	7/29/2020	FD 5/8" IRON ROD WITH 1-1/2" ALUMINUM CAP MARKED "ODOT", FLUSH, MOS#2035
1010	60922.13	243542.58	"F"1+30.02	14.93' RT	7/29/2020	FD 5/8" IRON ROD WITH 1-1/2" ALUMINUM CAP MARKED "ODOT", FLUSH, MOS#2035
1011	60891.93	243522.76	"C"120+80.03	36.04' RT	7/29/2020	FD 5/8" IRON ROD WITH 1-1/2" ALUMINUM CAP MARKED "ODOT", FLUSH, MOS#2035
1012	60892.07	243516.61	"C"120+80.00	29.89' RT	7/29/2020	FD 1-1/8" COPPER DISK FLUSH IN SIDEWALK MARKED "ODOT", MOS#2035
1013	60902.67	243456.86	"C"120+88.99	30.12' LT	7/29/2020	FD 5/8" IRON ROD WITH 1-1/2" ALUMINUM CAP MARKED "ODOT", FLUSH, MOS#2035
1014	60902.68	243455.97	"C"120+88.98	31.00' LT	7/29/2020	FD 5/8" IRON ROD WITH 1-1/2" ALUMINUM CAP MARKED "ODOT", FLUSH, MOS#2035
1015	60914.22	243457.19	"C"121+00.55	30.10' LT	7/29/2020	FD 5/8" IRON ROD WITH 1-1/2" ALUMINUM CAP MARKED "ODOT", FLUSH, MOS#2035
1016	60910.02	243444.16	"C"120+96.00	43.02' LT	7/29/2020	FD 5/8" IRON ROD WITH 1-1/2" ALUMINUM CAP MARKED "ODOT", FLUSH, MOS#2035
1017	60915.44	243444.33	"C"121+01.42	42.99' LT	7/29/2020	FD 5/8" IRON ROD WITH 1-1/2" ALUMINUM CAP MARKED "ODOT", FLUSH, MOS#2035
1018	60945.43	243445.10	"C"121+31.43	43.02' LT	7/29/2020	FD 5/8" IRON ROD WITH 1-1/2" ALUMINUM CAP MARKED "ODOT", FLUSH, MOS#2035
1019	60949.99	243445.21	"C"121+35.99	43.03' LT	7/29/2020	FD 5/8" IRON ROD WITH 1-1/2" ALUMINUM CAP MARKED "ODOT", FLUSH, MOS#2035
1020	60949.74	243455.22	"C"121+36.00	33.02' LT	7/29/2020	FD 5/8" IRON ROD WITH 1-1/2" ALUMINUM CAP MARKED "ODOT", FLUSH, MOS#2035
1021	60958.73	243454.48	"C"121+44.98	34.00' LT	7/29/2020	FD 5/8" IRON ROD WITH 1-1/2" ALUMINUM CAP MARKED "ODOT", FLUSH, MOS#2035
1022	60958.64	243458.46	"C"121+44.99	30.02' LT	7/29/2020	FD 5/8" IRON ROD WITH 1-1/2" ALUMINUM CAP MARKED "ODOT", FLUSH, MOS#2035
1029	60774.14	243513.42	"C"119+62.03	29.86' RT	7/29/2020	FD 1-1/8" COPPER DISK FLUSH IN SIDEWALK MARKED "ODOT", MOS#2035
1030	60734.14	243516.50	"C"119+22.12	34.01' RT	7/29/2020	FD 1-1/8" COPPER DISK FLUSH IN SIDEWALK MARKED "ODOT", MOS#2035
1031	60728.00	243511.42	"C"119+15.85	29.10' RT	7/29/2020	FD 5/8" IRON ROD WITH 1-1/2" ALUMINUM CAP MARKED "ODOT", FLUSH, MOS#2035
1061	60930.91	243454.77	"C"121+17.17	32.97' LT	7/30/2020	FD 2-1/2" BRASS DISK IN MON. BOX MARKED AS SHOWN, DOWN 1.0', MOS#1129
1062	60915.81	243520.38	"F"1+47.63	0.00' RT	7/30/2020	FD 2-1/2" BRASS DISK IN MON. BOX MARKED AS SHOWN, DOWN 1.0', MOS#1211
1063	60703.06	243514.64	"C"118+91.01	32.99' RT	7/30/2020	FD 5/8" IRON ROD WITH YPC MARKED "APA", DOWN 1.1' IN MON. BOX, MOS#1801
1123	60681.11	243451.16	"C"118+67.36	29.88' LT	7/19/2020	FD 1-1/2" BRASS DISK IN SIDEWALK MARKED "FS&E 2015", MOS#2032
1349	61075.59	243830.19	"D"1+89.26	0.00' RT	10/20/2020	FD 5/8" IRON ROD WITH YPC MARKED "APA", DOWN 1.1' IN MON. BOX, MOS#1801
1350	60935.55	243729.38	"D"3+61.81	0.00' RT	10/20/2020	FD 5/8" IRON ROD WITH YPC MARKED "APA", DOWN 1.3' IN MON. BOX, MOS#1801
1351	60854.81	243654.82	"D"4+71.70	0.00' RT	10/20/2020	FD 5/8" IRON ROD WITH YPC MARKED "APA", DOWN 1.1' IN MON. BOX, MOS#1801
1352	60846.36	243620.25	"F"0+27.99	21.99' LT	10/20/2020	FD 5/8" IRON ROD WITH 1-1/2" ALUMINUM CAP MARKED "ODOT", FLUSH, MOS#2035
1369	60818.58	243454.72	"C"120+04.88	30.01' LT	10/20/2020	FD 1-1/2" BRASS DISK IN SIDEWALK MARKED "FS&E 2015", MOS#2032
1374	60941.81	243230.72	N/A	N/A	11/16/2020	FD 2-1/2" BRASS DISK IN MON. BOX MARKED AS SHOWN, DOWN 1.0', MOS#1129
1385	60952.52	243522.32	"C"121+40.58	33.98' RT	9/8/2021	FD 5/8" IRON ROD WITH 1-1/2" ALUMINUM CAP STAMPED "ODOT", FLUSH, MOS#2035
1386	60936.94	243521.94	"C"121+25.00	34.02' RT	9/8/2021	FD 5/8" IRON ROD WITH 1-1/2" ALUMINUM CAP STAMPED "ODOT", DOWN 0.2', MOS#2035

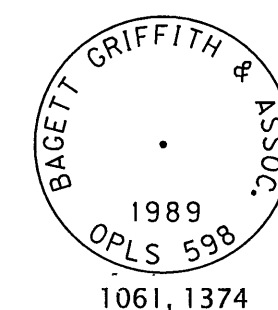

REGISTERED
PROFESSIONAL
LAND SURVEYOR

BEC

OREGON
JAN. 14, 2003
BRET N. ELITHORP
63148

EXPIRES: 12-31-2021

LEGEND
() RECORD DATA PER REFERENCE LIST ON SHEET 2
○ FOUND MONUMENT
— RESOLVED RIGHT OF WAY
— EXISTING RIGHT OF WAY OR PROPERTY LINE
--- EXISTING EASEMENT
--- SUBDIVISION LOT LINE
..... REFERENCE LINE

OREGON DEPARTMENT OF TRANSPORTATION

HORIZONTAL CONTROL, RECOVERY AND RETRACEMENT MAP

JOHN DAY HIGHWAY (US26) : NW JOHNSON DR. TO SE GUNTHER ST.

JOHN DAY - BURNS HWY. (US395): MAIN ST. TO SW. SECOND AVE.

GRANT COUNTY, OREGON



ODOT REGION 5 TECH CENTER
3012 ISLAND AVENUE
LA GRANDE, OR 97850
KEY NO. 21494

OCTOBER 14, 2021
SCALE: 1"=50'
SHEET 12 OF 13

MAP OF SURVEY NO. 2168