
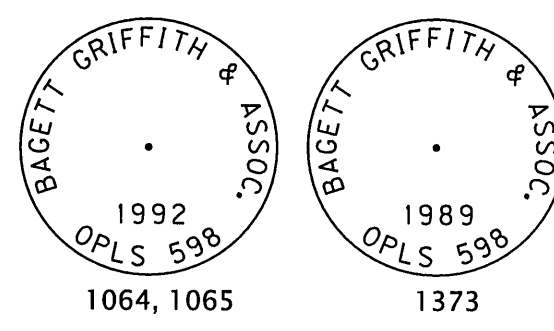


NW 1/4 SECTION 26 T13S R31E WM

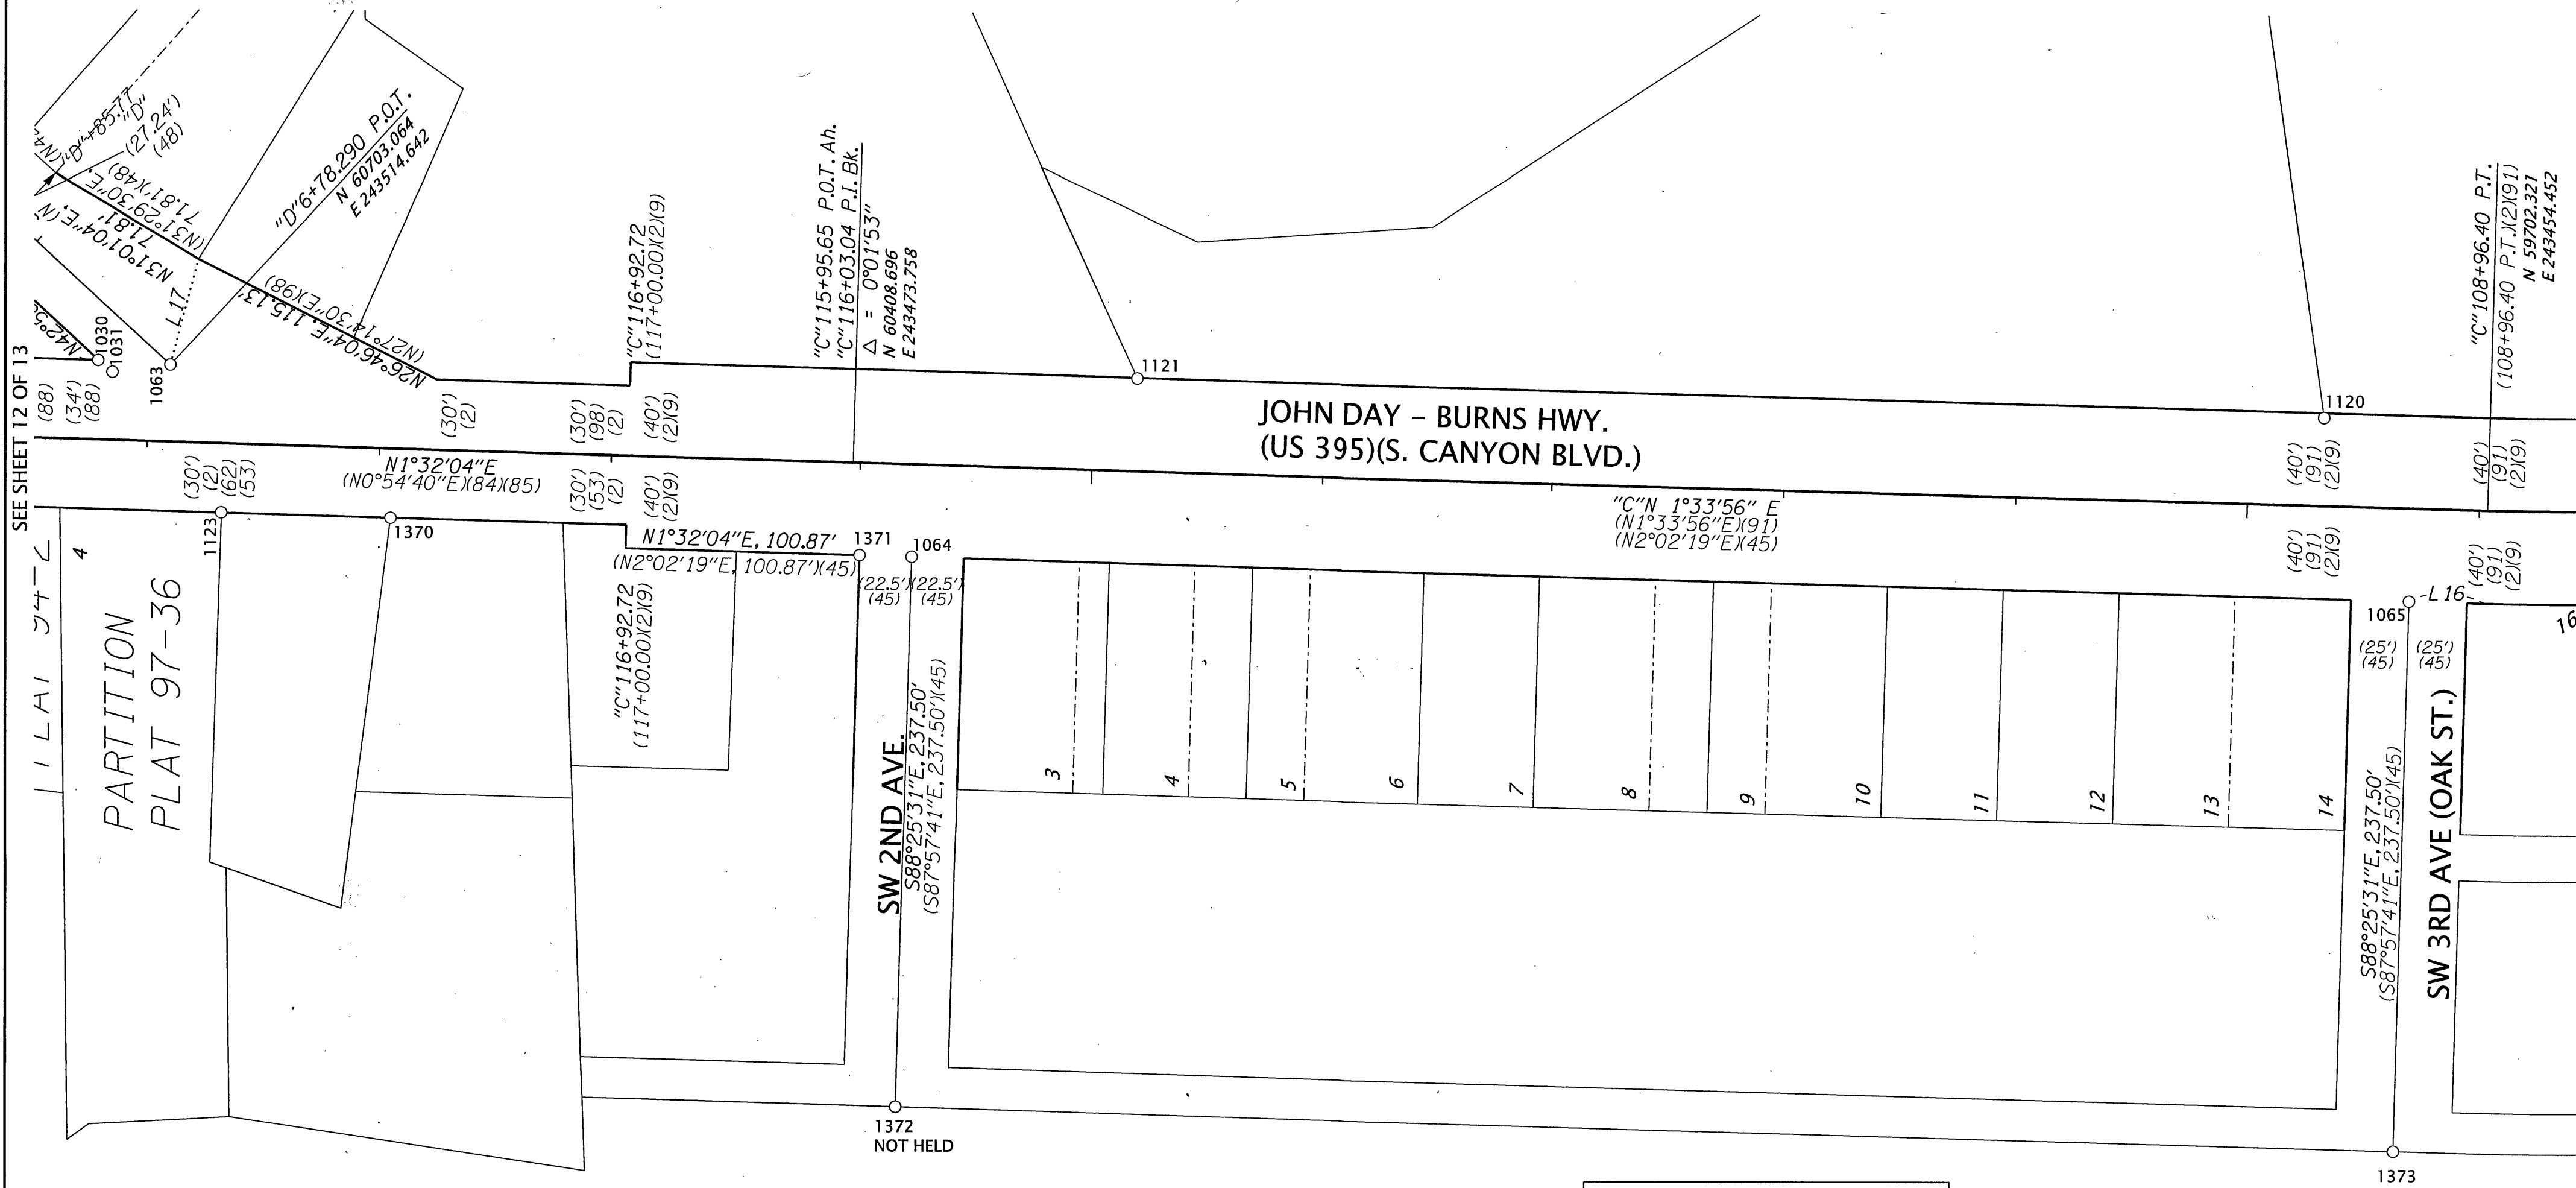

LINE TABLE				
	MEASURED		RECORD	
L16	N1°33'56\"E	32.80'	(S2°02'19\"W)(45)	(32.73'X45)
L17	S75°14'00\"E	47.35'	(S74°45'34\"E)(48)	(47.35'X48)

LEGEND

()

RECORD DATA PER REFERENCE LIST ON SHEET 2

○

FOUND MONUMENT


—

RESOLVED RIGHT OF WAY

—

EXISTING RIGHT OF WAY OR PROPERTY LINE

SUBDIVISION LOT LINE

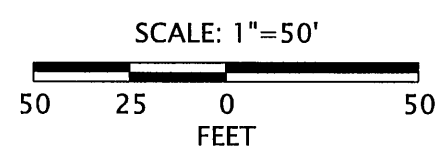

RECOVERED MONUMENT LIST

PT ID	NORTHING	EASTING	STATION	OFFSET	DATE	DESCRIPTION & REFERENCE DOCUMENTS
1030	60734.14	243516.50	"C"119+22.12	34.01' RT	7/29/2020	FD 1-1/8" COPPER DISK FLUSH IN SIDEWALK MARKED "ODOT", MOS*2035
1031	60728.00	243511.42	"C"119+15.85	29.10' RT	7/29/2020	FD 5/8" IRON ROD WITH 1-1/2" ALUMINUM CAP MARKED "ODOT", FLUSH, MOS*2035
1063	60703.06	243514.64	"C"118+91.01	32.99' RT	7/30/2020	FD 5/8" IRON ROD WITH YPC MARKED "APA", DOWN 1.1' IN MON. BOX, MOS*1801
1064	60383.48	243433.08	"C"115+76.72	39.97' LT	7/30/2020	FD 2-1/2" BRASS DISK IN MON. BOX MARKED AS SHOWN, DOWN 1.1', MOS*1211
1065	59736.20	243415.35	"C"109+29.20	40.02' LT	7/30/2020	FD 2-1/2" BRASS DISK IN MON. BOX MARKED AS SHOWN, DOWN 1.0', MOS*1211
1120	59772.83	243494.39	"C"109+67.98	38.00' RT	8/19/2020	FD 5/8" IRON ROD, NO CAP, DOWN 0.2', MOS*508
1121	60285.96	243510.18	"C"114+81.35	39.76' RT	8/19/2020	FD 5/8" IRON ROD WITH YPC MARKED "BENCHMARK SURVEYING", UP 0.3', MOS*2011
1123	60681.11	243451.16	"C"118+67.36	29.88' LT	8/19/2020	FD 1-1/2" BRASS DISK IN SIDEWALK MARKED "FS&E 2015", MOS*2032
1370	60608.17	243449.08	"C"117+94.40	30.01' LT	10/20/2020	FD 5/8" IRON ROD, NO CAP, UP 0.3', MOS*803
1371	60405.95	243433.70	"C"115+99.20	39.97' LT	10/20/2020	FD MAG NAIL FLUSH WITH SIDEWALK, MOS*1600
1372	60389.96	243195.70	N/A	N/A	10/20/2020	FD WOODEN STAKE SET IN PAVEMENT, UNKNOWN ORIGIN
1373	59742.73	243177.93	N/A	N/A	10/20/2020	FD 2-1/2" BRASS DISK MARKED AS SHOWN, DOWN 1.2' IN MON. BOX, MOS*1129

REGISTERED PROFESSIONAL LAND SURVEYOR

OREGON
JAN. 14, 2003
BRET N. ELITHORP
63148

EXPIRES: 12-31-2021

OREGON DEPARTMENT OF TRANSPORTATION

HORIZONTAL CONTROL, RECOVERY AND RETRACEMENT MAP
JOHN DAY HIGHWAY (US26) : NW JOHNSON DR. TO SE GUNTHER ST.
JOHN DAY - BURNS HWY. (US395): MAIN ST. TO SW. SECOND AVE.
GRANT COUNTY, OREGON

ODOT REGION 5 TECH CENTER
3012 ISLAND AVENUE
LA GRANDE, OR 97850
KEY NO. 21494

OCTOBER 14, 2021
SCALE: 1\"=50'
SHEET 13 OF 13