


NE 1/4 SECTION 9 T10S R30E WM SE 1/4 SECTION 9 T10S R30E WM

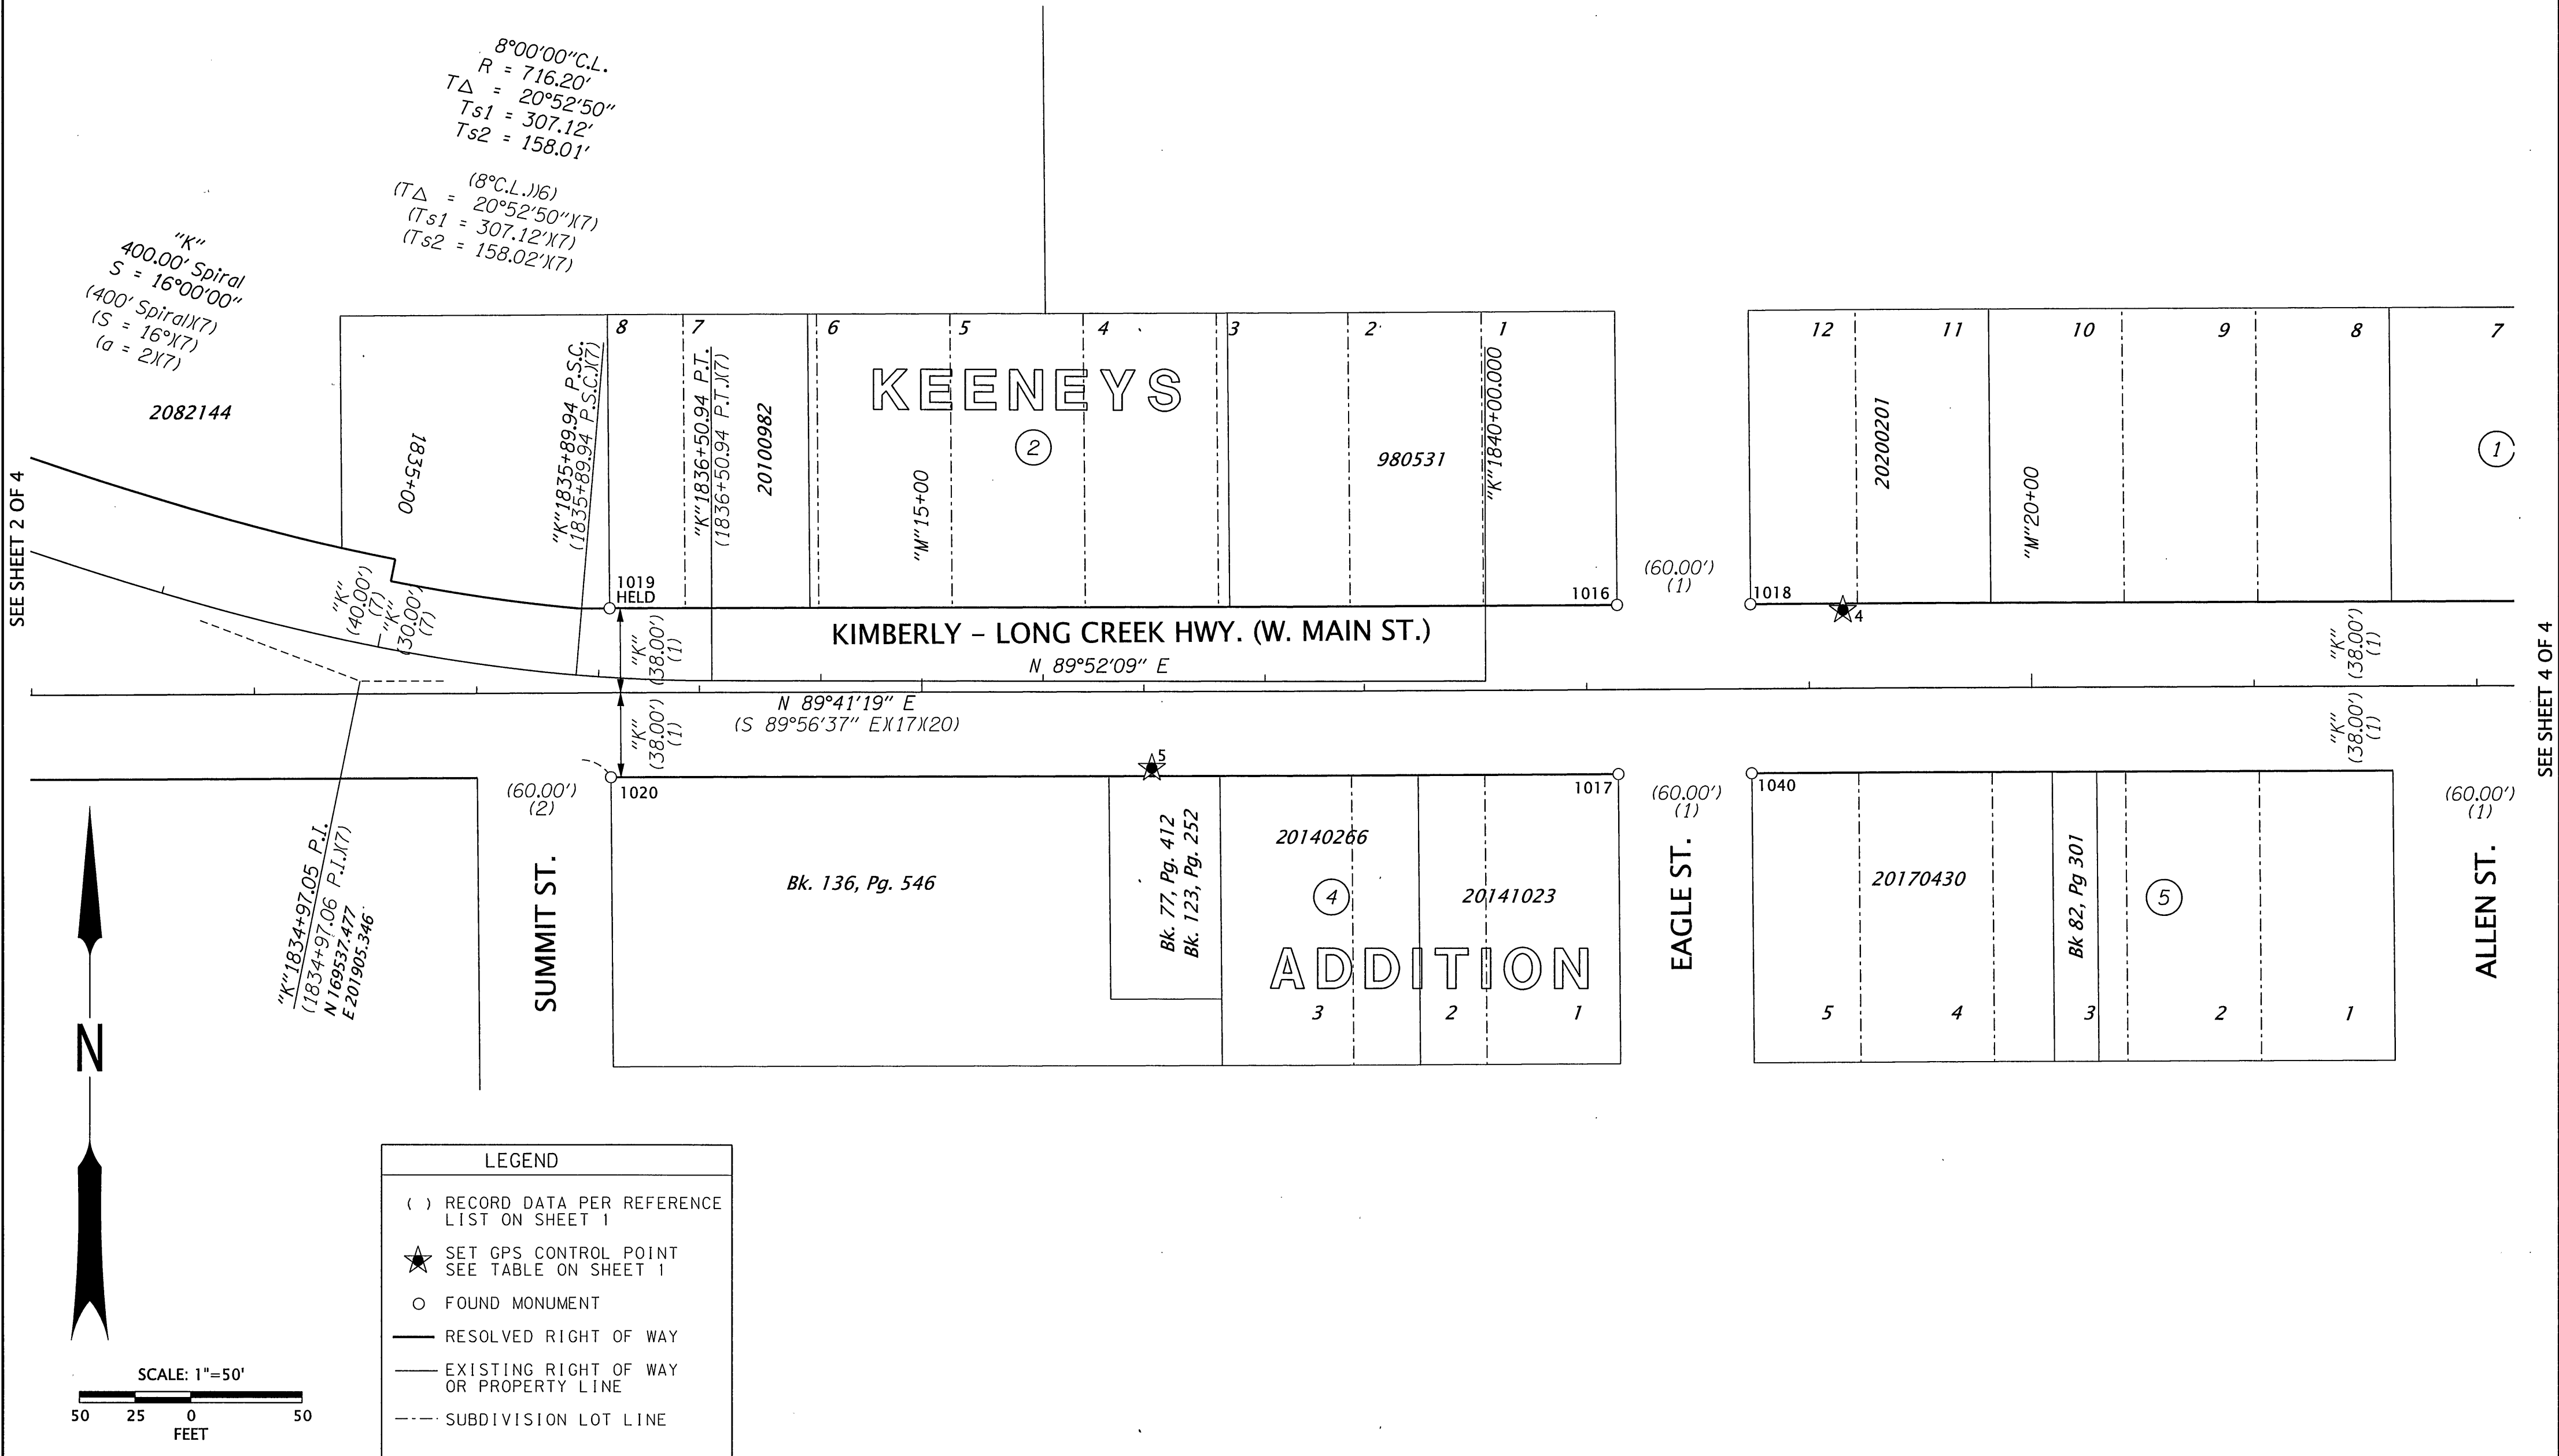

RECOVERED MONUMENT LIST

PT ID	NORTHING	EASTING	STATION	OFFSET	DATE	DESCRIPTION & REFERENCE DOCUMENTS
1016	169572.84	202471.46	"M"18+13.83	38.04' LT	8/6/2020	FD 5/8" IRON ROD WITH YPC MARKED "BGB SURVEY MARKER", FLUSH, MOS*1716
1017	169496.80	202472.13	"M"18+14.09	38.00' RT	8/6/2020	FD 5/8" IRON ROD WITH YPC MARKED "BGB SURVEY MARKER", FLUSH, MOS*1716
1018	169573.13	202531.37	"M"18+73.74	38.01' LT	8/6/2020	FD PK NAIL IN SIDEWALK, FLUSH, MOS*1716
1019	169570.33	202017.46	"M"13+59.82	38.00' LT	8/6/2020	FD PK NAIL IN SIDEWALK, FLUSH, MOS*1724
1020	169494.35	202018.08	"M"13+60.03	37.99' RT	8/6/2020	FD 5/8" IRON ROD WITH YPC MARKED "BGB SURVEY MARKER", FLUSH, MOS*1724
1040	169497.12	202532.00	"M"18+73.96	38.01' RT	10/27/2020	FD PK NAIL, MOS*1716

FD = FOUND
MOS = MAP OF SURVEY
YPC = YELLOW PLASTIC CAP

REGISTERED
PROFESSIONAL
LAND SURVEYOR

Bret N. Elithorp
OREGON
JAN. 14, 2003
BRET N. ELITHORP
63148

EXPIRES: 12-31-2021

OREGON DEPARTMENT OF TRANSPORTATION

HORIZONTAL CONTROL, RECOVERY AND RETRACEMENT MAP
KIMBERLY - LONG CREEK HWY. (402) : SUMMIT ST. TO US HWY. 395
GRANT COUNTY, OREGON



ODOT REGION 5 TECH CENTER
3012 ISLAND AVENUE
LA GRANDE, OR 97850
KEY NO. 21494

OCTOBER 14, 2021
SCALE: 1"=50'
SHEET 3 OF 4