


SE 1/4 SECTION 3 T13S R33E WM SW 1/4 SECTION 2 T13S R33E WM
NW 1/4 SECTION 11 T13S R33E WM

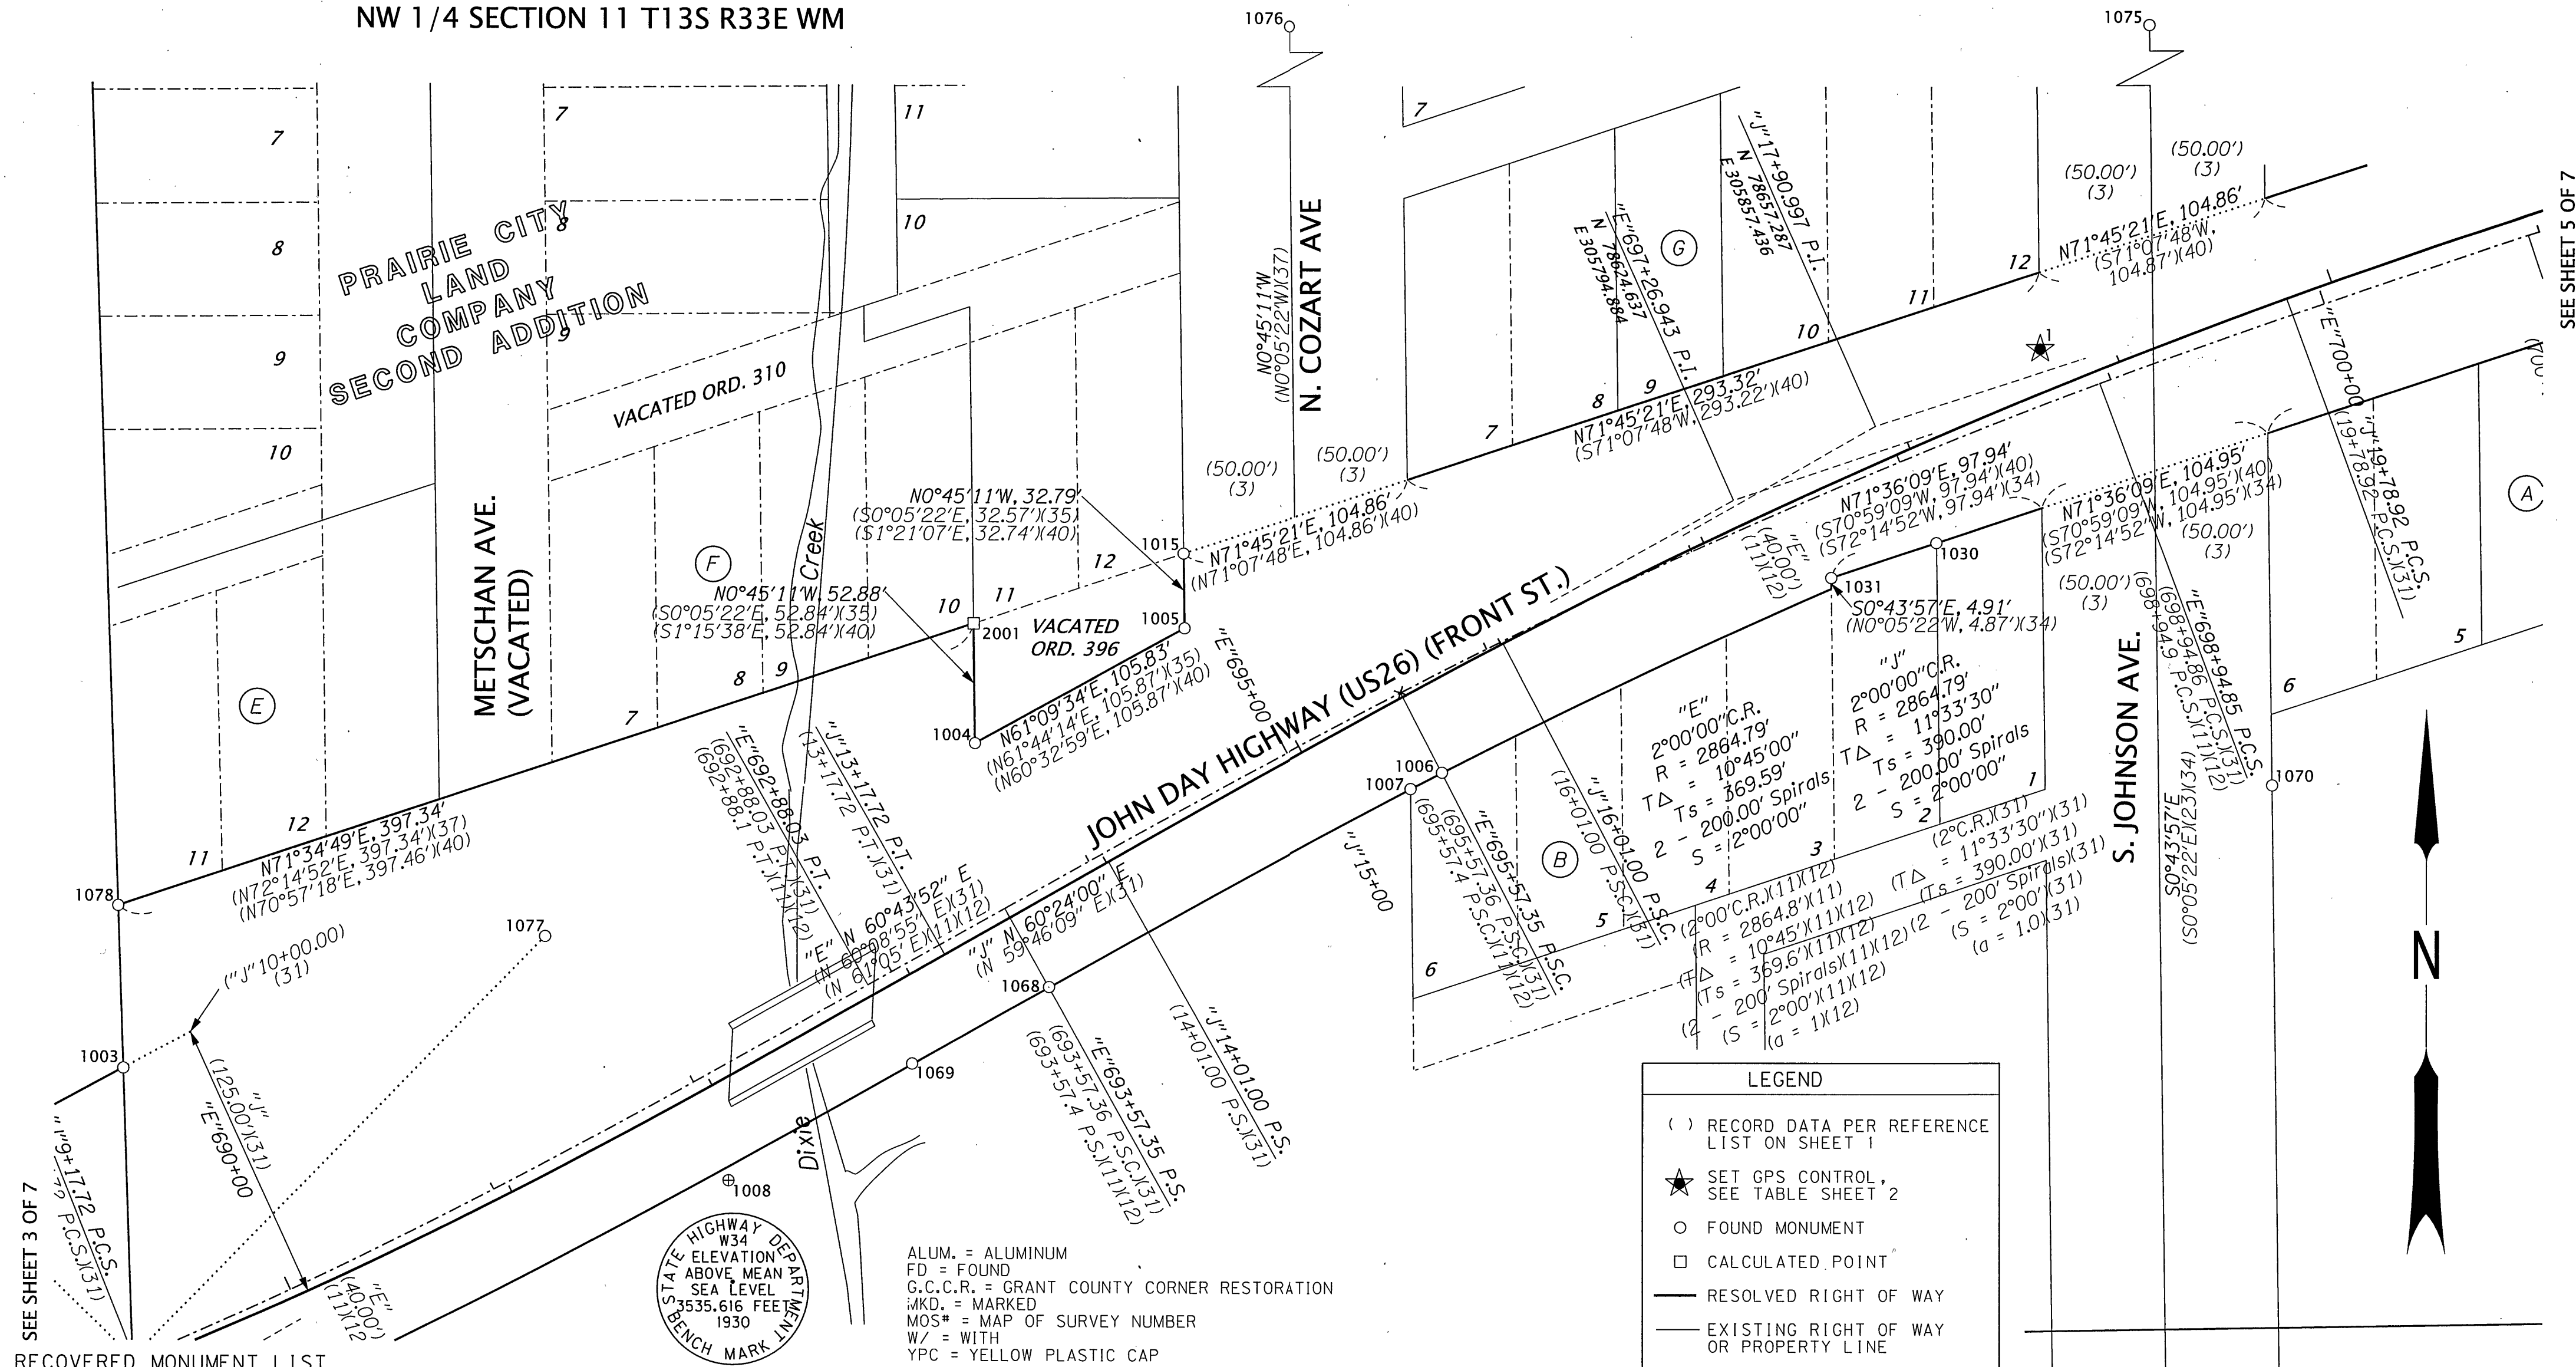

RECOVERED MONUMENT LIST

PT ID	NORTHING	EASTING	STATION	OFFSET	DATE	DESCRIPTION & REFERENCE DOCUMENTS
1003	78372.65	305083.79	"J"9+63.94	122.51' LT	8/12/2020	FD 5/8" IRON ROD W/ 2" ALUM. CAP MKD. "SHRW 9+63.98 122.57 FT PLS 848", UP 0.3', MOS#1579
1004	78516.90	305459.20	"E"693+81.41	70.13' LT	8/12/2020	FD 5/8" IRON ROD W/ 2" ALUM. CAP MKD. "SHRW 13+75.36 74.69 FT PLS 848", FLUSH, MOS#1579
1005	78567.93	305551.88	"E"694+86.23	69.97' LT	8/12/2020	FD 5/8" IRON ROD, FLUSH, MOS#1362
1006	78504.36	305666.42	"E"695+57.49	39.81' RT	8/12/2020	FD 5/8" IRON ROD W/ YPC MARKED "BGA", DOWN 0.1', MOS#1284
1007	78497.11	305652.54	"E"695+41.62	39.86' RT	8/12/2020	FD 5/8" IRON ROD W/ YPC MARKED "BGA", DOWN 0.1', MOS#1284
1008	78324.05	305350.60	"J"11+86.30	40.07' RT	8/12/2020	FD 3" BRASS DISK IN BRIDGE WINGWALL MARKED AS SHOWN, NGS DATASHEET
1015	78600.72	305551.44	"J"14+96.19	102.21' LT	8/12/2020	FD 5/8" IRON ROD W/ YPC MARKED "BGA", DOWN 0.25', MOS#171
1030	78605.85	305884.42	"E"698+01.40	39.23' RT	8/12/2020	FD PK IN SIDEWALK, FLUSH, MOS#1284
1031	78590.35	305838.03	"E"697+51.98	35.48' RT	8/12/2020	FD 5/8" IRON ROD, DOWN 0.25', MOS#1284
1067	78195.20	305936.38	N/A	N/A	1/6/2021	FD 5/8" IRON ROD, NO CAP, DOWN 0.2', MOS#442
1068	78409.32	305492.06	"E"693+57.52	39.78' RT	1/6/2021	FD 5/8" IRON ROD, NO CAP, FLUSH, MOS#1579
1069	78375.54	305431.54	"E"692+88.20	39.65' RT	1/6/2021	FD 5/8" IRON ROD W/ 2" ALUM. CAP MKD. "SHRW 12+81.54 34.64 FT PLS 848", FLUSH, MOS#1579
1075	79151.43	305974.16	N/A	N/A	1/6/2021	FD 3" BRASS CAP IN MONUMENT BOX, MOS#491
1076	79148.33	305594.26	N/A	N/A	1/6/2021	FD 3" BRASS CAP IN MONUMENT BOX, MOS#491
1077	78431.17	305269.66	"J"11+66.38	92.73' LT	1/6/2021	FD 5/8" IRON ROD W/ 1-1/2 ALUM. CAP MKD. "BGB SURVEY MARKER RPI 1995 OPLS 598", G.C.C.R.
1078	78444.21	305081.50	"J"9+93.51	188.88' LT	1/6/2021	FD 5/8" IRON ROD WITH YPC MARKED "BGB SURVEY MARKER", MOS#1370
2001	78569.73	305458.60	"J"14+00.97	120.87' LT	N/A	CALCULATED POINT, NOTHING FOUND OR SET, SEE NARRATIVE

LEGEND
() RECORD DATA PER REFERENCE LIST ON SHEET 1
★ SET GPS CONTROL, SEE TABLE SHEET 2
○ FOUND MONUMENT
□ CALCULATED POINT
— RESOLVED RIGHT OF WAY
— EXISTING RIGHT OF WAY OR PROPERTY LINE
--- SUBDIVISION LOT LINE
..... FALSE CALL LINE
- - - "E" CENTER LINE FROM DRG. 5B-11-11 & 5B-23-5
- - - "J" CENTER LINE FROM DRG. 10B-2-33

REGISTERED PROFESSIONAL LAND SURVEYOR
BLC
OREGON
JANUARY 14, 2003
BRET N. ELITHORP
63148
EXPIRES: 12-31-2021

OREGON DEPARTMENT OF TRANSPORTATION
HORIZONTAL CONTROL, RECOVERY AND RETRACEMENT MAP
JOHN DAY HIGHWAY (US26): N. COZART AVE. TO BUCHANNAN AVE.
GRANT COUNTY, OREGON

ODOT REGION 5 TECH CENTER
3012 ISLAND AVENUE
LA GRANDE, OR 97850 KEY NO. 21494
OCTOBER 14, 2021
SCALE: 1" = 50'
SHEET 4 OF 7