


SW 1/4 SECTION 21 T13S R30E WM NW 1/4 SECTION 28 T13S R30E WM

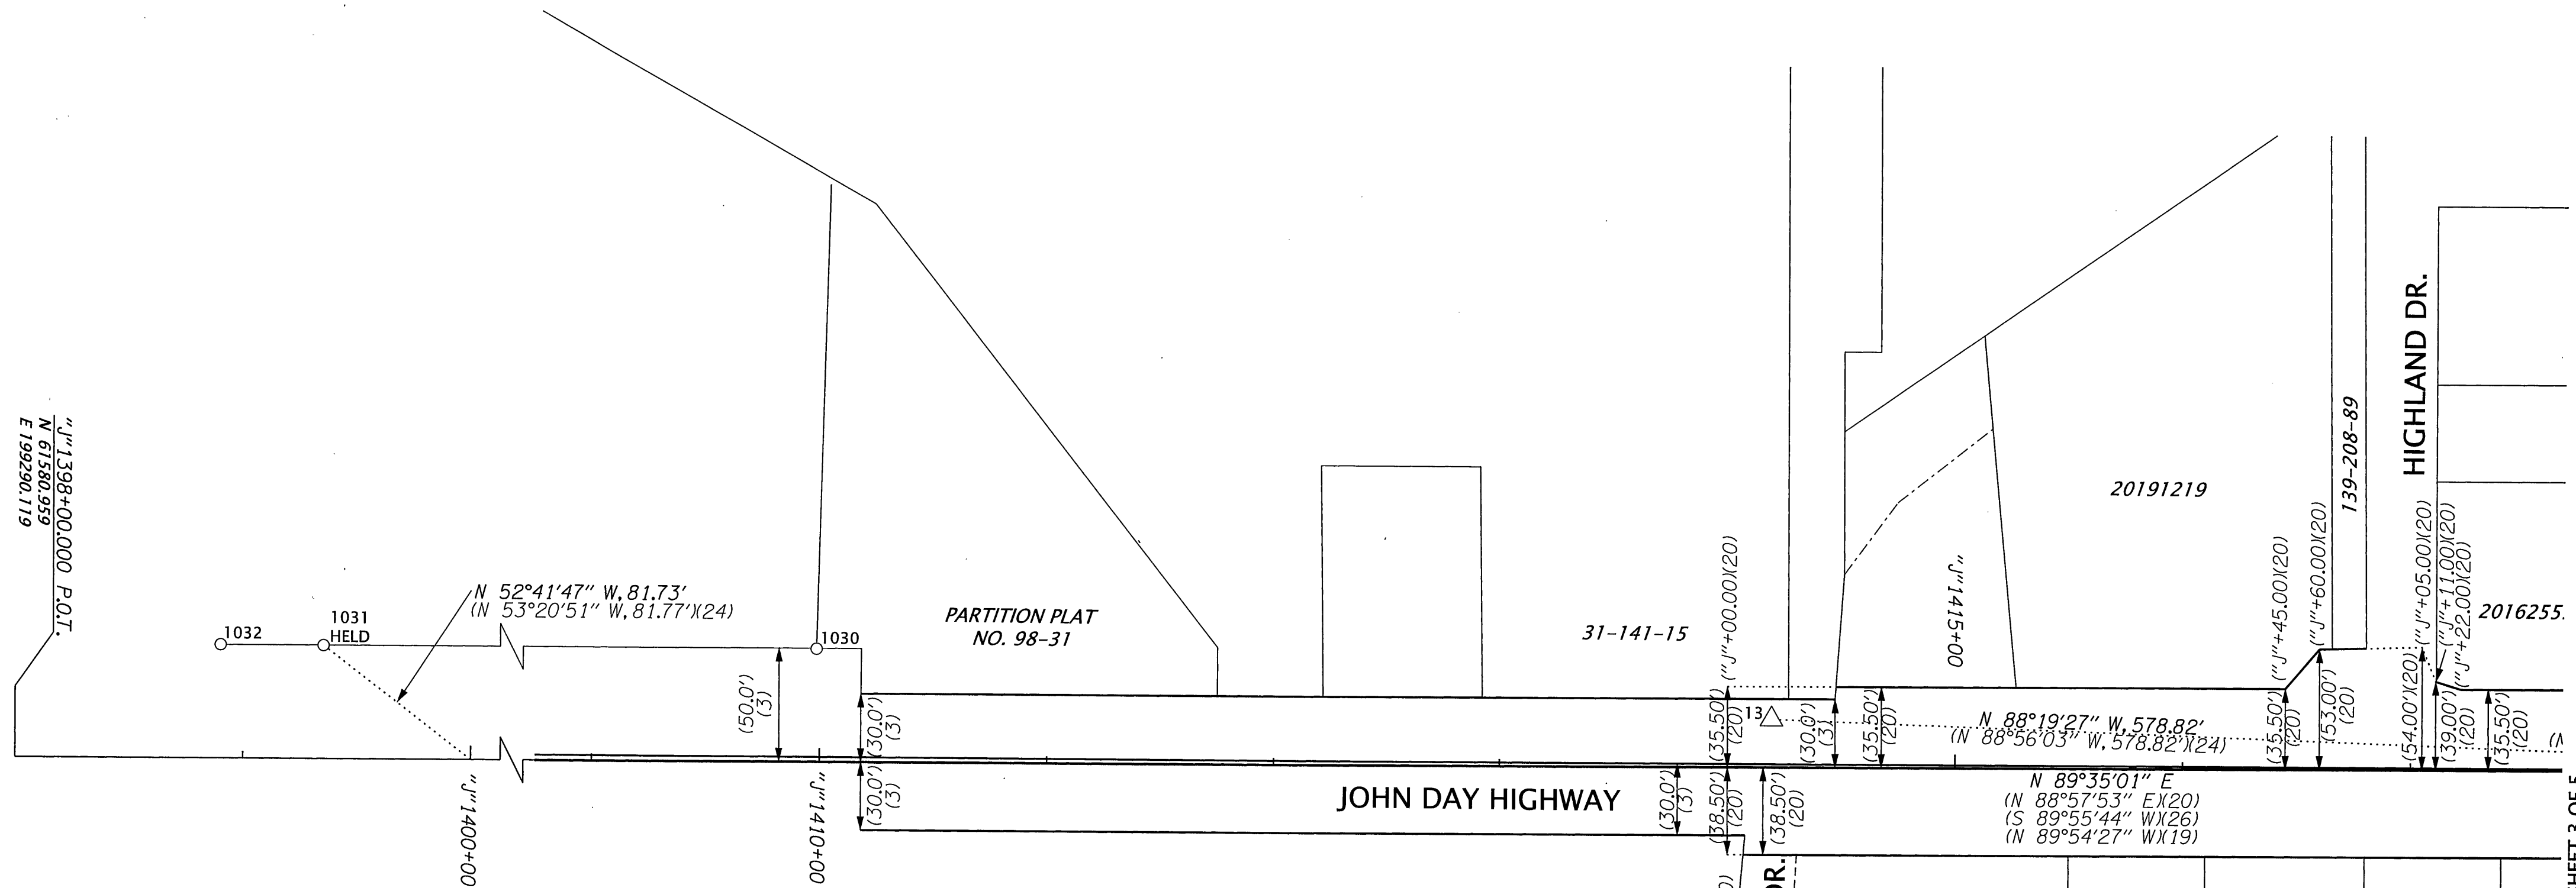

REFERENCES

1. STOCKDALE ADDITION TO MT. VERNON, FILED DEC. 5, 1916
2. OREGON STATE HIGHWAY DEPARTMENT DRG. NO. 3B-17-14, DATED MAR. 1926
3. OREGON STATE HIGHWAY DEPARTMENT DRG. NO. 7B-20-6, DATED MAR. 1953
4. OREGON STATE HIGHWAY DEPARTMENT DRG. NO. 8B-35-25, DATED APR. 1966
5. MAP OF SURVEY NO. 118 BY DUANE I. GRIFFITH, DATED AUG. 1968
6. MAP OF SURVEY NO. 185 BY ROBERT D. BAGETT, DATED JUNE 13, 1970
7. MAP OF SURVEY NO. 255 BY ROBERT D. BAGETT, FILED MAR. 16, 1972
8. MAP OF SURVEY NO. 425 BY ROBERT D. BAGETT, FILED MAR. 1, 1977
9. MAP OF SURVEY NO. 516 BY DOUGLAS M. FERGUSON, FILED JUNE 23, 1978
10. MAP OF SURVEY NO. 597 BY ROBERT D. BAGETT, FILED JAN. 9, 1980
11. MAP OF SURVEY NO. 625 BY ROBERT D. BAGETT, FILED OCT. 3, 1980
12. MAP OF SURVEY NO. 819 BY DOUGLAS M. FERGUSON, FILED JUN. 27, 1984
13. MAP OF SURVEY NO. 1147 BY ROBERT D. BAGETT, FILED JUN. 29, 1990
14. LAND PARTITION NO. 1997-06 BY JACK L. WATSON, FILED FEB. 27, 1997
15. LAND PARTITION NO. 98-31 BY ROBERT D. BAGETT, FILED AUG. 17, 1998
16. MAP OF SURVEY NO. 1492 BY ROBERT D. BAGETT, FILED OCT. 27, 1998
17. MAP OF SURVEY NO. 1526 BY ROBERT D. BAGETT, FILED OCT. 11, 1999
18. MAP OF SURVEY NO. 1564 BY JACK L. WATSON, FILED AUG. 1, 2000
19. LAND PARTITION PLAT NO. 2003-01 BY JACK L. WATSON, FILED JAN. 24, 2003
20. OREGON DEPARTMENT OF TRANSPORTATION DRG. NO. 11B-2-10, DATED FEB. 2008
21. LAND PARTITION NO. 2008-07, BY MICHAEL C. SPRINGER, FILED JUNE 27, 2008
22. LAND PARTITION NO. 2009-07, BY MICHAEL C. SPRINGER, FILED JUNE 2, 2009
23. MAP OF SURVEY NO. 1905 BY KENNETH H. DELANO JR., FILED NOV. 15, 2010
24. MAP OF SURVEY NO. 1915 BY MARK D. FILSINGER, FILED FEB. 25, 2011
25. MAP OF SURVEY NO. 1925 BY MICHAEL C. SPRINGER, FILED JUL. 9, 2011
26. MAP OF SURVEY NO. 2009 BY MICHAEL C. SPRINGER, FILED SEPT. 29, 2014
27. MAP OF SURVEY 2114 BY MICHAEL C. SPRINGER, FILED AUG. 13, 2019
28. LAND PARTITION NO. 2020-07 BY KENNETH H. DELANO JR., FILED JULY 30, 2020

RECOVERED MONUMENT LIST

PT ID	NORTHING	EASTING	STATION	OFFSET	DATE	DESCRIPTION & REFERENCE DOCUMENTS
13	61613.78	200909.29	"J"1414+19.37	21.13' LT	8/4/2020	FD 5/8" IRON ROD WITH RPC MARKED "ODOT SURVEY OPERATIONS", FLUSH, MOS*1915
1030	61639.36	200488.37	"J"1409+98.64	49.77' LT	10/19/2020	FD 5/8" IRON ROD WITH YPC MARKED "BGA SURVEY MARKER", DOWN 0.1', MOS*1492
1031	61631.86	199425.11	"J"1399+35.35	50.00' LT	10/19/2020	FD 5/8" IRON ROD, NO CAP, UP 0.2', PARTITION PLAT 98-31
1032	61631.61	199379.92	"J"1398+90.17	50.08' LT	10/19/2020	FD 5/8" IRON ROD WITH YPC MARKED "BGA SURVEY MARKER", FLUSH, PARTITION PLAT 98-31

FD = FOUND
RPC = RED PLASTIC CAP
YPC = YELLOW PLASTIC CAP

REGISTERED
PROFESSIONAL
LAND SURVEYOR

BRETT N. ELITHORP

OREGON
JAN. 14, 2003
BRET N. ELITHORP
63148

EXPIRES: 12-31-2021

OREGON DEPARTMENT OF TRANSPORTATION

HORIZONTAL CONTROL, RECOVERY AND RETRACEMENT MAP
JOHN DAY HWY. (US26) : TELEPHONE DR. TO COTTONWOOD ST.
GRANT COUNTY, OREGON



ODOT REGION 5 TECH CENTER
3012 ISLAND AVENUE
LA GRANDE, OR 97850
KEY NO. 21494

DECEMBER 7, 2021
SCALE: 1"=50'
SHEET 2 OF 5