


SW 1/4 SECTION 21 T13S R30E WM SE 1/4 SECTION 21 T13S R30E WM
NW 1/4 SECTION 28 T13S R30E WM NE 1/4 SECTION 28 T13S R30E WM

SEE SHEET 2 OF 5

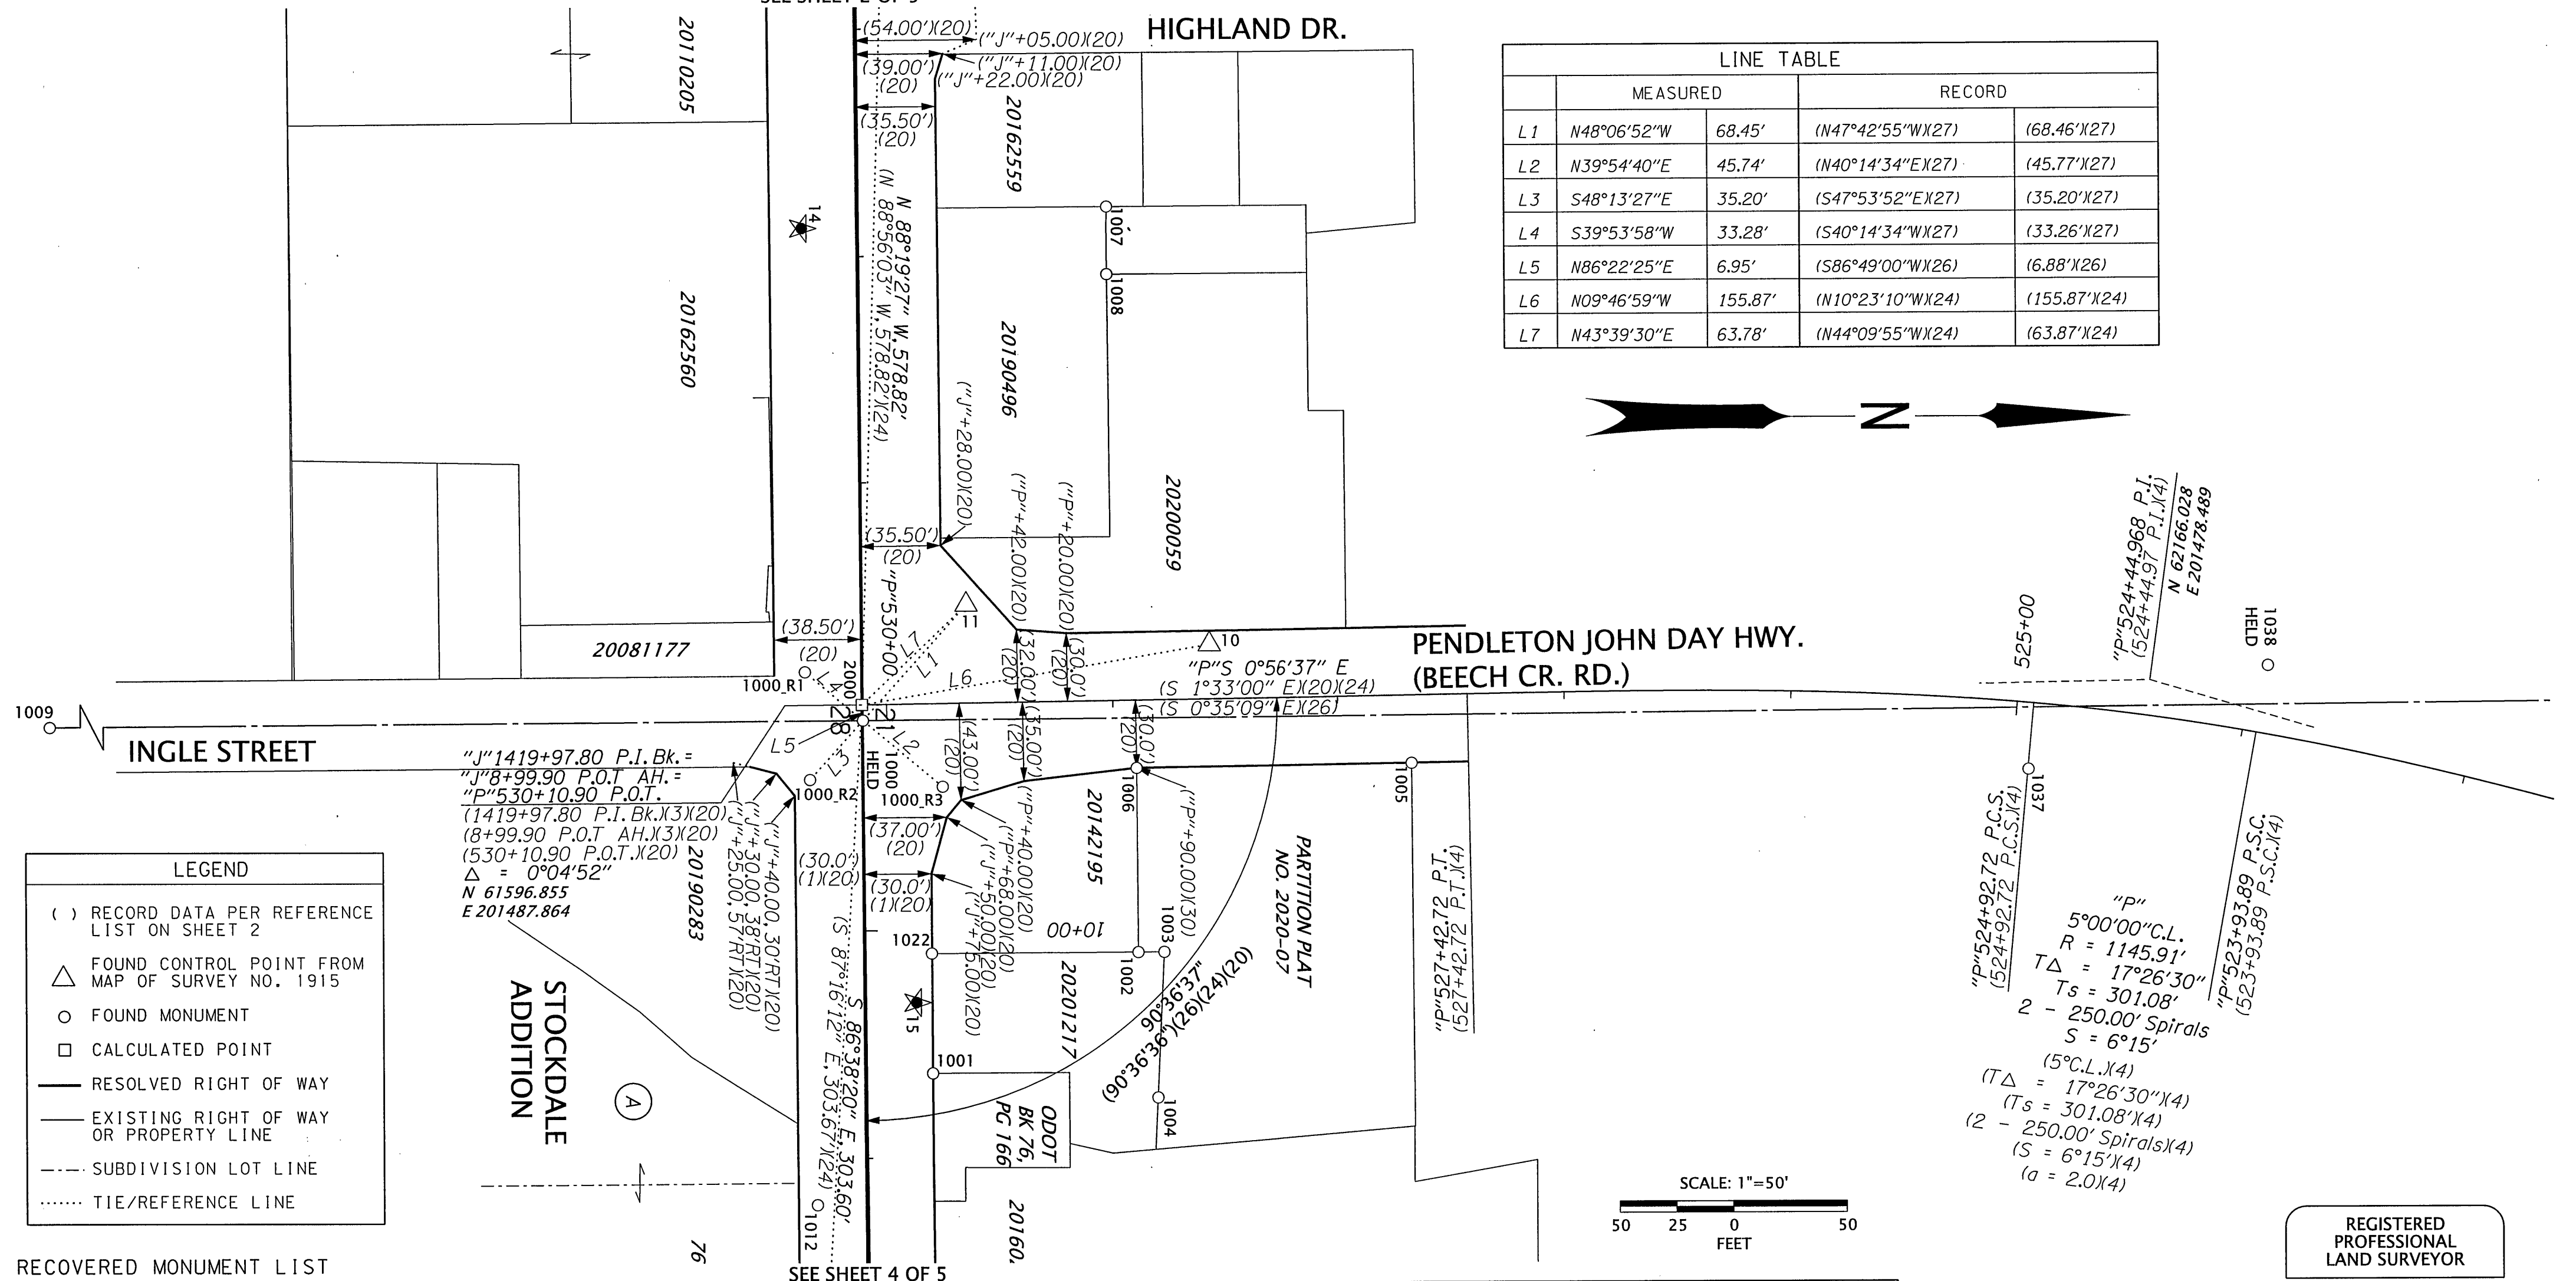

REGISTERED
PROFESSIONAL
LAND SURVEYOR

OREGON
JAN. 14, 2003
BRET N. ELITHORP
63148

EXPIRES: 12-31-2021

OREGON DEPARTMENT OF TRANSPORTATION

HORIZONTAL CONTROL, RECOVERY AND RETRACEMENT MAP
JOHN DAY HWY. (US26) : TELEPHONE DR. TO COTTONWOOD ST.
GRANT COUNTY, OREGON



ODOT REGION 5 TECH CENTER
3012 ISLAND AVENUE
LA GRANDE, OR 97850
KEY NO. 21494

DECEMBER 7, 2021
SCALE: 1"=50'
SHEET 3 OF 5

MAP OF SURVEY NO. 2176