


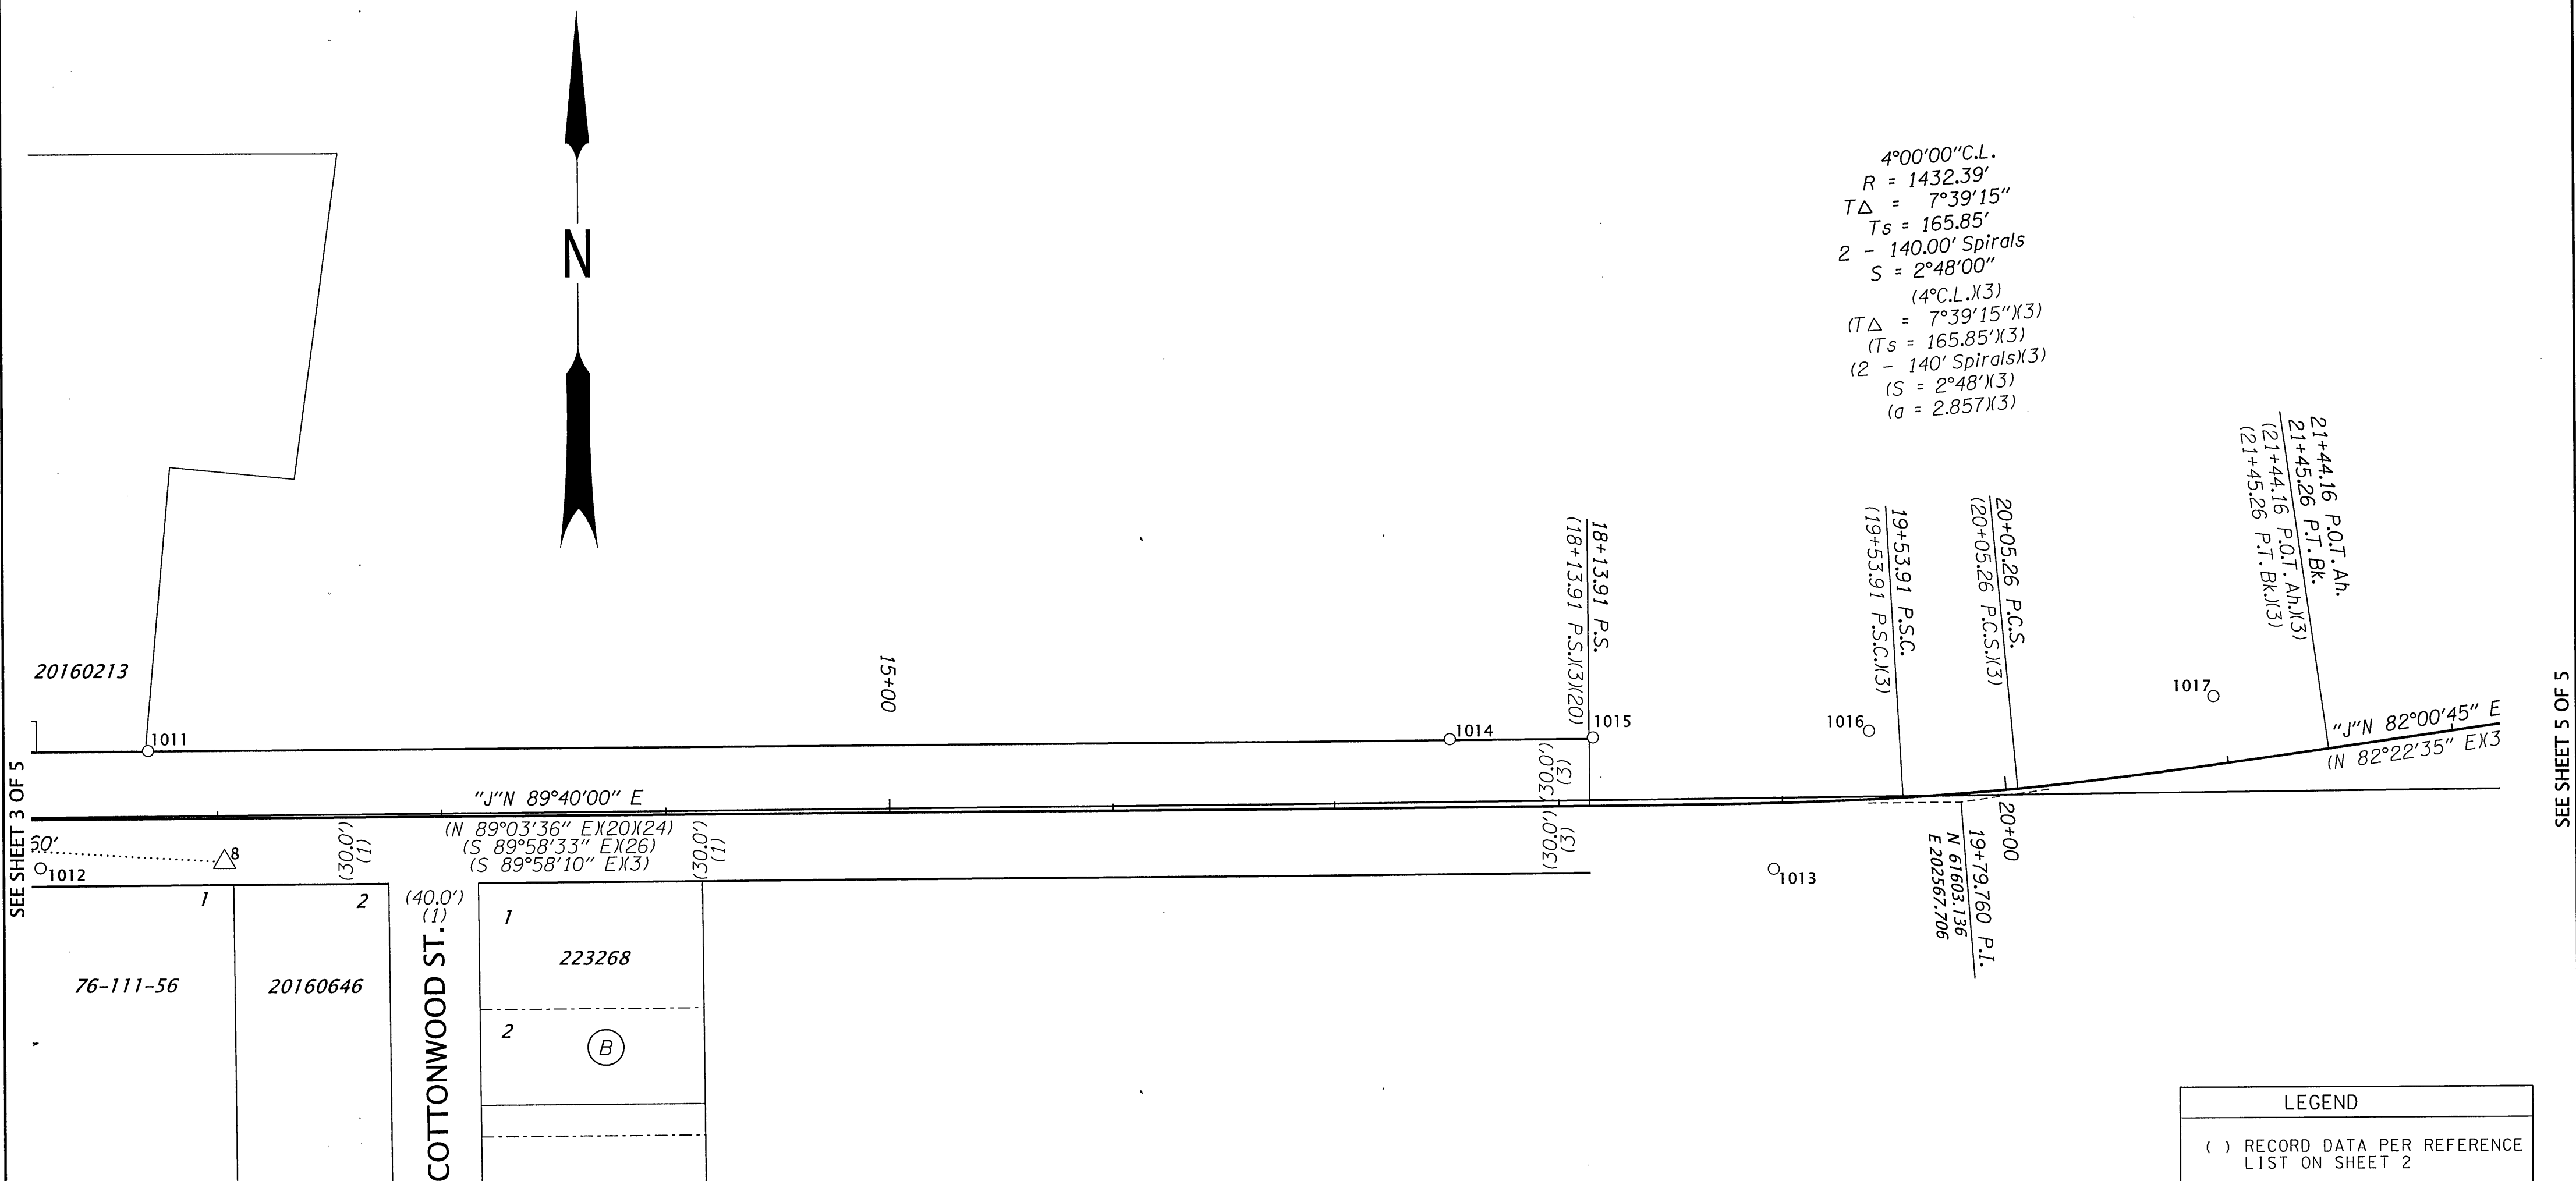


SEE SHEET 3 OF 5

SEE SHEET 5 OF 5

4°00'00" C.L.
R = 1432.39'
TΔ = 7°39'15"
Ts = 165.85'
2 - 140.00' Spirals
S = 2°48'00"
(4° C.L.)(3)
(TΔ = 7°39'15" X 3)
(Ts = 165.85' X 3)
(2 - 140' Spirals X 3)
(S = 2°48' X 3)
(a = 2.857 X 3)

LEGEND

- () RECORD DATA PER REFERENCE LIST ON SHEET 2
- △ FOUND CONTROL POINT
- FOUND MONUMENT
- RESOLVED RIGHT OF WAY
- EXISTING RIGHT OF WAY OR PROPERTY LINE
- SUBDIVISION LOT LINE
- TIE/REFERENCE LINE

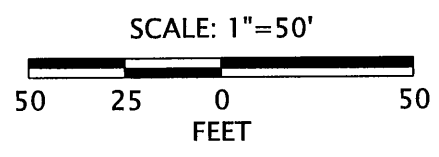

FD = FOUND
LP# = LAND PARTITION
MOS = MAP OF SURVEY
RPC = RED PLASTIC CAP
YPC = YELLOW PLASTIC CAP

RECOVERED MONUMENT LIST

PT ID	NORTHING	EASTING	STATION	OFFSET	DATE	DESCRIPTION & REFERENCE DOCUMENTS
8	61579.06	201790.94	12+02.87	19.56' RT	8/4/2020	FD 5/8" IRON ROD WITH RPC MARKED "ODOT SURVEY OPERATIONS", FLUSH, MOS#1915
1011	61628.70	201757.05	11+69.27	30.28' LT	8/4/2020	FD CHISELED "X" IN CONCRETE, MOS#425
1012	61576.48	201708.77	11+20.68	21.66' RT	8/4/2020	FD MAG NAIL WITH PINK WHISKER, ORIGIN UNKNOWN
1013	61573.61	202483.93	18+95.32	29.49' RT	8/4/2020	FD 5/8" IRON ROD WITH YPC, ILLEGIBLE, FLUSH, MOS#1905
1014	61632.28	202339.47	17+51.70	30.47' LT	8/4/2020	FD 5/8" IRON ROD WITH RPC MARKED "CORNERSTONE SURVEYING INC.", UP 0.5', LP#97-06
1015	61632.75	202403.40	18+15.63	30.57' LT	8/4/2020	FD 5/8" IRON ROD WITH RPC MARKED "CORNERSTONE SURVEYING INC.", UP 0.1', LP#97-06
1016	61635.12	202526.73	19+40.20	30.57' LT	8/4/2020	FD 5/8" IRON ROD WITH YPC MARKED "BGB SURVEY MARKER", FLUSH, LP# 2008-07
1017	61649.68	202680.58	20+97.49	30.32' LT	8/4/2020	FD 5/8" IRON ROD WITH RPC, ILLEGIBLE, DOWN 0.2', LP#97-06

REGISTERED PROFESSIONAL LAND SURVEYOR

BRE

OREGON
JAN. 14, 2003
BRET N. ELITHORP
63148

EXPIRES: 12-31-2021

OREGON DEPARTMENT OF TRANSPORTATION

HORIZONTAL CONTROL, RECOVERY AND RETRACEMENT MAP
JOHN DAY HWY. (US26) : TELEPHONE DR. TO COTTONWOOD ST.
GRANT COUNTY, OREGON

ODOT REGION 5 TECH CENTER
3012 ISLAND AVENUE
LA GRANDE, OR 97850
KEY NO. 21494

DECEMBER 7, 2021
SCALE: 1"=50'
SHEET 4 OF 5