


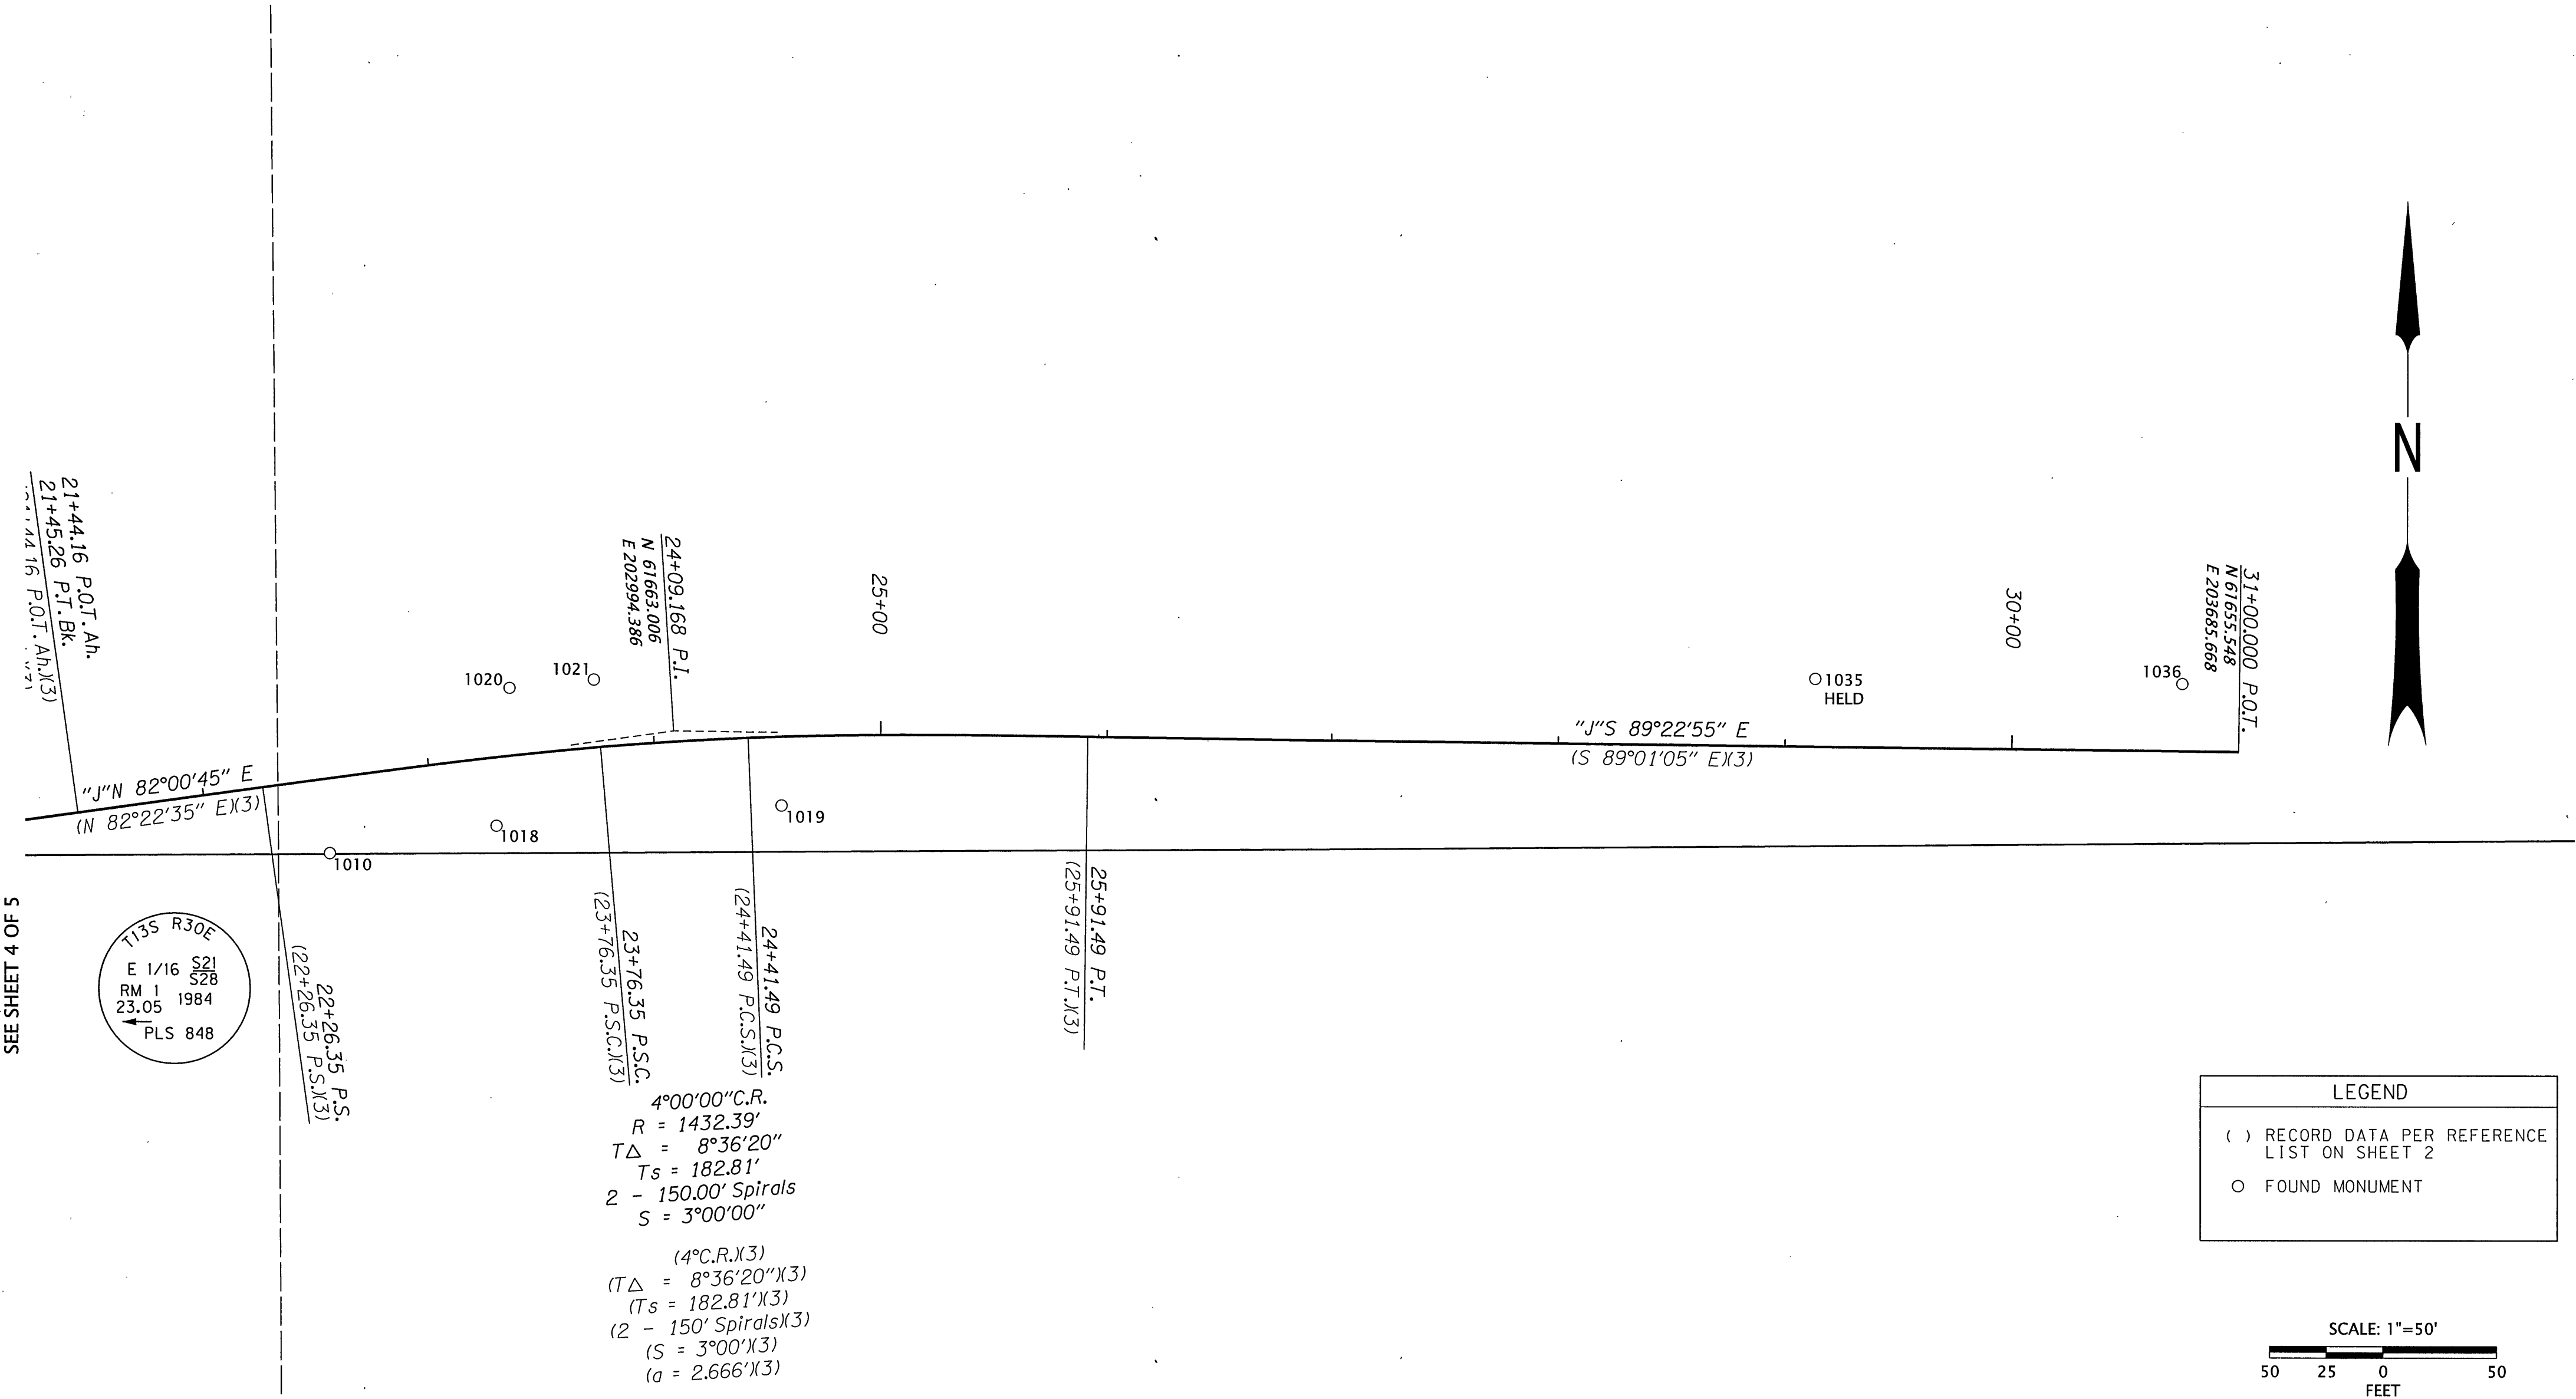

SEE SHEET 4 OF 5

RECOVERED MONUMENT LIST

PT ID	NORTHING	EASTING	STATION	OFFSET	DATE	DESCRIPTION & REFERENCE DOCUMENTS
1010	61608.74	202843.03	22+51.79	32.70' RT	8/4/2020	FD 2-1/2" BRASS DISK ON 2-1/4" IRON PIPE, UP 1.3', BENT E'LY, SHOT AT BEND, MOS#819
1018	61621.12	202916.41	23+26.84	29.87' RT	8/4/2020	FD 5/8" IRON ROD, NO CAP, DOWN 0.3', MOS#516
1019	61630.39	203041.98	24+55.29	30.17' RT	8/4/2020	FD 5/8" IRON ROD, NO CAP, DOWN 0.3', MOS#516
1020	61681.80	202922.04	23+39.27	29.79' LT	8/4/2020	FD 5/8" IRON ROD, NO CAP, DOWN 0.25', MOS#819
1021	61685.62	202959.18	23+75.93	29.92' LT	8/4/2020	FD 5/8" IRON ROD, NO CAP, DOWN 0.25', MOS#819
1035	61687.56	203498.96	29+12.96	30.00' LT	10/22/2020	FD 5/8" IRON ROD WITH YPC MARKED 'BGA SURVEY MARKER', UP 0.25', MOS#1147
1036	61685.54	203660.84	30+74.85	29.72' LT	10/22/2020	FD 5/8" IRON ROD, NO CAP, UP 0.25', MOS#819

E'LY = EASTERLY
FD = FOUND
MOS = MAP OF SURVEY
YPC = YELLOW PLASTIC CAP

REGISTERED
PROFESSIONAL
LAND SURVEYOR

OREGON
JAN. 14, 2003
BRET N. ELITHORP
63148
EXPIRES: 12-31-2021

OREGON DEPARTMENT OF TRANSPORTATION
HORIZONTAL CONTROL, RECOVERY AND RETRACEMENT MAP
JOHN DAY HWY. (US26) : TELEPHONE DR. TO COTTONWOOD ST.
GRANT COUNTY, OREGON

ODOT REGION 5 TECH CENTER
3012 ISLAND AVENUE
LA GRANDE, OR 97850
KEY NO. 21494

DECEMBER 7, 2021
SCALE: 1"=50'
SHEET 5 OF 5