



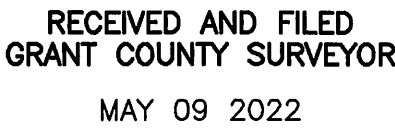

THE SECTION AND SECTION SUBDIVISION LINES SHOWN HEREON ARE PROTRACTED FOR GENERAL INFORMATION ONLY. I LOCATED ABOUT 1000 FEET OF THE COUNTY ROAD NEAR THE SOUTH END OF THE SURVEYED LINE. THE REMAINDER OF THE COUNTY ROAD IS MAPPED FOR INFORMATIONAL PURPOSES ONLY. THE UNSURVEYED AREAS, BEARINGS AND DISTANCES SHOWN HEREON MAY CHANGE UPON THE EXECUTION OF AN ACTUAL COMPLETE SURVEY. I SET NEW MONUMENTS ALONG THE PORTION OF THE SURVEYED LINE ACCORDING TO THE EVIDENCE FOUND AND THE DEED DESCRIPTION. GOD BLESS AMERICA.



BY: [Signature]

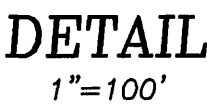


BASIS OF BEARINGS

GEODETIC NORTH BASED ON GPS OBSERVATIONS
THE SURVEYED STRAIGHT LINE BETWEEN THE NE CORNER
AND NW CORNER SEC. 6, T.9S., R.32E. W.M.,
BEARS N89°16'53"W

LEGEND


- (●) FOUND 2½ ALUMINUM PIPE AND CAP FROM SURVEY NO. 1192
 ○ SET 5/8"x30" IRON PIN WITH ATTACHED YELLOW PLASTIC CAP MARKED BENCHMARK SURVEYING
 () GLO RECORD BEARING AND DISTANCE
 [] RECORD BEARING AND DISTANCE FROM SURVEY NO. 1192
 X—X FENCE LINE

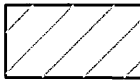

PROPERTY LINE ADJUSTMENT TRACT: JENSEN TO BURNETT

REFERENCES

RECORD MAP OF SURVEY NO.'S 252 & 1192
DEED RECORD INSTRUMENT NO.'S 970255, 20192182 & 20220583
GENERAL LAND OFFICE FIELD NOTES

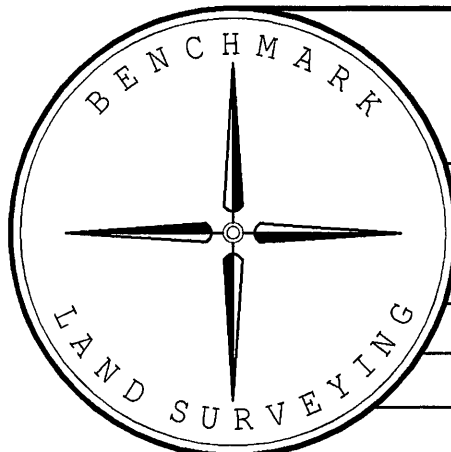

BENCHMARK LAND SURVEYING
217 N. CANYON BLVD. JOHN DAY, OREGON
541-575-1251 ~ benchmarkls.com

MAP OF SURVEY
A PROPERTY LINE ADJUSTMENT
SITUATED IN SECTION 7, T.9S., R.32E., W.M.,
GRANT COUNTY, OREGON

SURVEYED FOR	BURNETTE / JENSEN	
SURVEYED BY	MCS	4/17/2022
SCALE: 1"=1000'	DRAWN BY: MCS	