# SW¼ NW¼ SE¼ NW¼ PVT. N.F.S.L. BASIS OF BEARINGS S 89'12'00" W, 2657.98' 1328.99' 29 28 1328.99 (S 89°12'00" W, 1328.32') (S 89°12'00" W, 1328.32') E½ SW¼ N.F.S.L. W½ SW¼ 28 33 BASIS OF BEARINGS THE BASIS OF BEARINGS IS THE WEST HALF OF THE EAST-WEST CENTER LINE OF SECTION 28 (S 8912'00" W) TOWSHIP 11 SOUTH, RANGE 30 EAST, WILLAMETTE MERIDIAN. AS SHOWN ON THE MAP OF SURVEY 955 PERFORMED BY PLS 848 AND RECORDED ON DECEMBER 18TH. DISTANCES SHOWN HEREON ARE GROUND DISTANCES.

CERTIFY THAT THIS SURVEY WAS PERFORMED AT THE

Date: 2022.10.13 10:23:58 -07'00'

DATE

REQUEST OF THE MALHEUR NATIONAL FOREST.

CRAIC TRILL OCK


Digitally signed by CRAIG TRULOCK

CRAIG TRULOCK

FOREST SUPERVISOR

DEPENDENT RESURVEY AND SUBDIVISION OF A PORTION OF SECTION 28, TOWNSHIP 11 SOUTH, RANGE 30 EAST WILLAMETTE MERIDIAN

GRANT COUNTY, OREGON

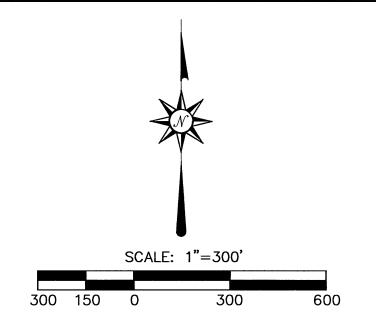

#### NARRATIVE

THE PURPOSE OF THIS SURVEY IS TO LOCATE, MONUMENT, AND MARK THE BOUNDARIES OF NATIONAL FOREST SYSTEM LANDS LOCATED IN SECTION 28, TOWNSHIP 11 SOUTH, RANGE 30 EAST, WILLAMETTE MERIDIAN, GRANT COUNTY, OREGON.

THIS SURVEY WAS CONDUCTED USING GLOBAL POSITIONING SYSTEM EQUIPMENT AND CONVENTIONAL EQUIPMENT. A SINGLE BASE SYSTEM WAS INCORPORATED FOR SURVEY CONTROL AND LOCATING CORNER POSITIONS USING REDUNDANT MEASUREMENTS. THE DATA WAS DOWNLOADED INTO TRIMBLE BUSINESS CENTER SOFTWARE AND CORRECTED USING OPUS. THE OPUS SOLUTION REPORTED A COMBINED SCALE FACTOR OF 1.000308970.

THE SECTION SUBDIVISION SHOWN HEREON WAS PERFORMED IN ACCORDANCE WITH THE PROCEDURES SET FORTH IN THE 2009 BLM MANUAL OF SURVEYING INSTRUCTIONS.

THE SUBDIVISION OF TOWNSHIP 11 SOUTH, RANGE 30 EAST WAS PERFORMED UNDER TWO SEPARATE CONTRACTS. W H. BYARS SUBDIVIDED THE WESTERN TWO TIERS OF SECTIONS UNDER CONTRACT NO. 127 FROM AUGUST 19TH - AUGUST 22ND, 1873 AND APPROVED ON FEB 25TH, 1874. SAMUEL W. LACKLAND SUBDIVIDED THE REMAINING PORTION UNDER CONTRACT NO. 415, FROM SEPTEMBER 10TH - 18TH, 1881 AND APPROVED ON MARCH 10, 1882.

THE WEST 1/16 CORNER OF SECTION 28 AND 33 WAS SET BY DOUGLAS M. FERGUSON, PLS NO. 848 AS SHOWN ON MAP OF SURVEY 904, RECORDED ON DECEMBER 20TH, 1985 FOR THE MALHEUR NATIONAL FOREST, CONTRACT NO. 53-04HI-3-9347N FROM MAY, 1984, SEPTEMBER - OCTOBER 1985.

THE SUBDIVISION OF SECTION 28 WAS DONE BY DOUGLAS M. FERGUSON, PLS 848 AS SHOWN ON MAP OF SURVEY 955, RECORDED ON DECEMBER 18TH, 1986 FOR THE MALHEUR NATIONAL FOREST, CONTRACT NO. 53-04HI-5-0150N FROM AUGUST - OCTOBER 1986.

FOR MONUMENTATION RECORDS, SEE THE CERTIFIED RECORD OF LAND CORNER MONUMENTATION SHEETS FILED SEPARATELY IN THE GRANT COUNTY SURVEYOR'S OFFICE.

THE NATIONAL FOREST BOUNDARY SHOWN HEREON WAS MARKED WITH ALUMINUM POST AND NATIONAL FOREST BOUNDARY SIGNS. EACH MONUMENT HAS GUARD POSTS WITH LAND SURVEY MONUMENT SIGNS AND BOUNDARY SIGNS AS NEEDED.

### LEGEND

- FOUND 31/4" ALUMINUM CAP, MOS 955
- FOUND 3¼" ALUMINUM CAP, MOS 904
- SET A 3¼" ALUMINUM CAP ON 2½"X30" PIPE WITH STANDARD 1/16 CORNER MARKINGS, PLS 91693, 2022

NATIONAL FOREST BOUNDARY LINE

- SECTION LINE

---- SECTION SUBDIVISION LINE

-X X BARBED WIRE FENCE LINE

N.F.S.L. NATIONAL FOREST SYSTEM LANDS

PVT. PRIVATE LANDS

RECORD DIMENSIONS, MOS 955

### REFERENCES

- PATENT NO. 36-2001-0079, APPROVED ON DECEMBER 14TH, 2000.
- QUITCLAIM DEED NO. 36-2001-D0003, RECORDED ON DECEMBER 29TH, 2000, AS INSTRUMENT NO. 203197.
- GENERAL LAND OFFICE SURVEY OF TOWNSHIP 11 SOUTH, RANGE 30 EAST, WILLAMETTE MERIDIAN, CONTRACT NO. 127, APPROVED ON FEBRUARY 25TH, 1874.
- GENERAL LAND OFFICE SURVEY OF TOWNSHIP 11 SOUTH, RANGE 30 EAST, WILLAMETTE MERIDIAN, CONTRACT NO. 415, APPROVED ON MARCH 10TH, 1882.
- MAP OF SURVEY 904, PERFORMED BY PLS 848 AND RECORDED AT GRANT COUNTY SURVEYOR'S OFFICE ON DECEMBER 2ND, 1985,
- MAP OF SURVEY 955, PERFORMED BY PLS 848 AND RECORDED AT GRANT COUNTY SURVEYOR'S OFFICE ON DECEMBER 18TH, 1986.

RECEIVED AND FILED GRANT COUNTY SURVEYOR

OCT **26** 2022

**PROFESSIONAL** LAND SURVEYOR 10/13/22

OREGON SEPTEMBER 11, 2018 ROBERT C. MOYERS

REGISTERED

RENEWS 12/31/2022

## UNITED STATES DEPARTMENT OF AGRICULTURE FOREST SERVICE

REGION 6 - WALLOWA-WHITMAN NATIONAL FOREST 1550 DEWEY AVE., SUITE A, BAKER CITY, OREGON 97814 - (541) 523-1281



SURVEY FOR MALHEUR NATIONAL FOREST LOCATED IN SECTION 28 TOWNSHIP 11 SOUTH, RANGE 30 EAST WILLAMETTE MERIDIAN GRANT COUNTY, OREGON

SURVEY COMPLETED AUGUST 29, 2022

DRAWN BY: TJQ

CHECKED BY: RCM SCALE: 1"=300' SHEET 1 of 1