


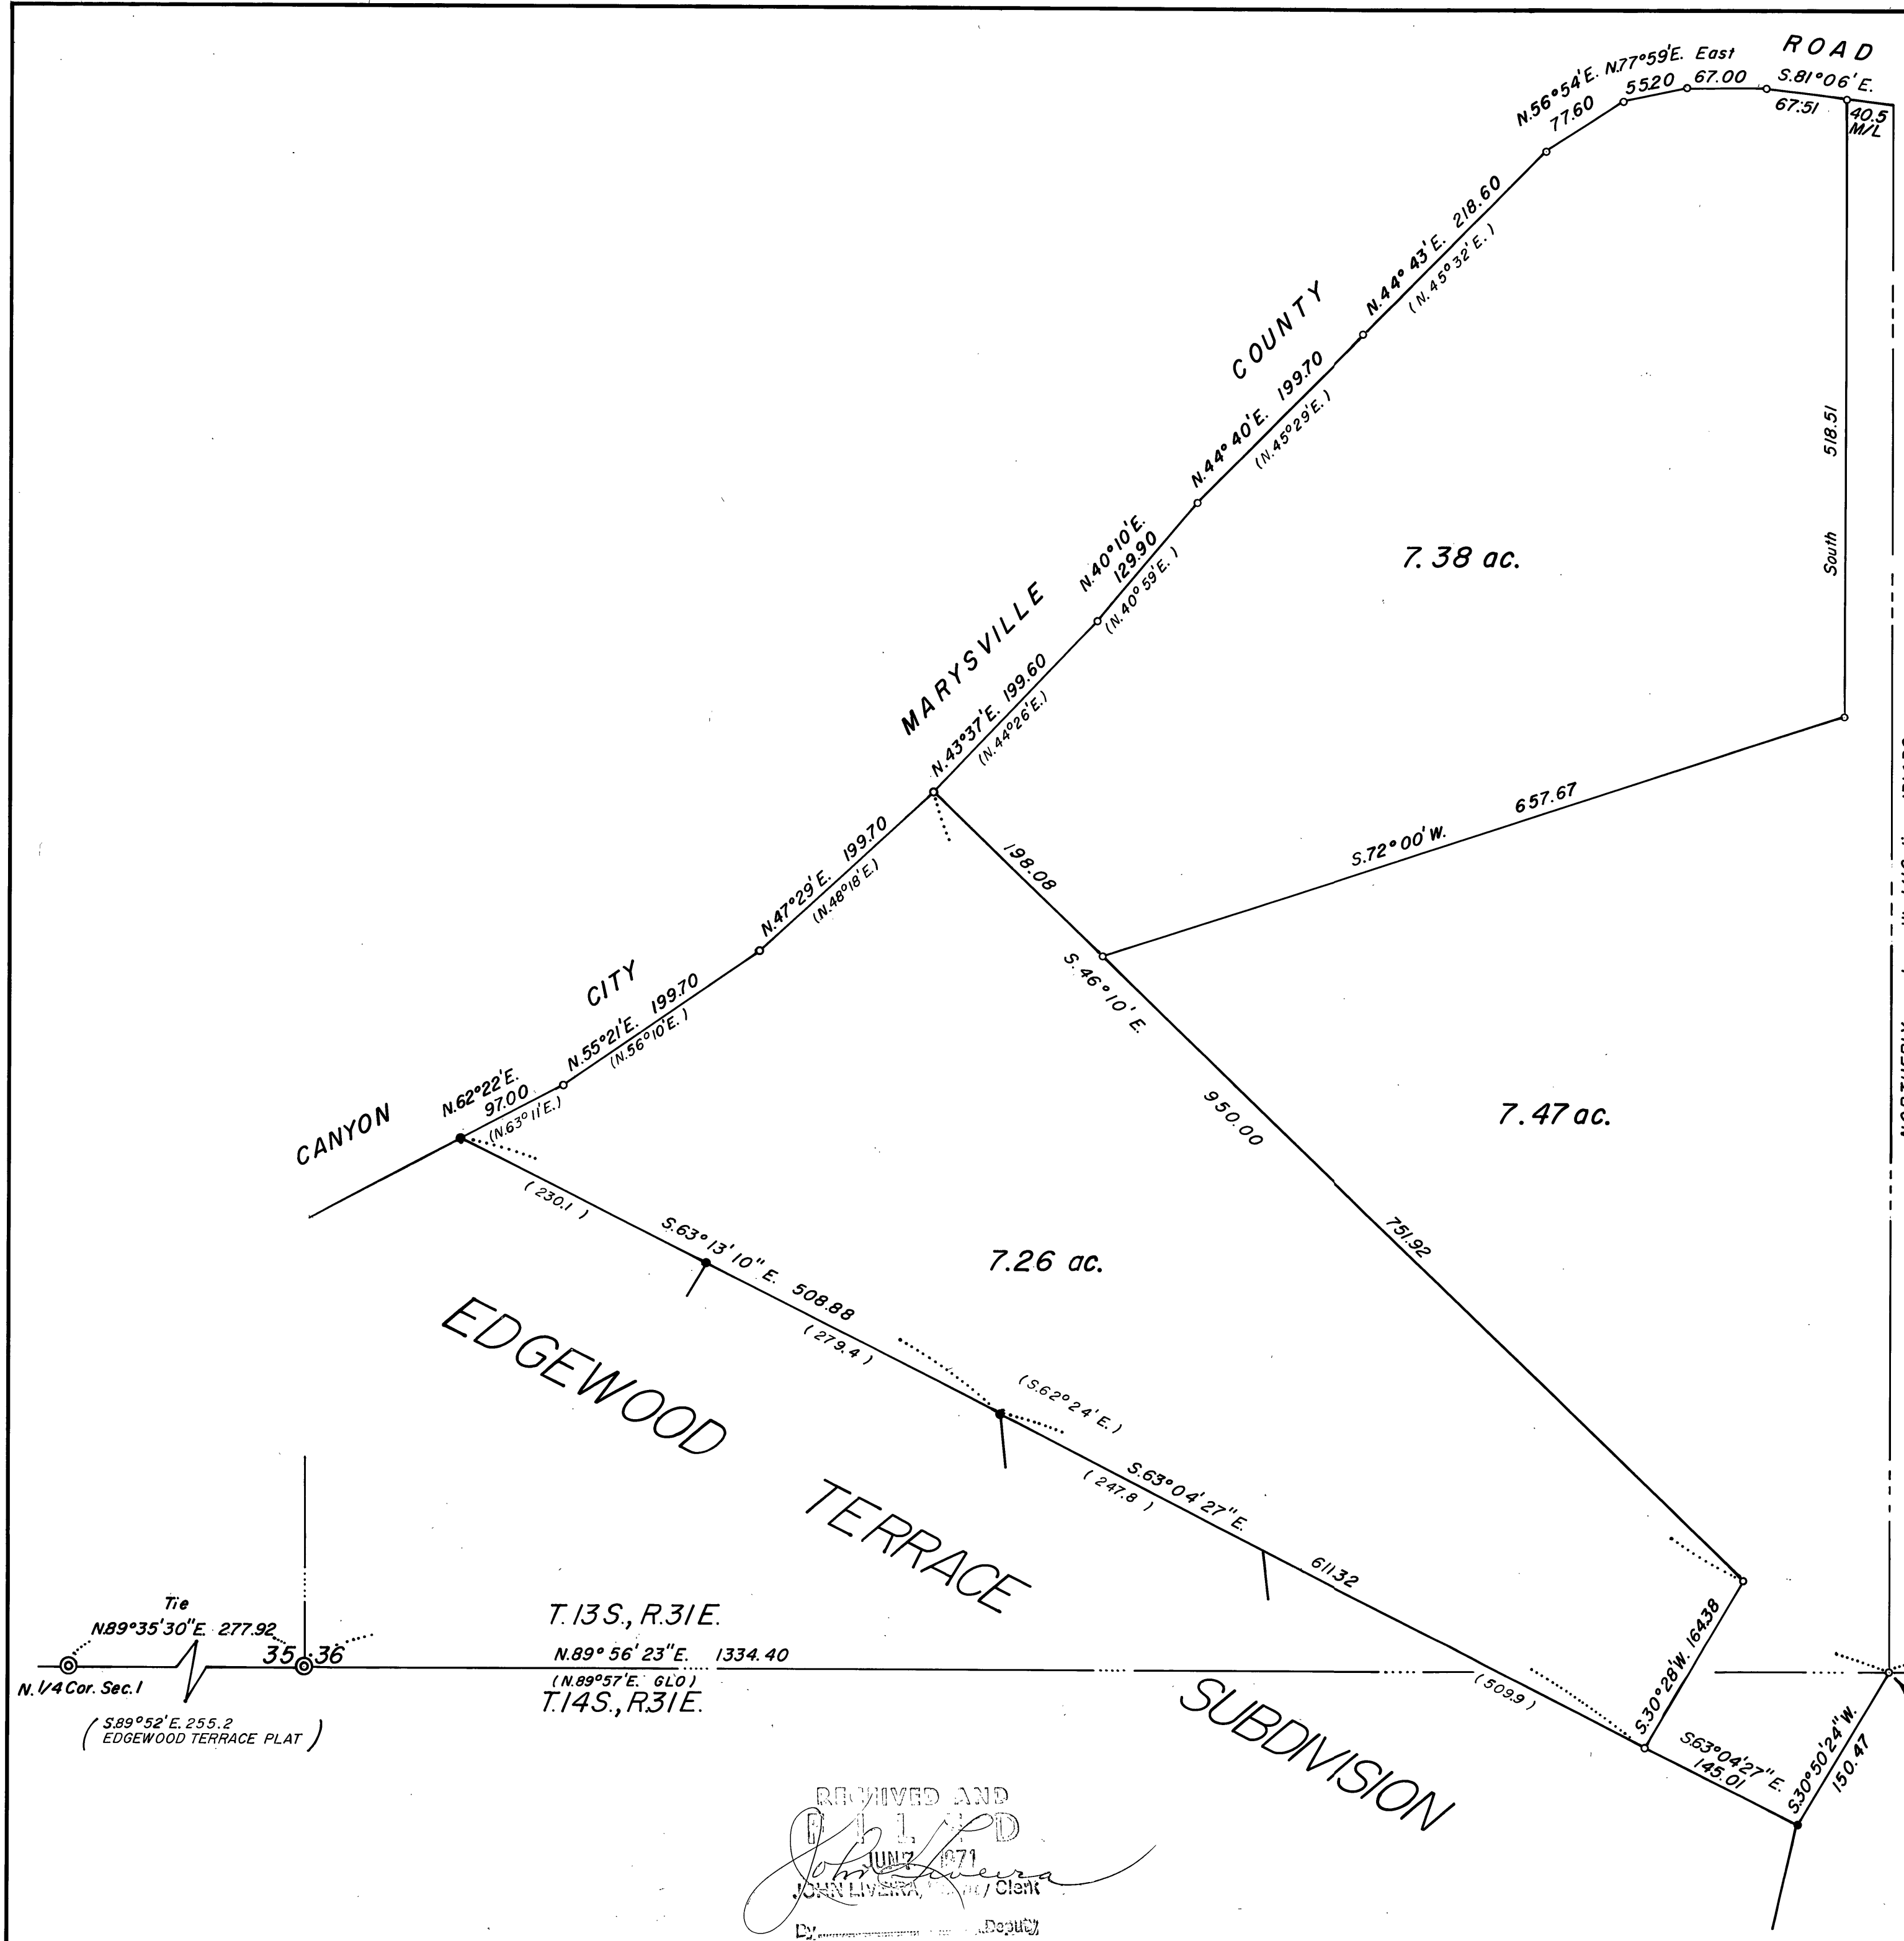

BASIS OF BEARINGS

Solar Observation

REGISTERED
OREGON
LAND SURVEYOR

Robert D. Baggett

JULY 12, 1963
ROBERT D. BAGGETT
598

LEGEND

- Set 5/8"x30" iron pin with plastic cap marked "BGF SURVEY MK".
- Found Brass Cap monument.
- Found lot cor. monuments EDGEWOOD TERRACE SUBDIVISION.

BAGETT-GRIFFITH-FERGUSON

John Day, Oregon

PARCELS IN SW 1/4 SW 1/4, SEC. 36, T. 13S., R. 31E.,
and NE 1/4 SEC. 1, T. 14S., R. 31E., W.M.

GRANT COUNTY, OREGON

SURVEYED FOR	WES WILSON		
SURVEYED BY	R.D.B. & D.M.F.	May 1971	
Scale: 1" = 100'	Drawn by:	R.D.B.	May 1971