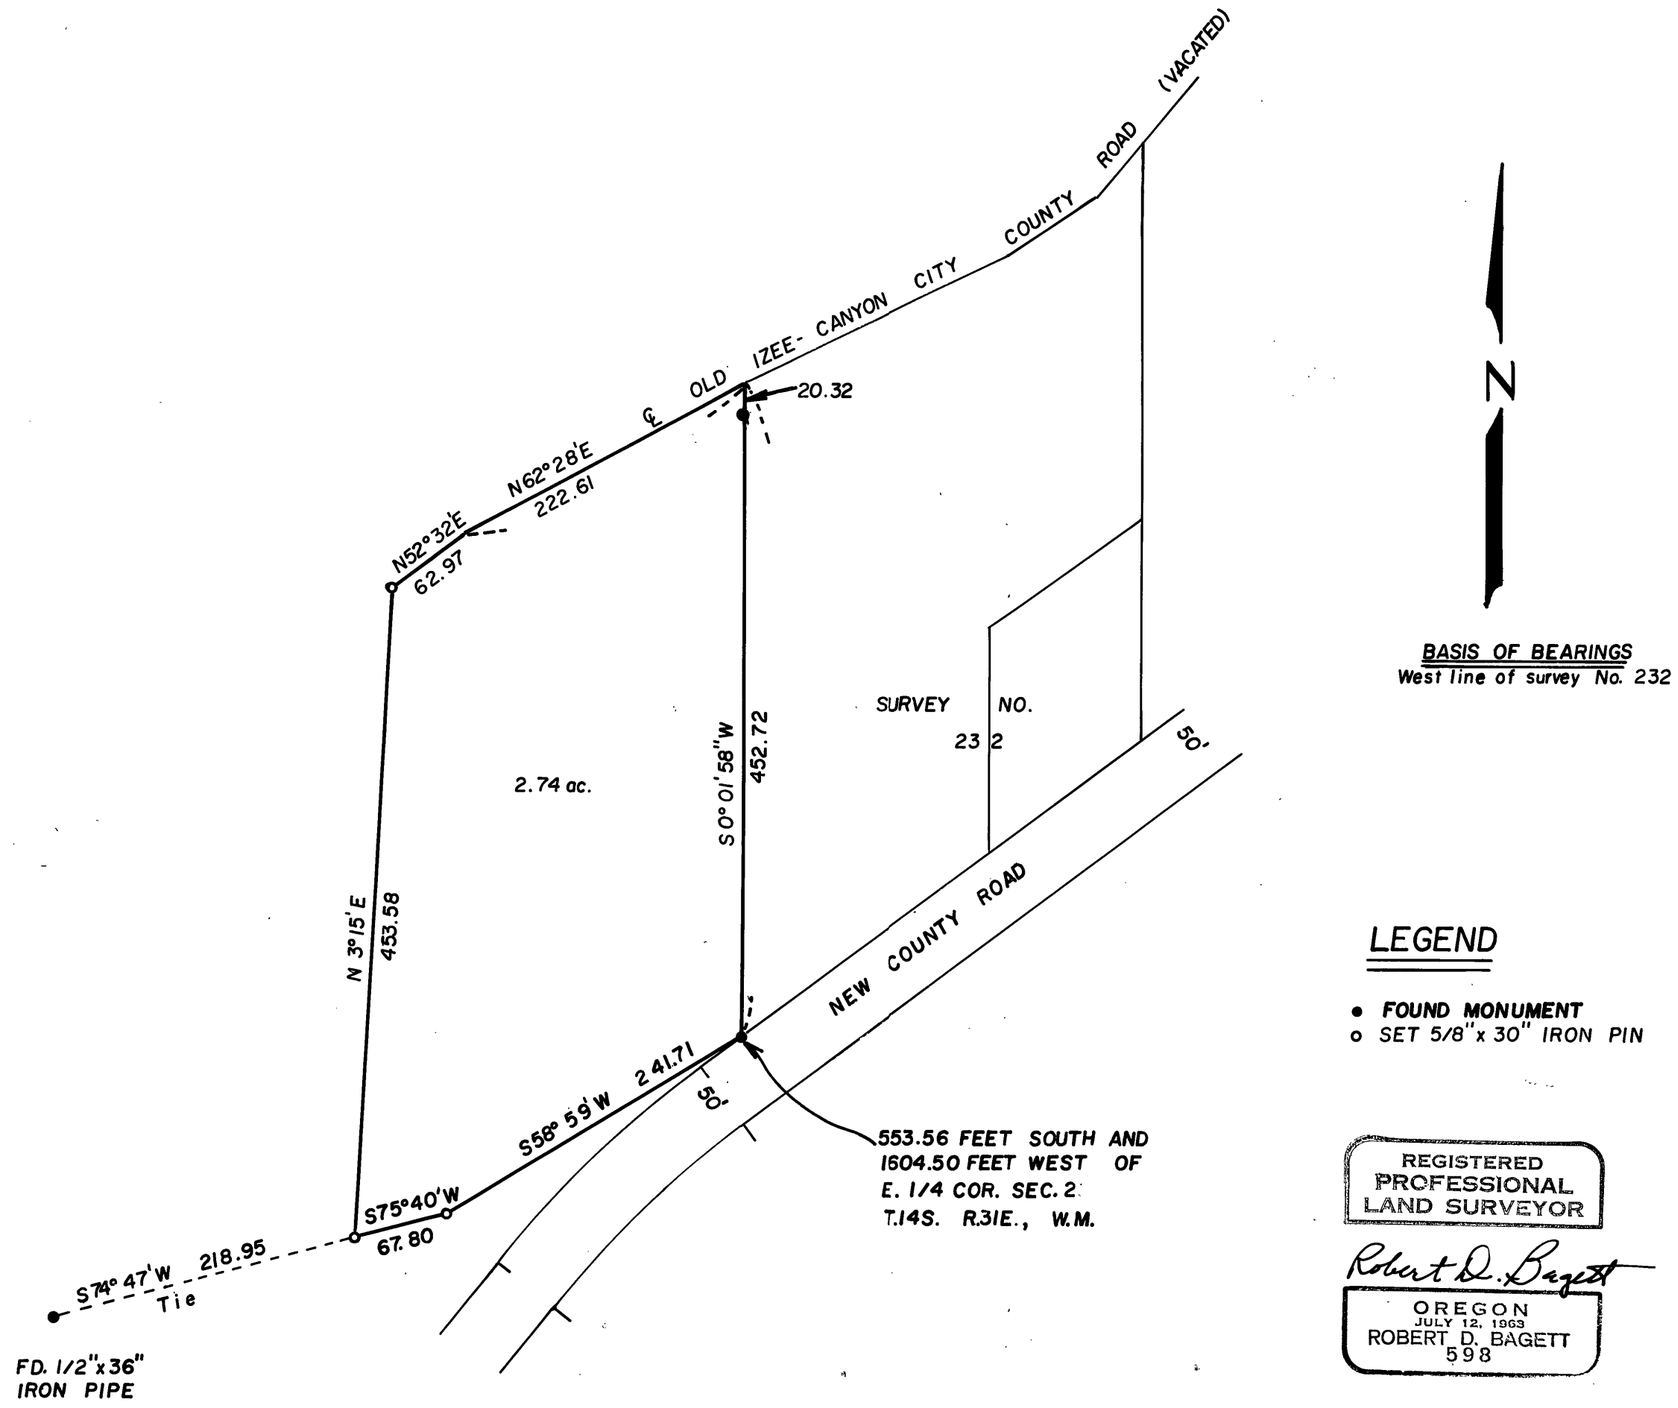

BASIS OF BEARINGS
West line of survey No. 232

LEGEND

- ● FOUND MONUMENT
- o SET 5/8"x 30" IRON PIN

REGISTERED
PROFESSIONAL
LAND SURVEYOR

Robert D. Bagett

OREGON
JULY 12, 1963
ROBERT D. BAGETT
598

RECEIVED AND
FILED
APR 12 1972
JOHN LIVEIRA, County Clerk
By Darlene Lemons Deputy

BAGETT-GRIFFITH-FERGUSON **John Day, Oregon**		
Map of Survey A PARCEL IN THE NW 1/4 SE 1/4 SEC. 2 T 14 S R 31 E W. M. CANYON CITY GRANT COUNTY, OREGON		
SURVEYED FOR	A. SPROUFFSKE & R. MORGAN	
SURVEYED BY	R. D. B. & J. D. B.	4/7/72
Scale: 1" = 100	Drawn by: J. D. B.	4/10/72

SURVEY NO. 259