


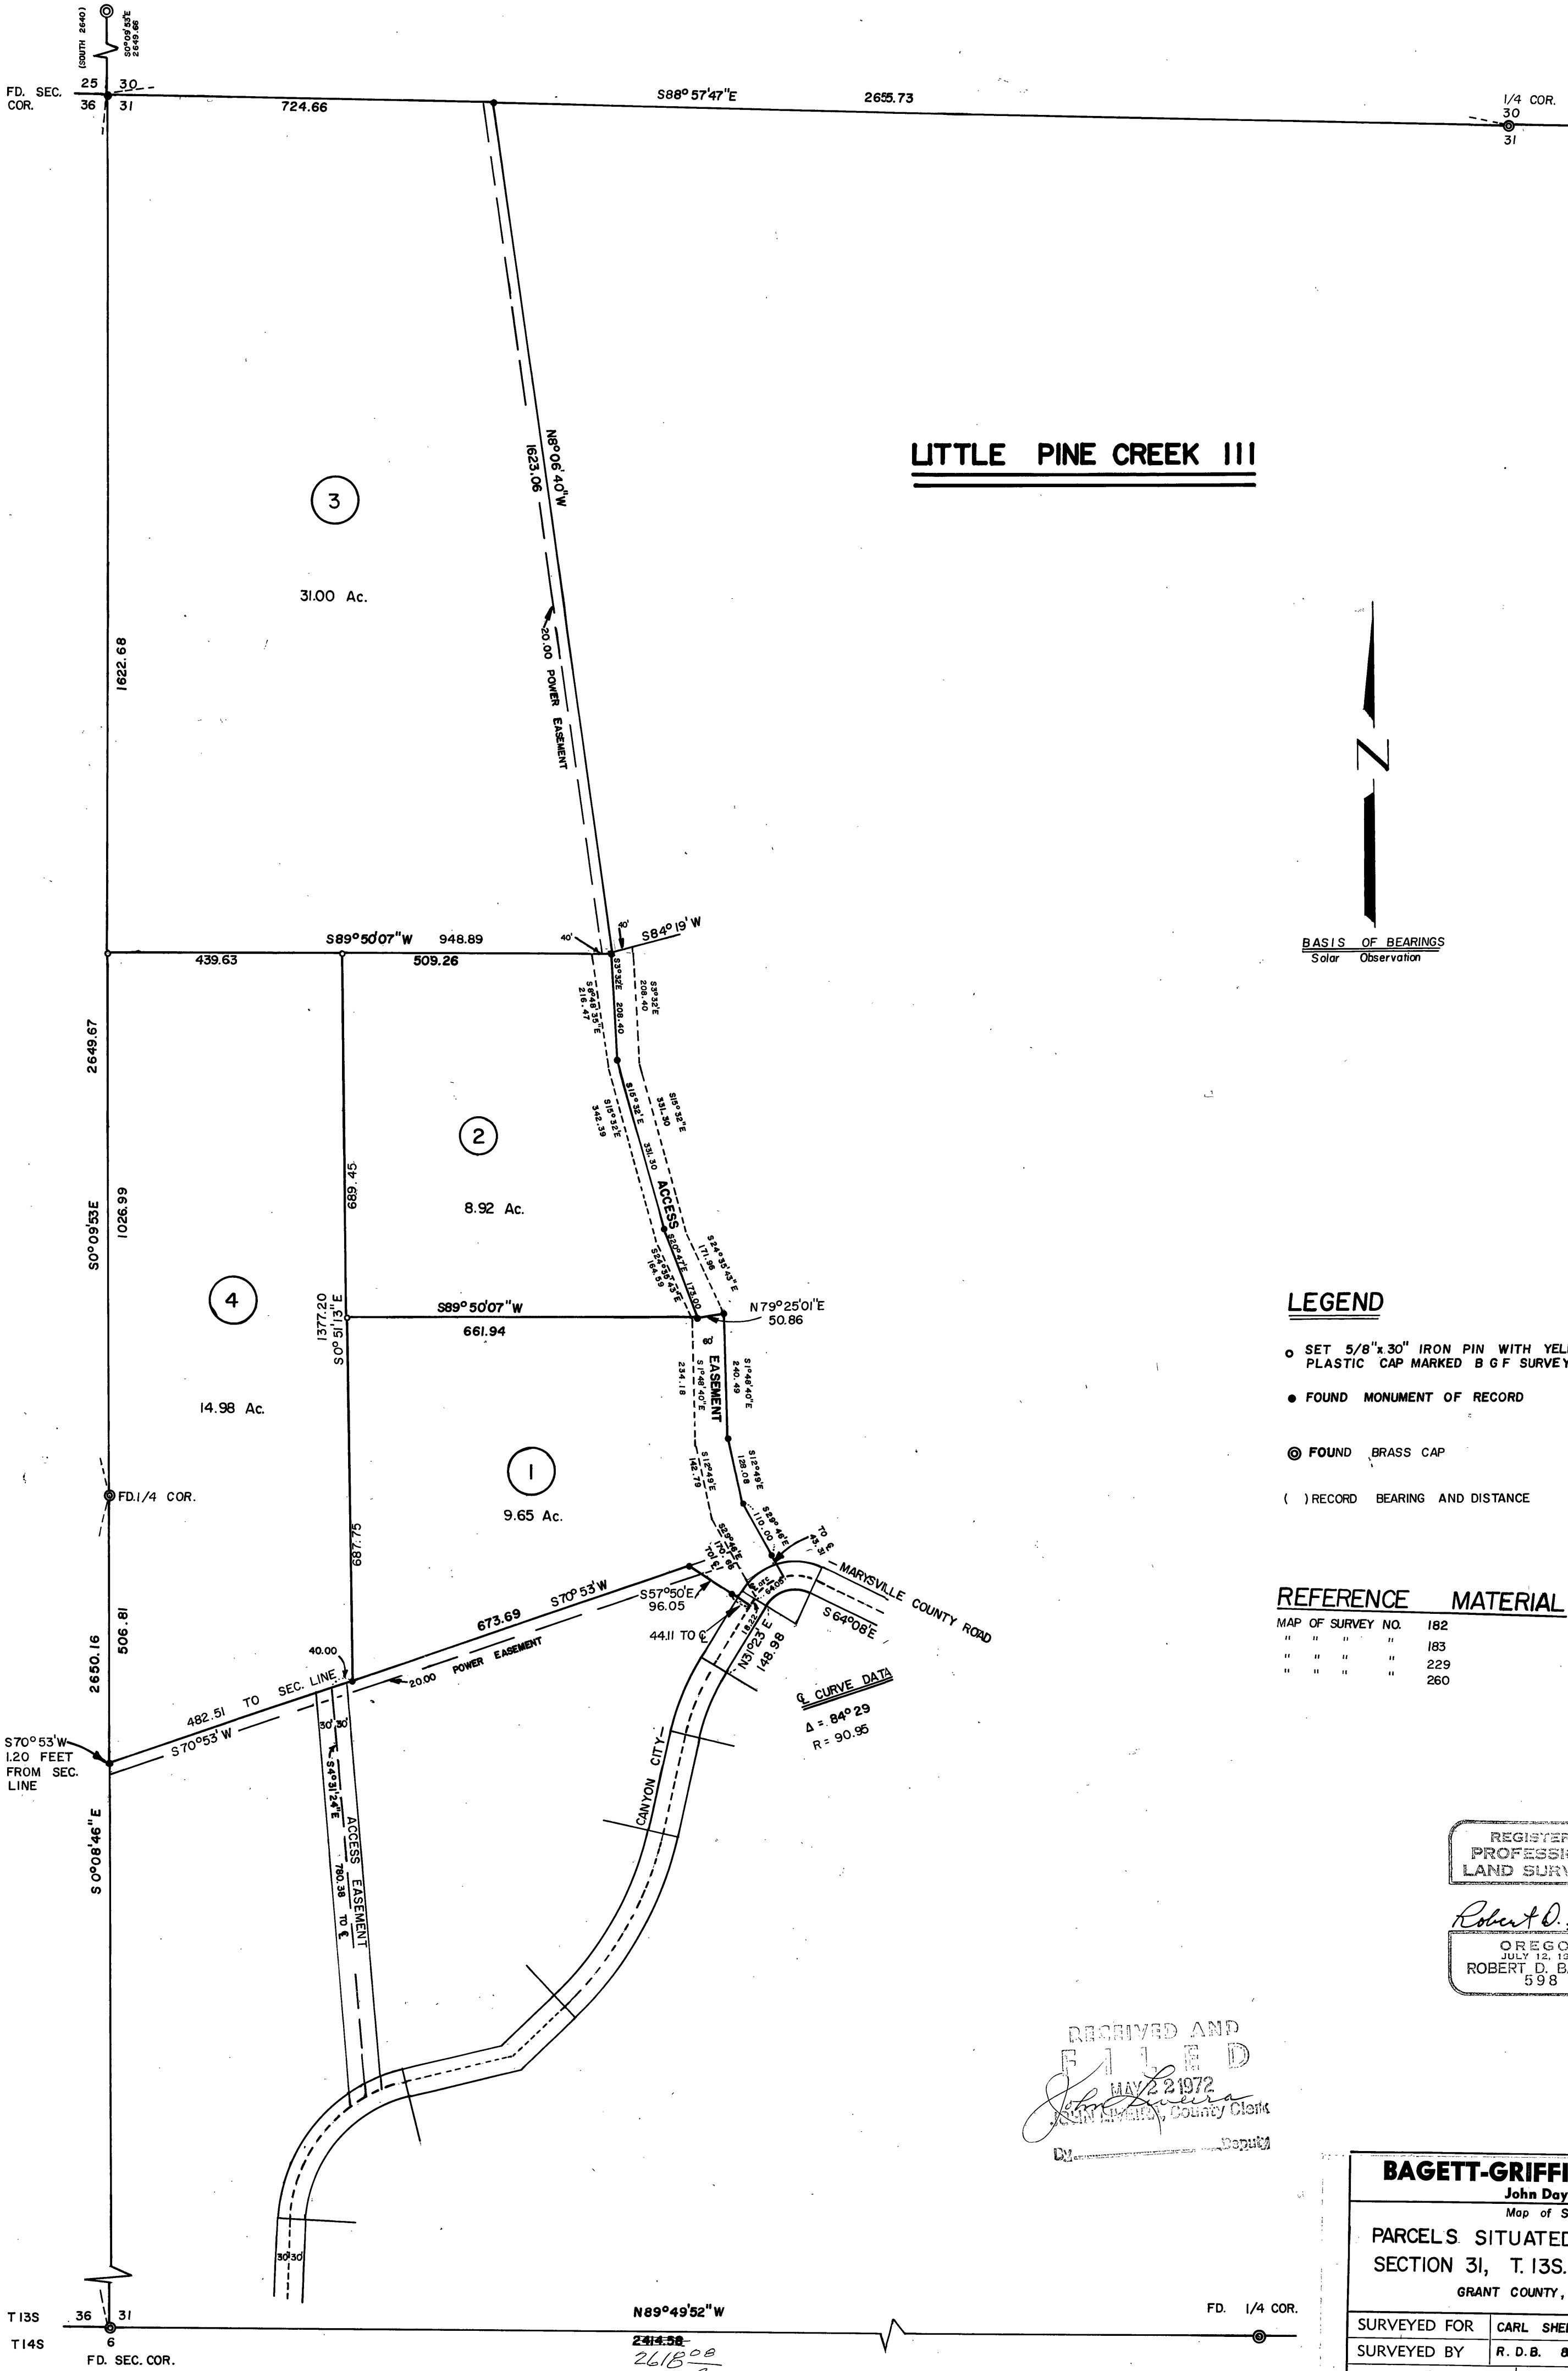

**LITTLE PINE CREEK III**

BASIS OF BEARINGS  
Solar Observation

**LEGEND**

- SET 5/8"x30" IRON PIN WITH YELLOW PLASTIC CAP MARKED B G F SURVEY MK
- FOUND MONUMENT OF RECORD
- ◎ FOUND BRASS CAP
- ( ) RECORD BEARING AND DISTANCE

**REFERENCE MATERIAL**

|                   |     |
|-------------------|-----|
| MAP OF SURVEY NO. | 182 |
| " " " "           | 183 |
| " " " "           | 229 |
| " " " "           | 260 |

REGISTERED  
PROFESSIONAL  
LAND SURVEYOR

*Robert D. Baggett*

OREGON  
JULY 12, 1963  
ROBERT D. BAGGETT  
598

RECEIVED AND  
FILED  
MAY 2 1972  
JOHN L. LAMAR, County Clerk  
Deputy

**BAGETT-GRIFFITH-FERGUSON**

John Day, Oregon

Map of Survey

PARCELS SITUATED IN THE W.1/2 OF  
SECTION 31, T.13S., R.32 S. W.M.  
GRANT COUNTY, OREGON

|                  |                                 |
|------------------|---------------------------------|
| SURVEYED FOR     | CARL SHEEDY & BETTY JANE SHEEDY |
| SURVEYED BY      | R. D. B. & J. D. B.             |
| Scale: 1" = 200' | Drawn by: J. D. B.              |
|                  | 5/1972                          |