


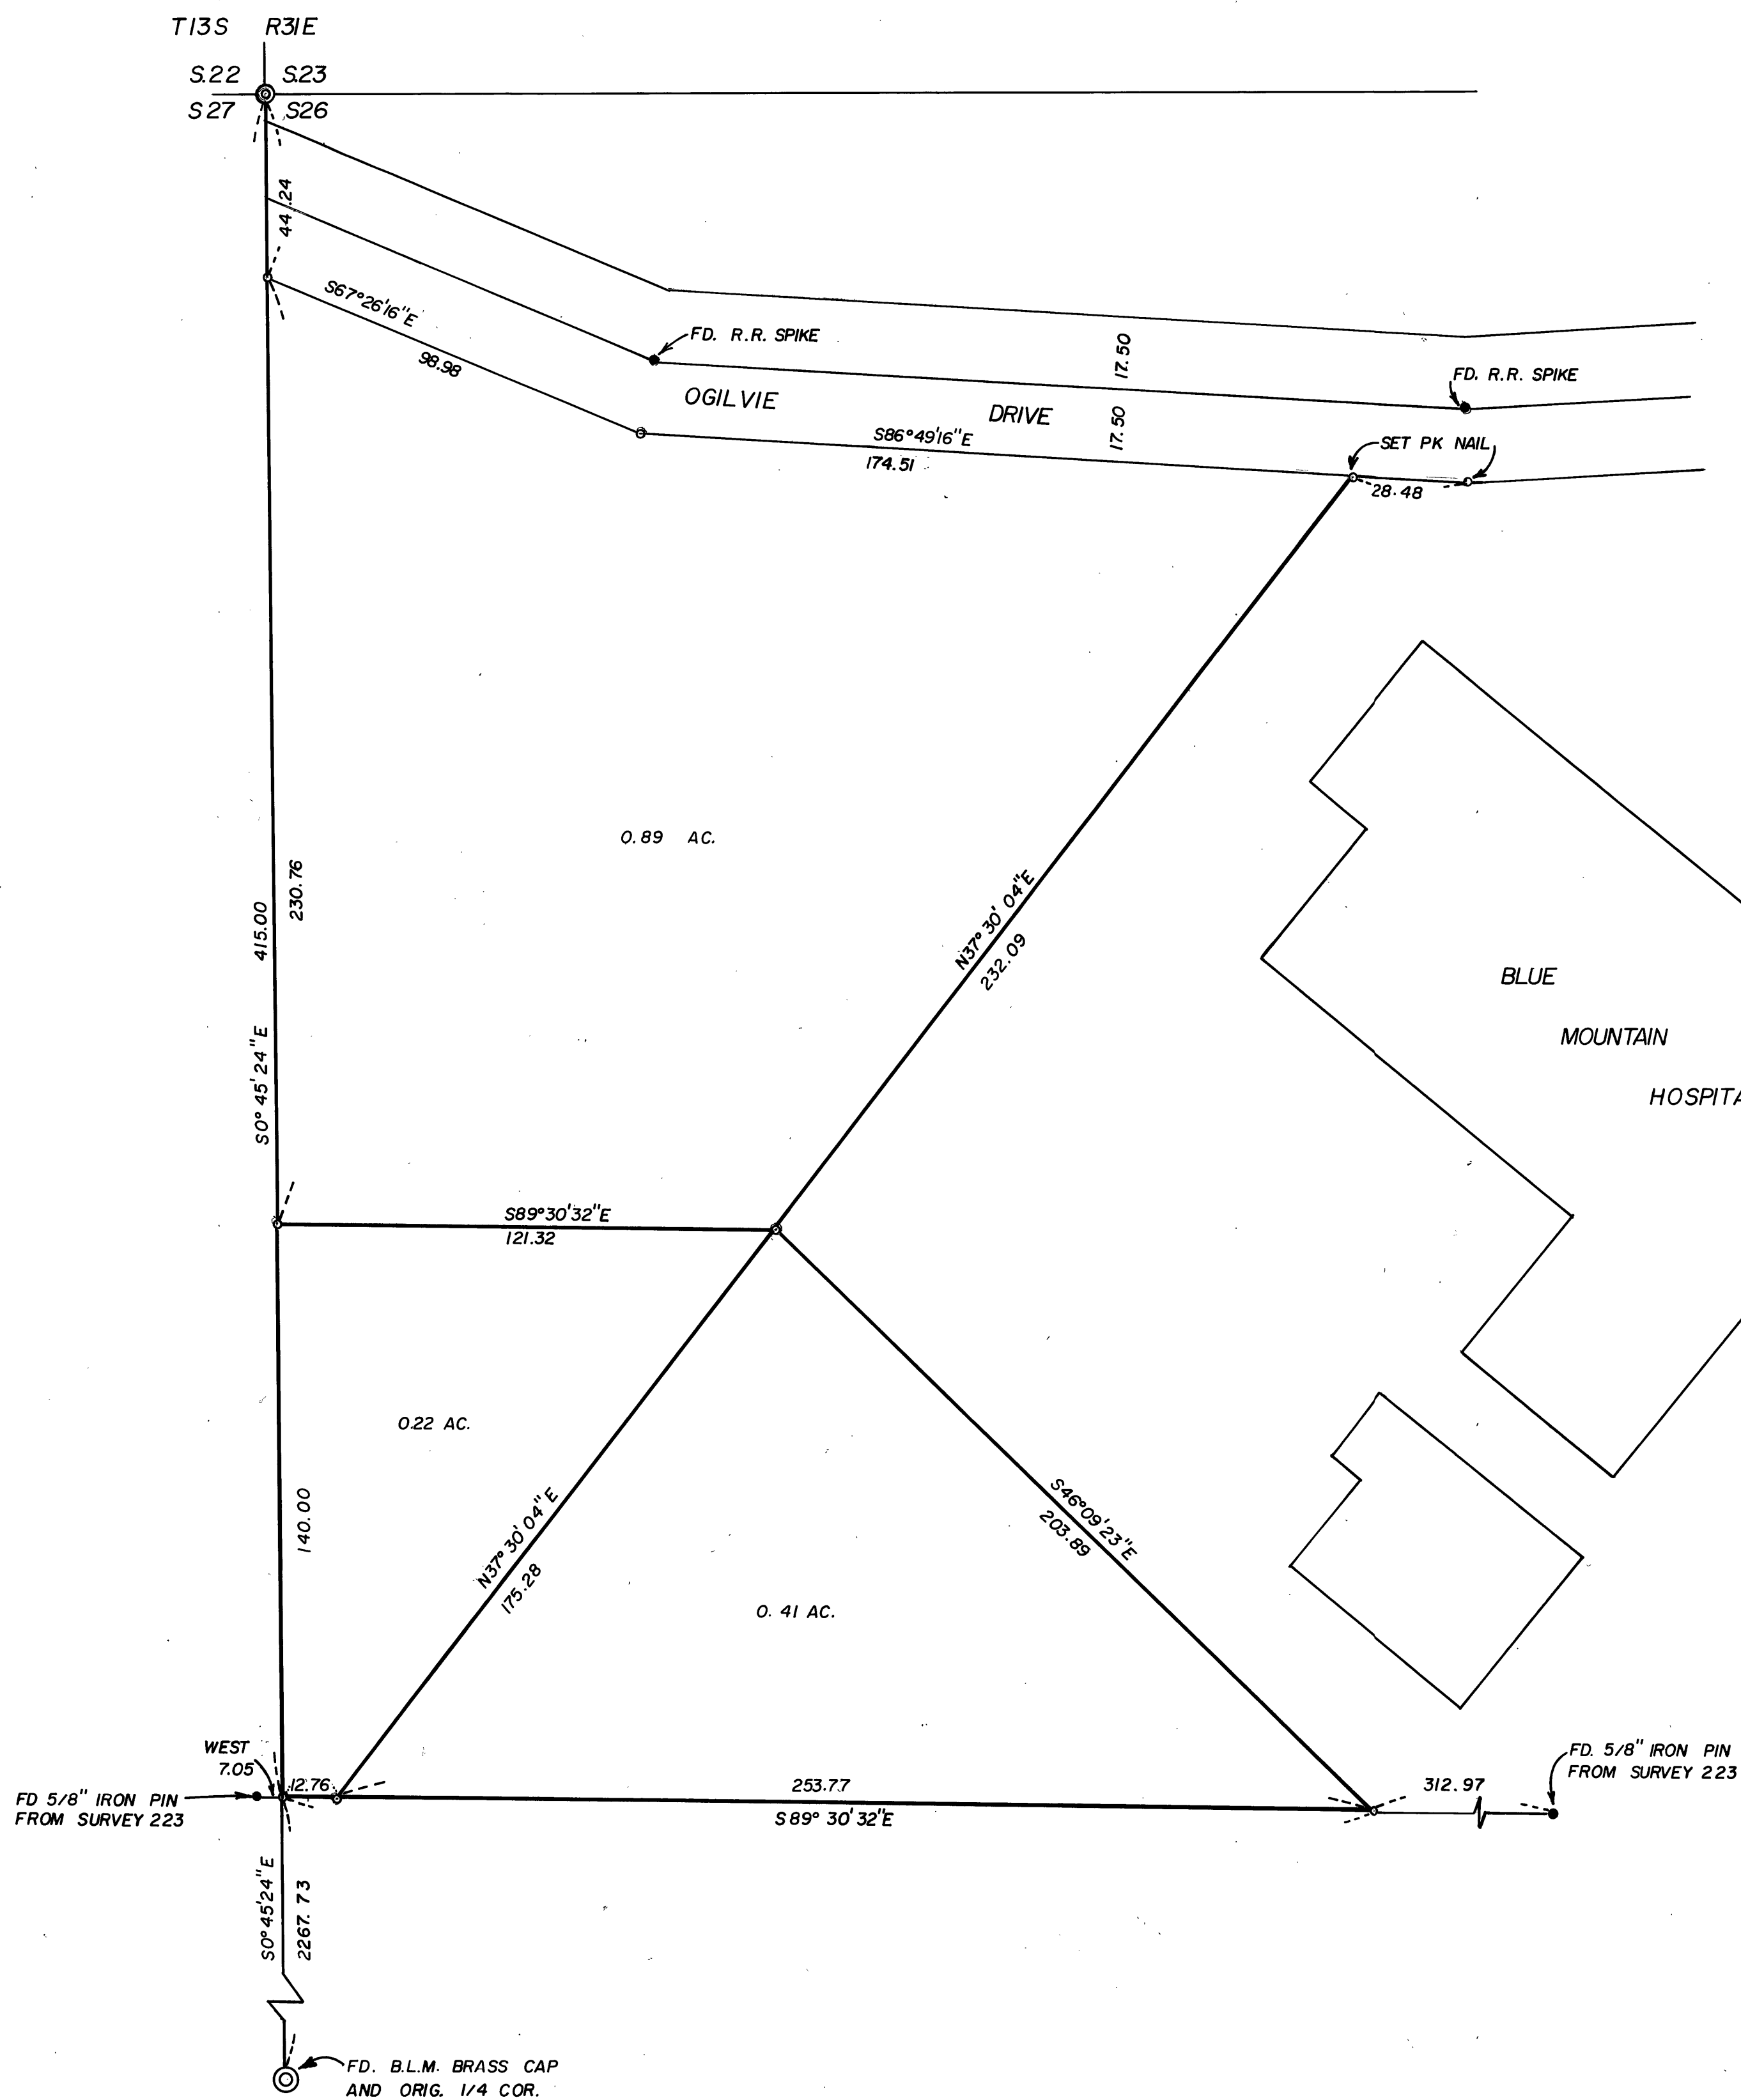

BASIS OF BEARINGS
solar observation

RECEIVED AND
FILED
JUL 28 1972
JOHN LIVERA, County Clerk
By _____ Deputy

REGISTERED
PROFESSIONAL
LAND SURVEYOR

Robert D. Baggett
OREGON
JULY 12, 1933
ROBERT D. BAGETT
598

BAGETT-GRIFFITH-FERGUSON

John Day, Oregon <i>Map of Survey</i>		
A PARCEL OF LAND SITUATED IN THE NW1/4 NW1/4 SECTION 26, TWP 13 S., R31 E.W.M.		
GRANT COUNTY, OREGON		
SURVEYED FOR	JOHN DAY MEDICAL CLINIC	
SURVEYED BY	R.D.B. & J.D.B.	7/30/72
Scale: 1" = 30'	Drawn by: J.D.B.	7/30/72