

# **LEGEND**

- SET 5/8"x30" IRON PIN WITH ATTACHED PLASTIC CAP
- FOUND 1 1/2" IRON PIPE
- ( ) RECORD
- x- FENCE

## **BASIS OF BEARINGS**


solar observation

REGISTERED  
PROFESSIONAL  
LAND SURVEYOR

*Robert D. Baggett*

OREGON  
JULY 12, 1963  
ROBERT D. BAGGETT  
598

T.9S., R.27E., W.M.

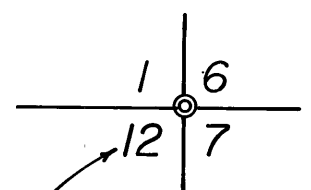

Fd. old 3/4" iron pipe  
which has been used as sec. cor.

RECEIVED AND  
FILED  
JUL 14 1972  
JOHN W. LUTER, County Clerk  
*Betty Howards*

## **BAGETT-GRIFFITH-FERGUSON**

John Day, Oregon

Map of Survey

A PARCEL OF LAND SITUATED IN THE SW1/4 SE1/4  
OF SEC. 1 & THE NW1/4 NE1/4 SEC. 12,

T.9S., R.27E., W.M.

GRANT COUNTY, OREGON

SURVEYED FOR	PHIL MURPHY	
SURVEYED BY	R.D.B. & J.D.B.	AUG. 1972
Scale: 1"= 100'	Drawn by: J.D.B.	AUG. 1972