


BASIS OF BEARINGS
solar observation

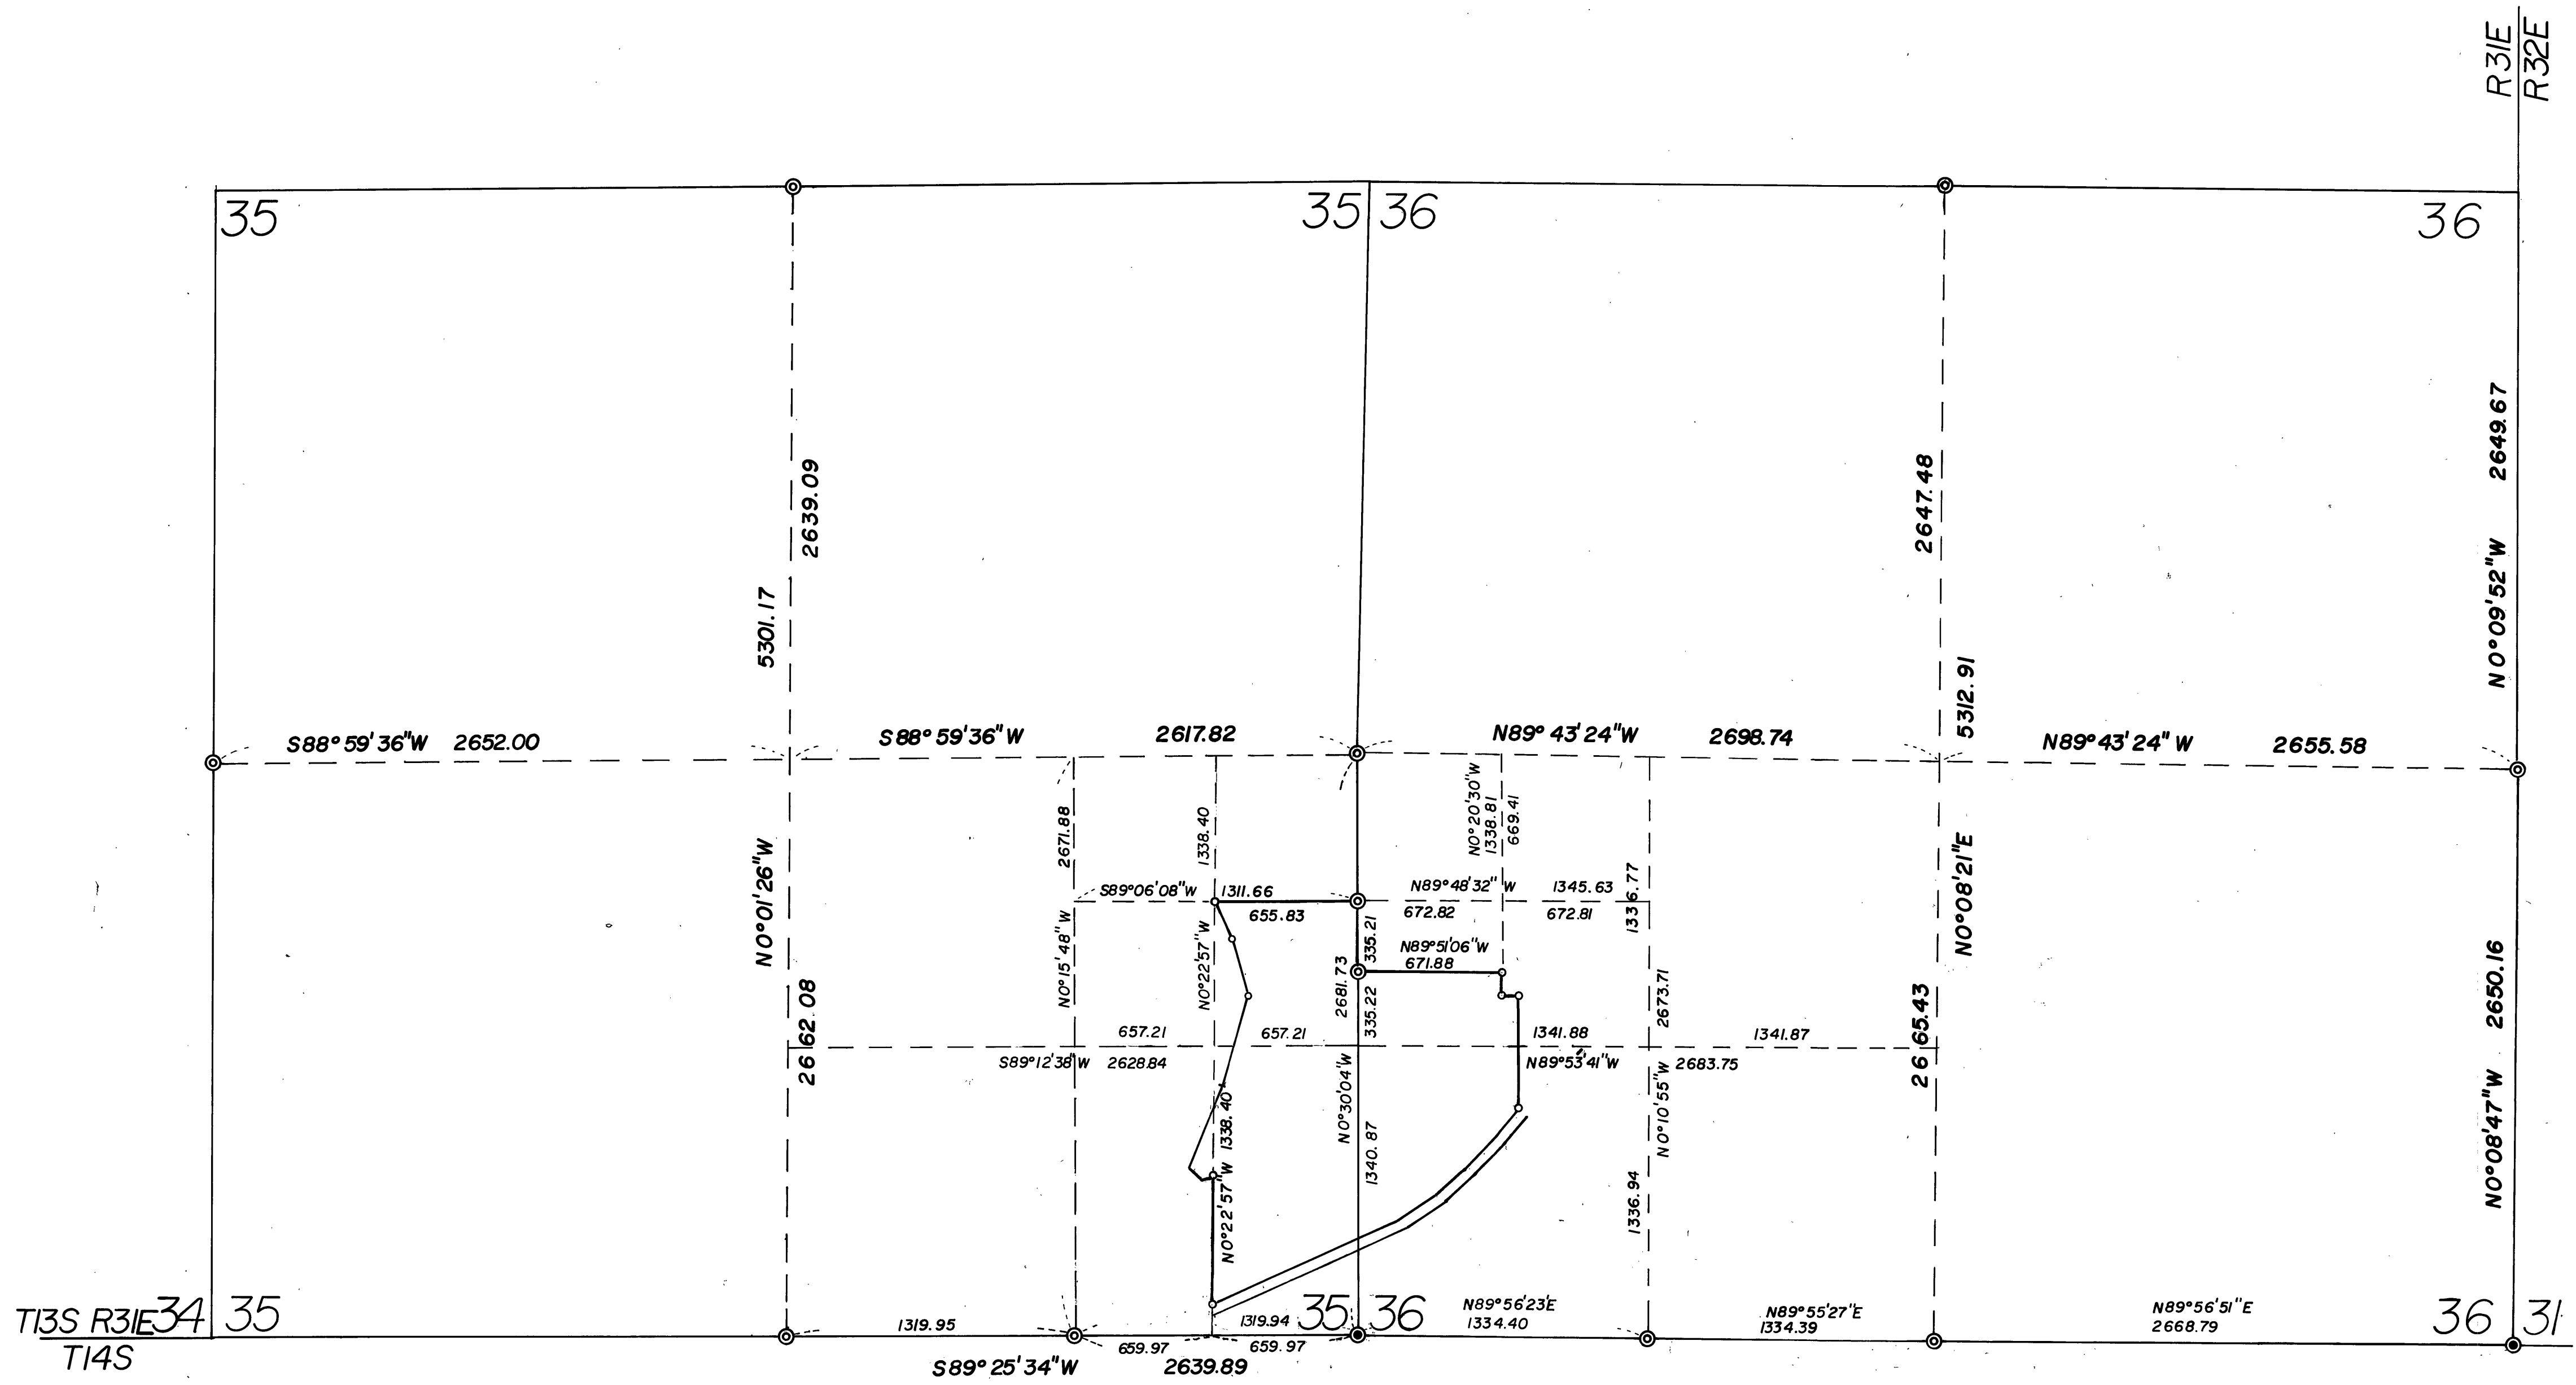

T13S R31E 34 35
T14S


NOTE:
The subdivision of these sections was based on found
BLM brass caps which were established in the summer
of 1971. The official notes and plat of the BLM survey
have not yet been approved for public use.

LEGEND

- SET 5/8"x30" IRON PIN
- ⊙ FOUND B.L.M. BRASS CAP
- ⊙ FOUND COUNTY BRASS CAP

RECEIVED AND
FILED
SEP 14 1972
JOHN LIVERIA County Clerk
By *Robert D. Baggett* County

DETAIL OF PROPERTY
scale 1"=200'

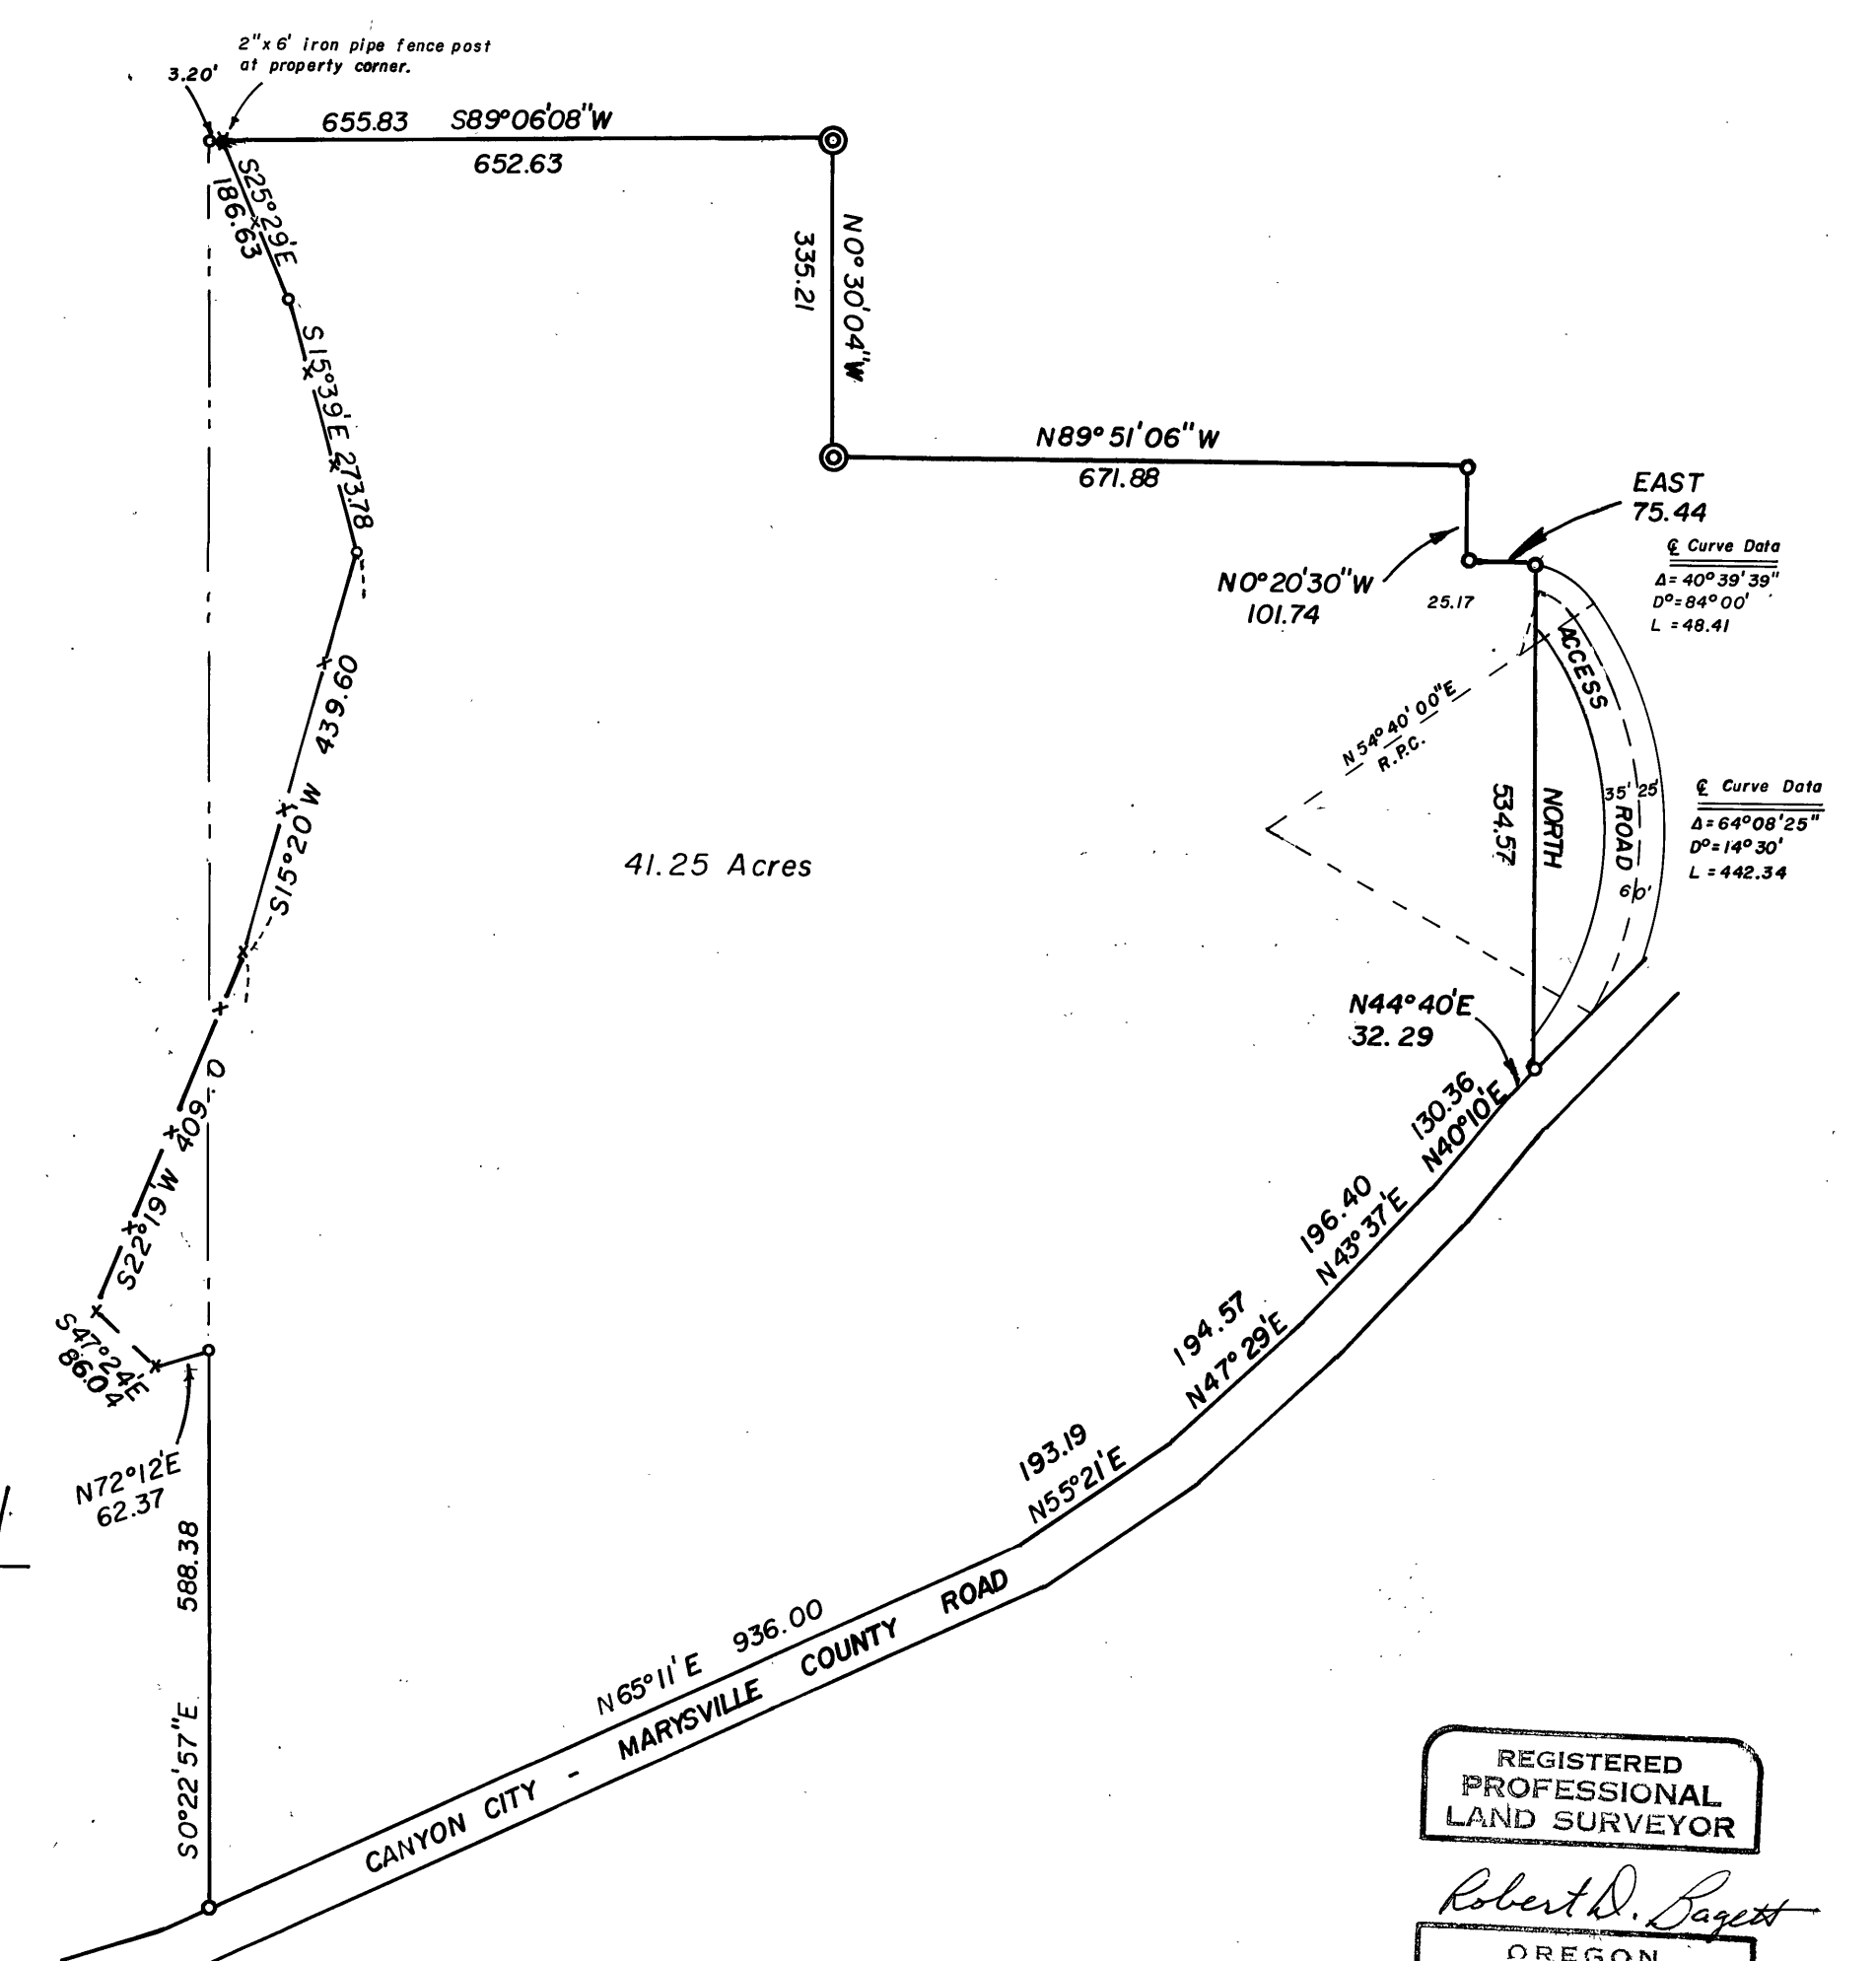

REGISTERED
PROFESSIONAL
LAND SURVEYOR
Robert D. Baggett
OREGON
JULY 12, 1963
ROBERT D. BAGGETT
598

BAGETT-GRIFFITH-FERGUSON		
Map of Survey		
A PARCEL OF LAND SITUATED IN THE E1/2 OF THE SE1/4 SEC. 35 & THE W1/2 OF THE SW1/4 SEC. 36		
T.13S., R.31E., W.M. GRANT COUNTY, OREGON		
SURVEYED FOR	MID-COUNTY CEMETERY DIST.	
SURVEYED BY	R.D.B. & J.D.B.	JULY, 72
Scale: 1"= 500'	Drawn by: J.D.B.	JULY, 72