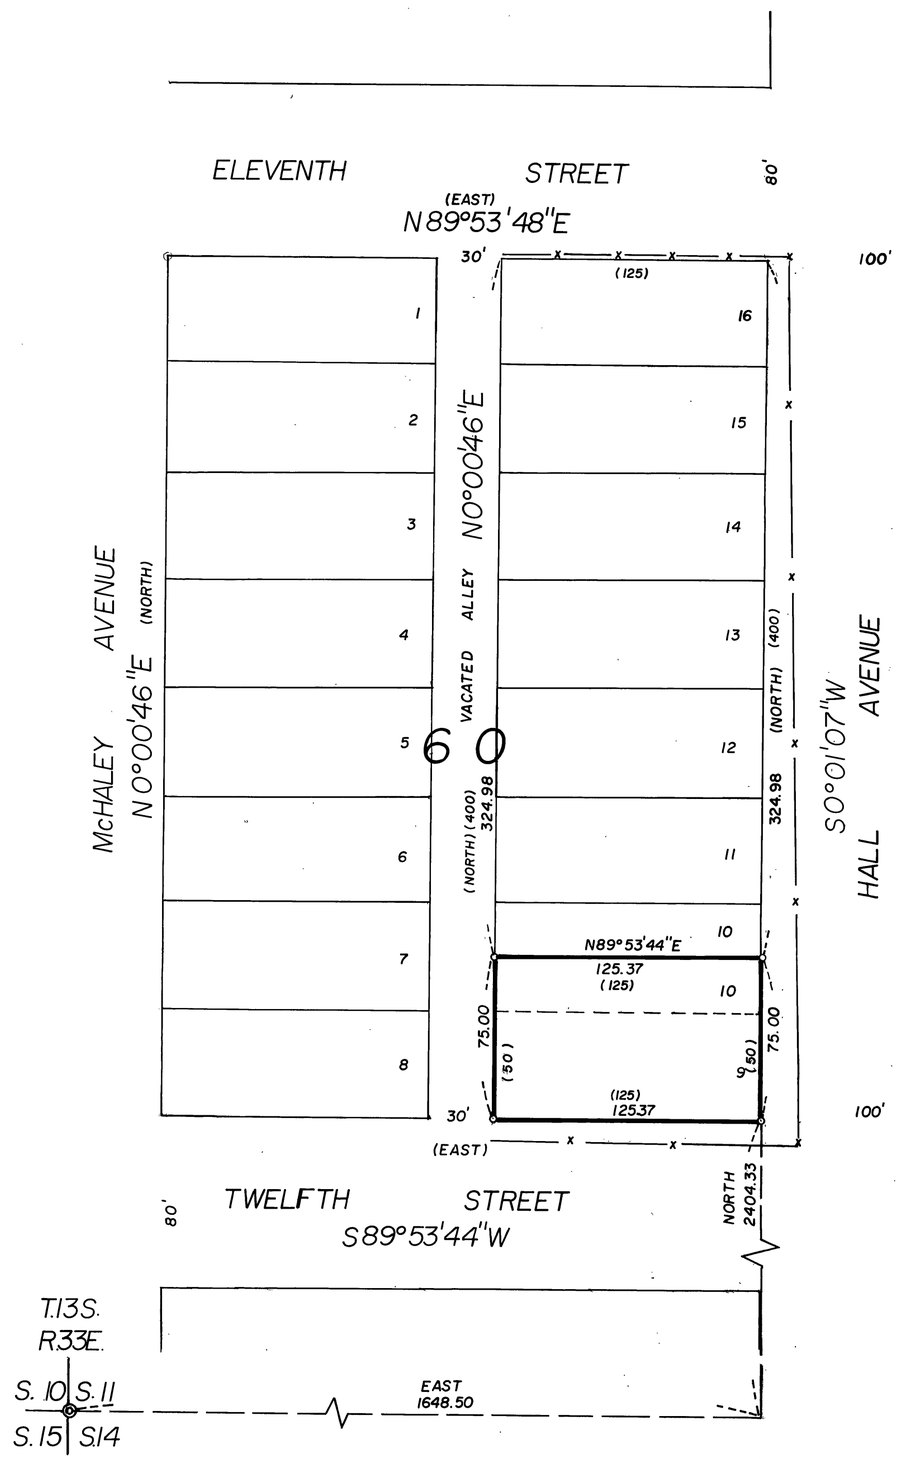

BASIS OF BEARINGS
SURVEY NO. 196

LEGEND

° SET 5/8" x 30" IRON PIN WITH PLASTIC CAP MARKED (BGF SURVEY MK)

—x— FENCE

( ) RECORD BEARING AND DISTANCE

REGISTERED PROFESSIONAL LAND SURVEYOR
Robert D. Bagett
OREGON
JULY 12, 1963
ROBERT D. BAGETT
598

RECEIVED AND FILED
OCT 16 1972
JOHN LIVEIRA, County Clerk
By _____ Deputy

BAGETT-GRIFFITH-FERGUSON
John Day, Oregon

Map of Survey

LOT 9 AND THE SOUTH HALF OF LOT 10
BLOCK 60, PRAIRIE CITY LAND CO. FIRST ADD.
PRAIRIE CITY,
GRANT COUNTY, OREGON

SURVEYED FOR	J. C. DREWETT	
SURVEYED BY	R.D.B. & J.D.B.	9/13/72
Scale: 1" = 50'	Drawn by: J.D.B.	9/14/72

Map Of Survey No 273