


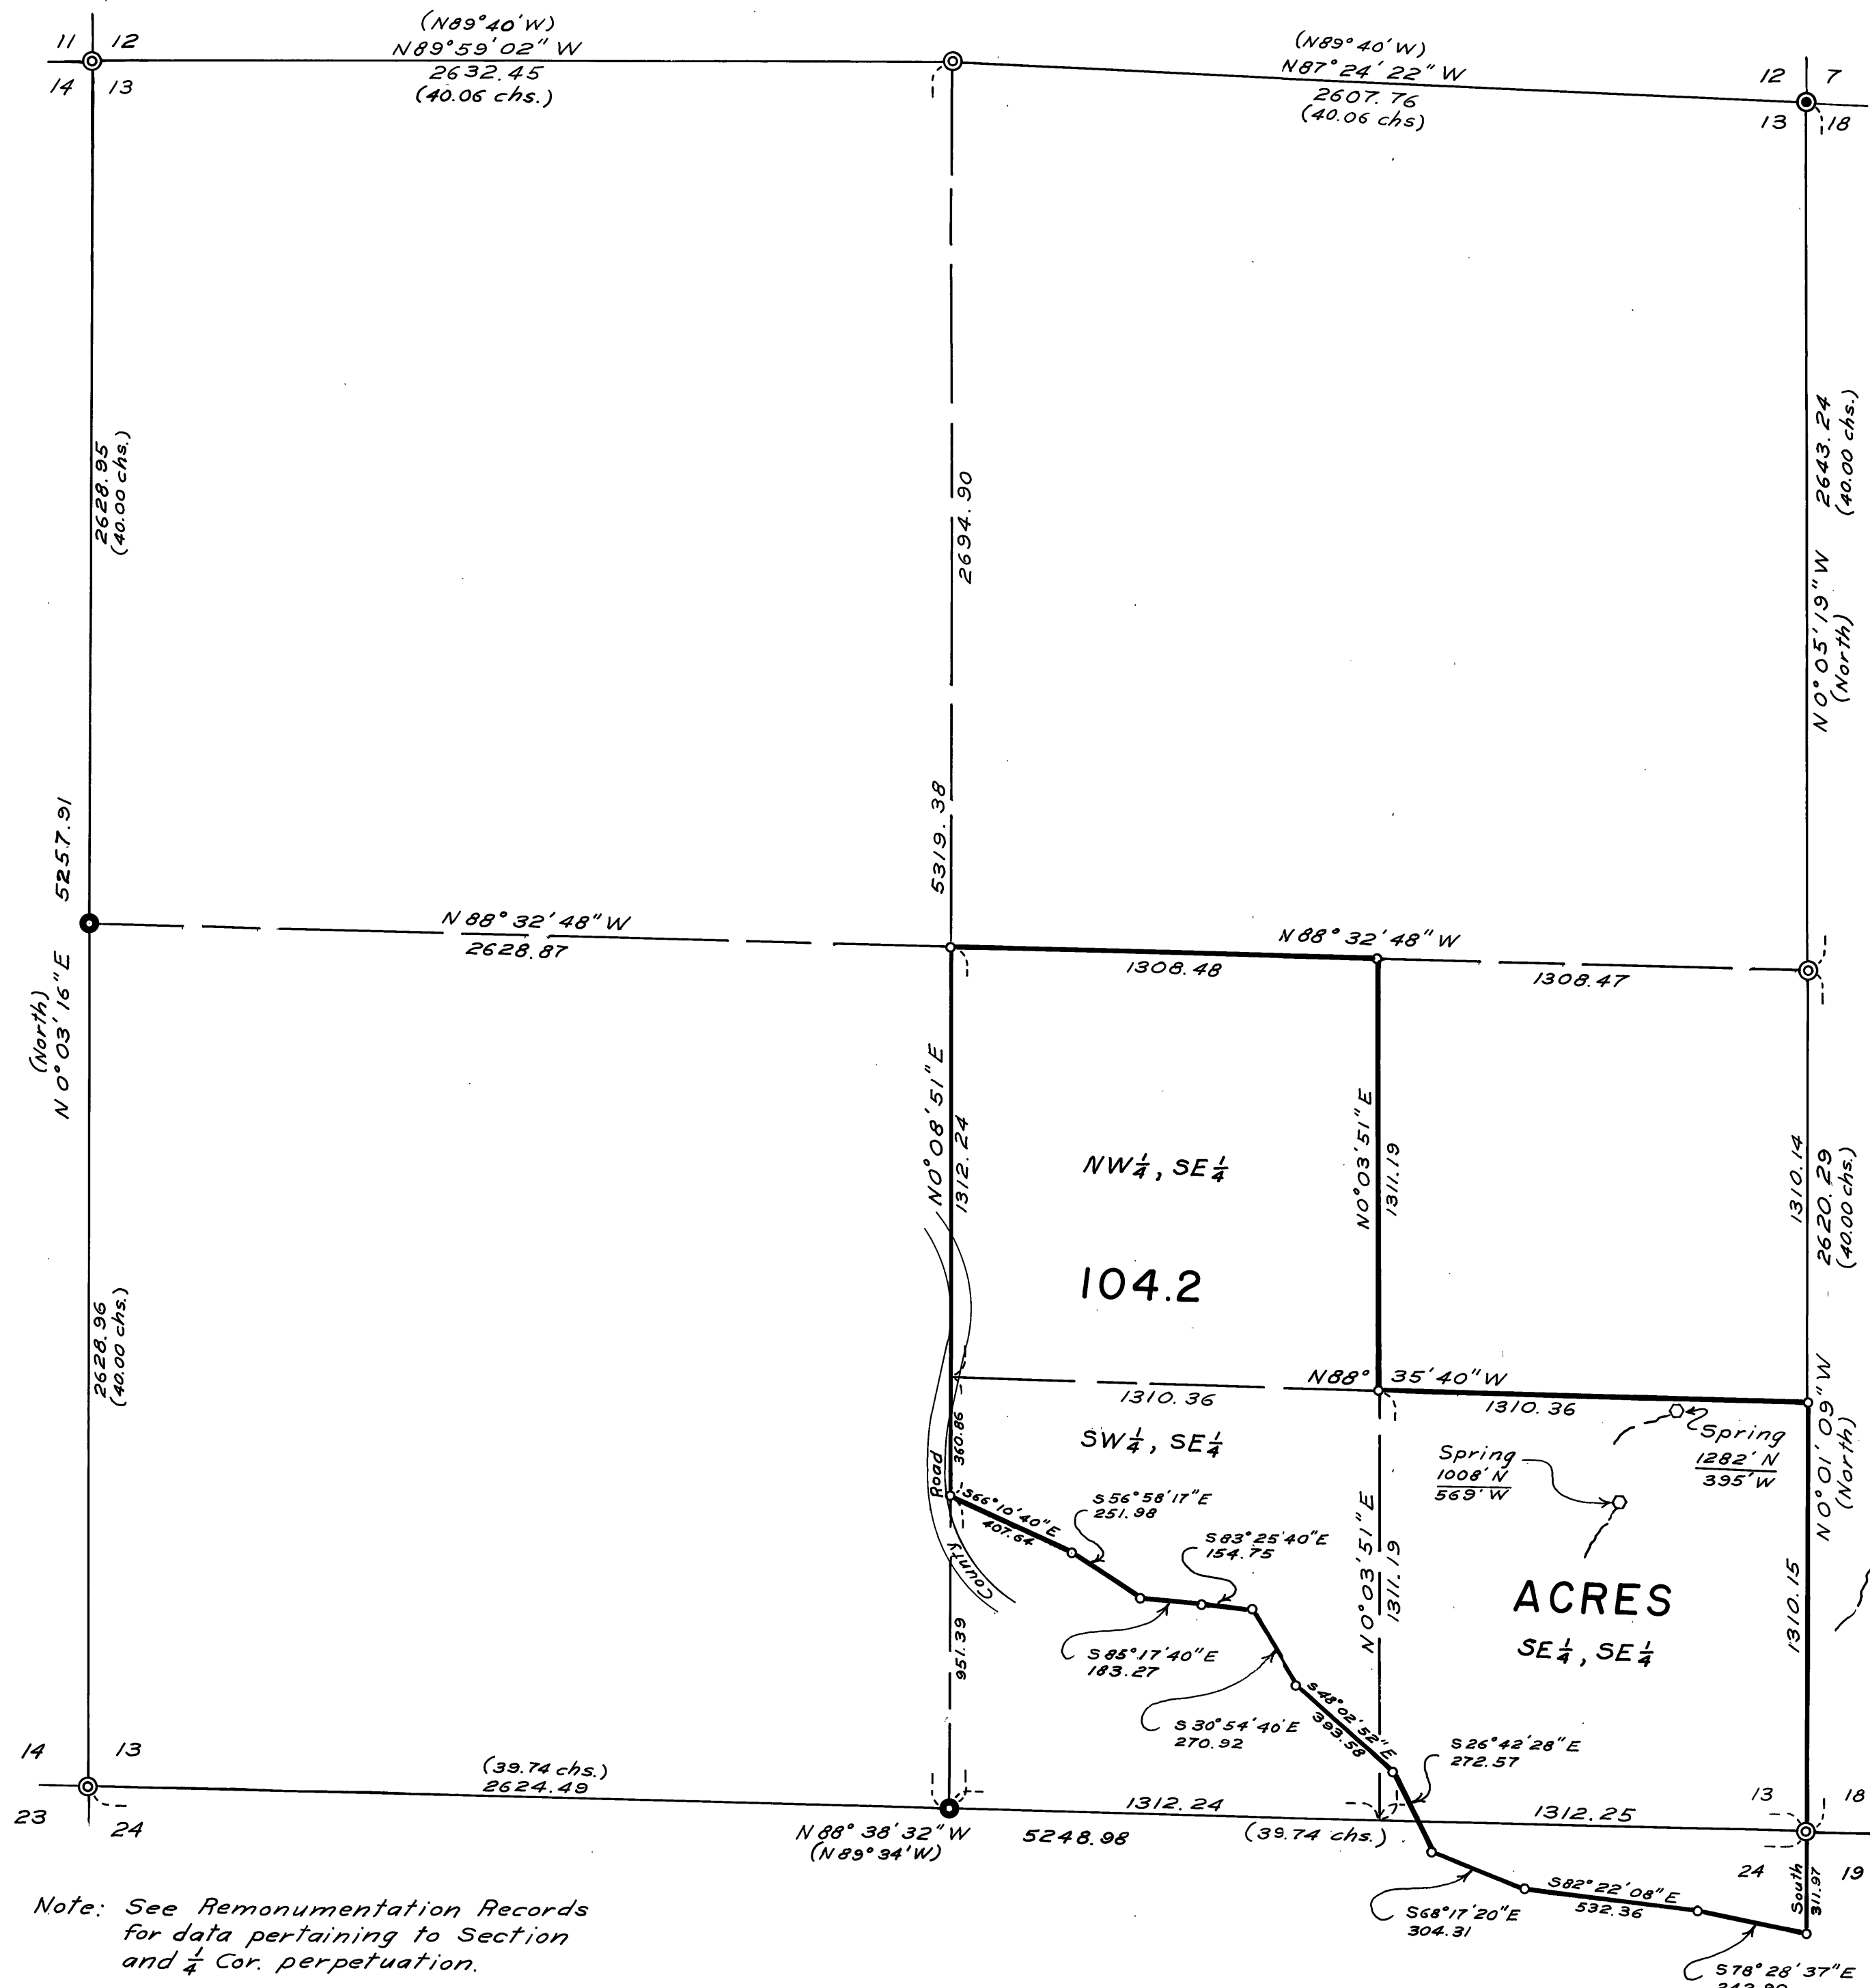

RECEIVED AND
FILED
JUL 13 1972
JOHN LIVERA, County Clerk
Deputy

BASIS OF BEARINGS
Solar Observation

LEGEND

- ⊙ Fd. Original Gov't. Corner
- ⊙ Fd. Original Gov't. Cor. - Set Brass Cap
- Set 1/4 Cor. at Proportionate Distance
- Set 5/8" x 30" Iron Pin with Attached Plastic Cap Marked "BGF Survey Mk"
- () Record Bearing and Distance

Note: Coordinates of
springs are ref-
erenced to the
SE Cor. of Sec. 13.

BAGETT-GRIFFITH-FERGUSON

John Day, Oregon

Map of Survey
Subdivision of Sec. 13 & Parcel
Situated in NW 1/4 SE 1/4; SW 1/4 SE 1/4; SE 1/4 SE 1/4
of Sec. 13 and in NE 1/4 NE 1/4 Sec. 24

T. 15 S., R. 31 E., W. M.
GRANT COUNTY, OREGON

SURVEYED FOR	Cliff Belcher	
SURVEYED BY	RDB	Sep 1972
Scale: 1" = 400'	Drawn by: RDB	Sep 1972

REGISTERED
PROFESSIONAL
LAND SURVEYOR

Robert D. Bagett

OREGON
JULY 12, 1963
ROBERT D. BAGETT
598