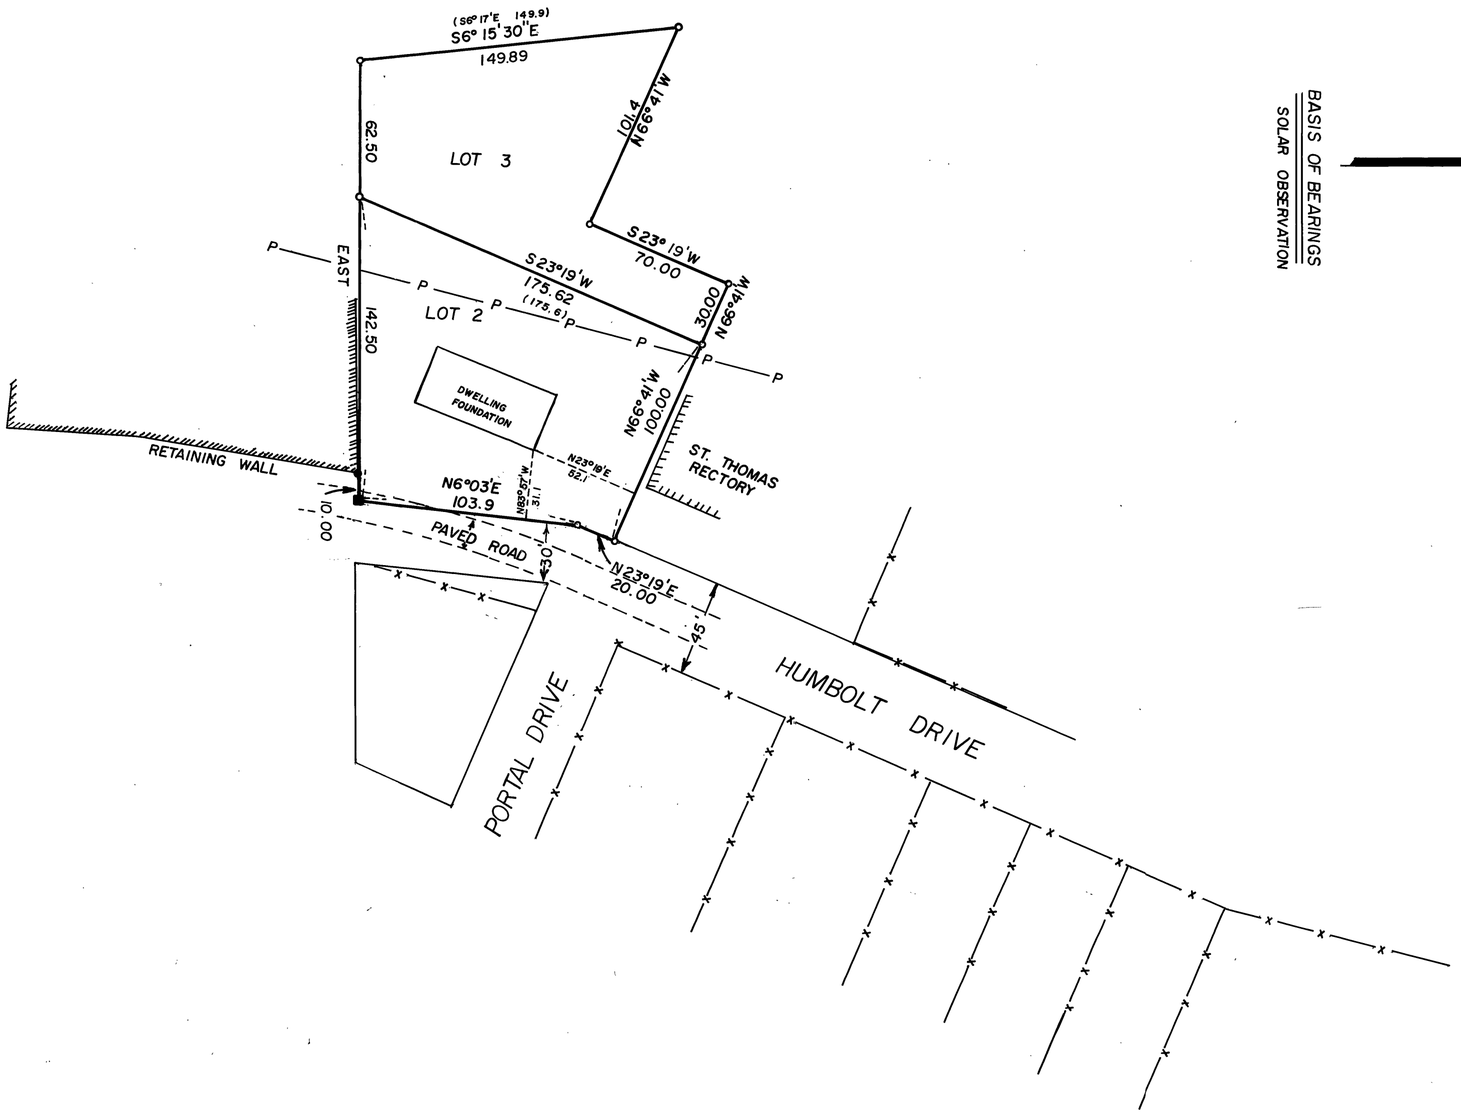

BASIS OF BEARINGS
SOLAR OBSERVATION

N

LEGEND

- o SET 5/8"x30" IRON PIN
- ■ SET RAILROAD SPIKE
- ● F.D. 1/4" IRON PIN
- x — x FENCE
- ( ) RECORD BEARING & DISTANCE
- —— P —— POWER LINE

RECEIVED AND FILED
DEC 12 1972
JOHN LIVEIRA, County Clerk
By [signature] Deputy

REGISTERED PROFESSIONAL LAND SURVEYOR
Robert D. Bagett
OREGON
JULY 12, 1963
ROBERT D. BAGETT
598

BAGETT-GRIFFITH-FERGUSON
John Day, Oregon

Map of Survey

LOTS 2 & 3 OF THE
HUMBOLT ADDITION TO
CANYON CITY
GRANT COUNTY, OREGON

SURVEYED FOR	DAN WALLENMEYER	
SURVEYED BY	R.D.B. & J.D.B.	11/72
Scale: 1" = 50'	Drawn by: J.D.B.	11/72

MAP OF SURVEY NO. 278