


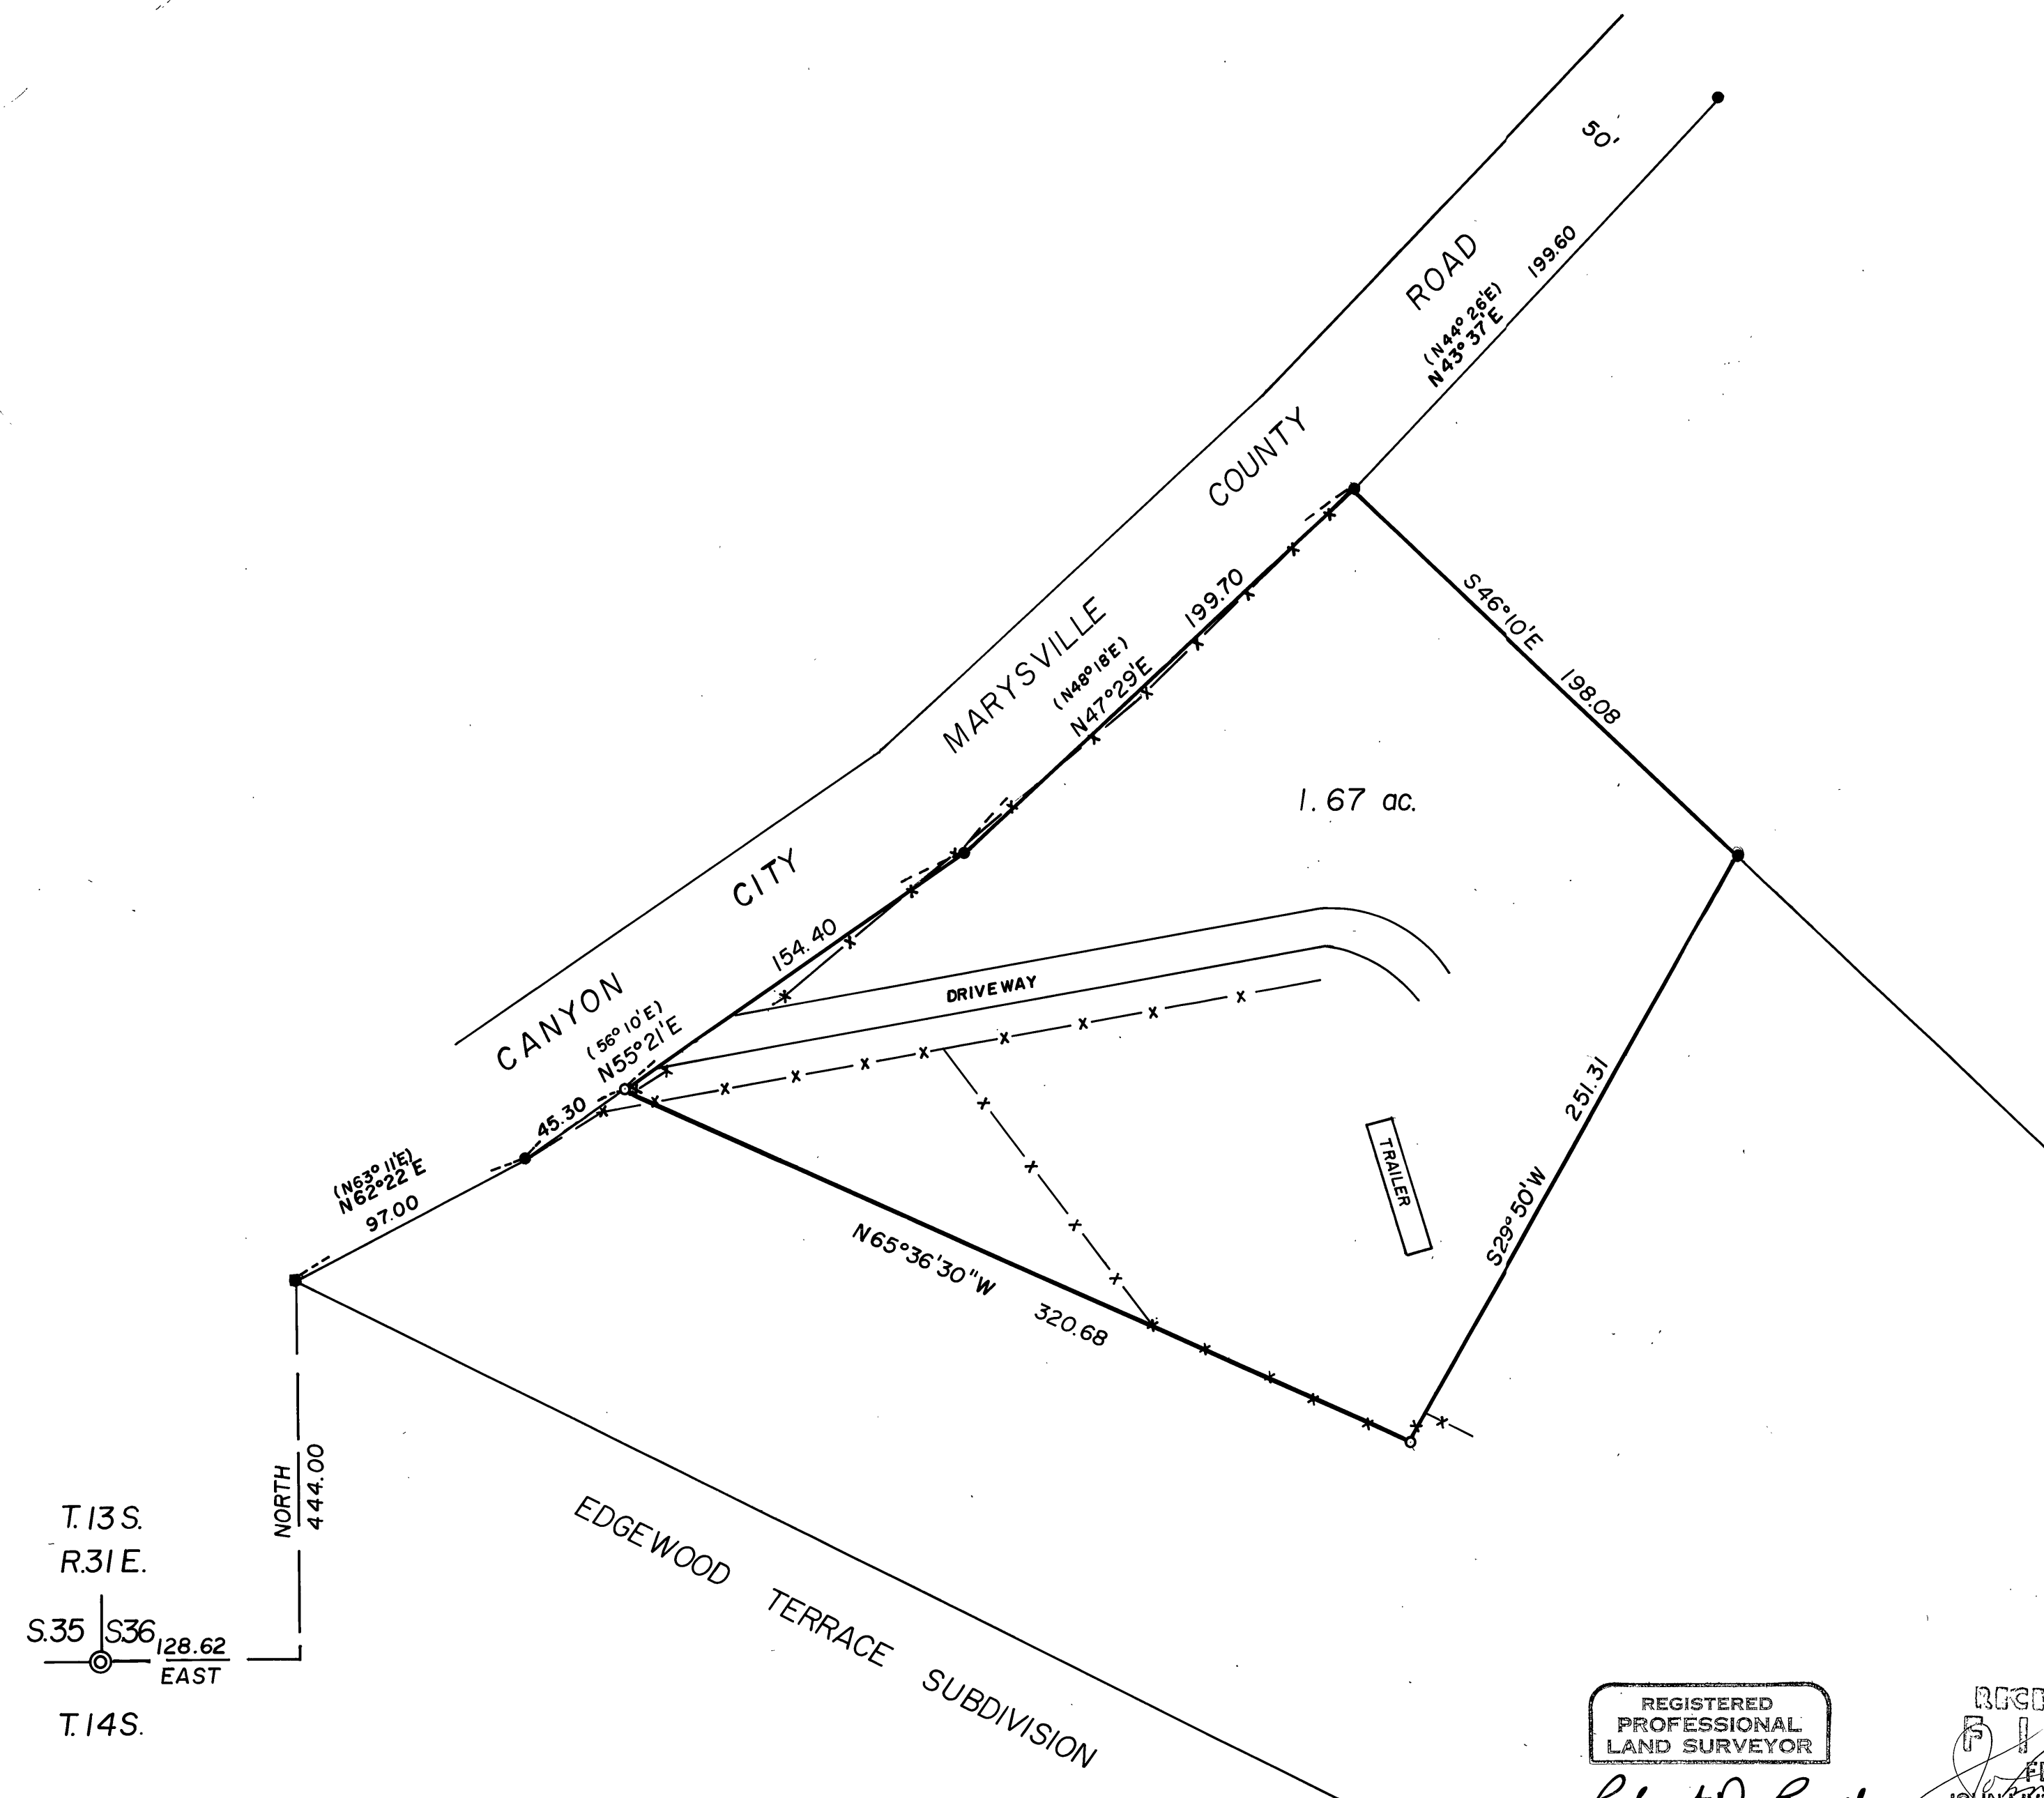

BASIS OF BEARINGS
solar observation

- LEGEND**
- SET 5/8"x30" IRON PIN
 - FD. PIN FROM SURVEY NO. 228
 - ⊙ FD. BRASS CAP
 - FD. LOT CORNER MONUMENTS OF EDGEWOOD TERRACE SUBDIVISION
 - () RECORD BEARING & DISTANCE

—x— FENCE

REGISTERED
PROFESSIONAL
LAND SURVEYOR
Robert D. Bagett
OREGON
JULY 12, 1968
ROBERT D. BAGETT
598

RECEIVED AND
FILED
FEB 26 1973
JOHN L. VANCE, County Clerk
GRANT COUNTY, OREGON

BAGETT-GRIFFITH-FERGUSON		
John Day, Oregon		
Map of Survey		
PARCEL OF LAND SITUATED IN THE SW 1/4 SW 1/4		
SEC. 36, T.13S., R.31E., W.M.		
GRANT COUNTY, OREGON		
SURVEYED FOR	FAY MADISON	
SURVEYED BY	R.D.B. & J.D.B.	12/11/72
Scale: 1"= 50'	Drawn by: J.D.B.	12/12/72