


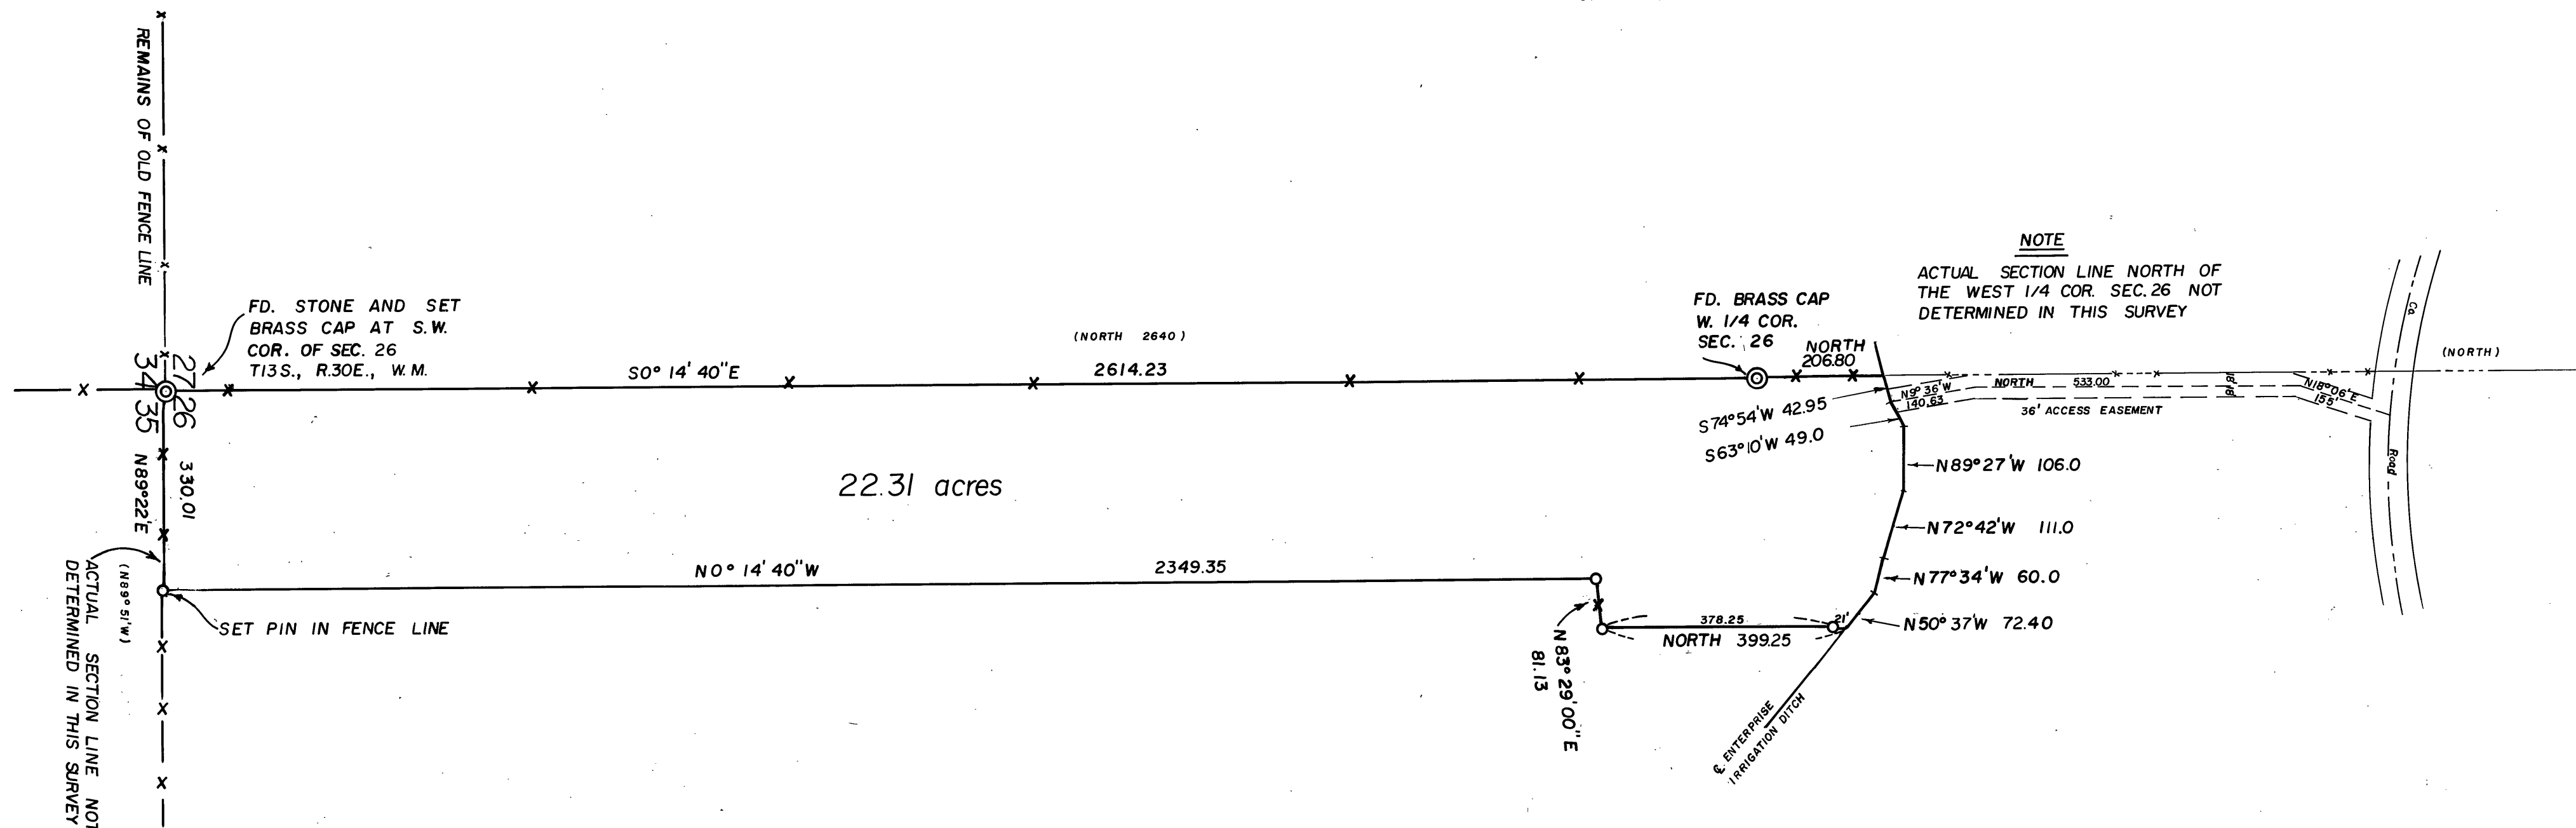


BASIS OF BEARINGS
solar observation



LEGEND

- SET 5/8" x 30" IRON PIN WITH PLASTIC CAP MARKED B G F SURVEY MK

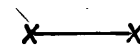

FENCE

- () RECORD BEARING & DISTANCE

REGISTERED
PROFESSIONAL
LAND SURVEYOR

Robert D. Baggett
OREGON
JULY 12, 1965
ROBERT D. BAGGETT
598

RECEIVED AND
FILED

MAR 2 11 1973
JOHN LIVERA, County Clerk
By *Betty D. Dwyer*

BAGETT-GRIFFITH-FERGUSON

John Day, Oregon

Map of Survey

A PARCEL OF LAND SITUATED IN THE W 1/2 OF
SECTION 26, TWP. 13 S., R30E. WM.

GRANT COUNTY, OREGON

SURVEYED FOR	S. SKIDGEL & P.G. ULIBARRI	
SURVEYED BY	R.D.B. & J.D.B.	3/8/73
Scale: 1" = 200'	Drawn by: J.D.B.	3/9/73