
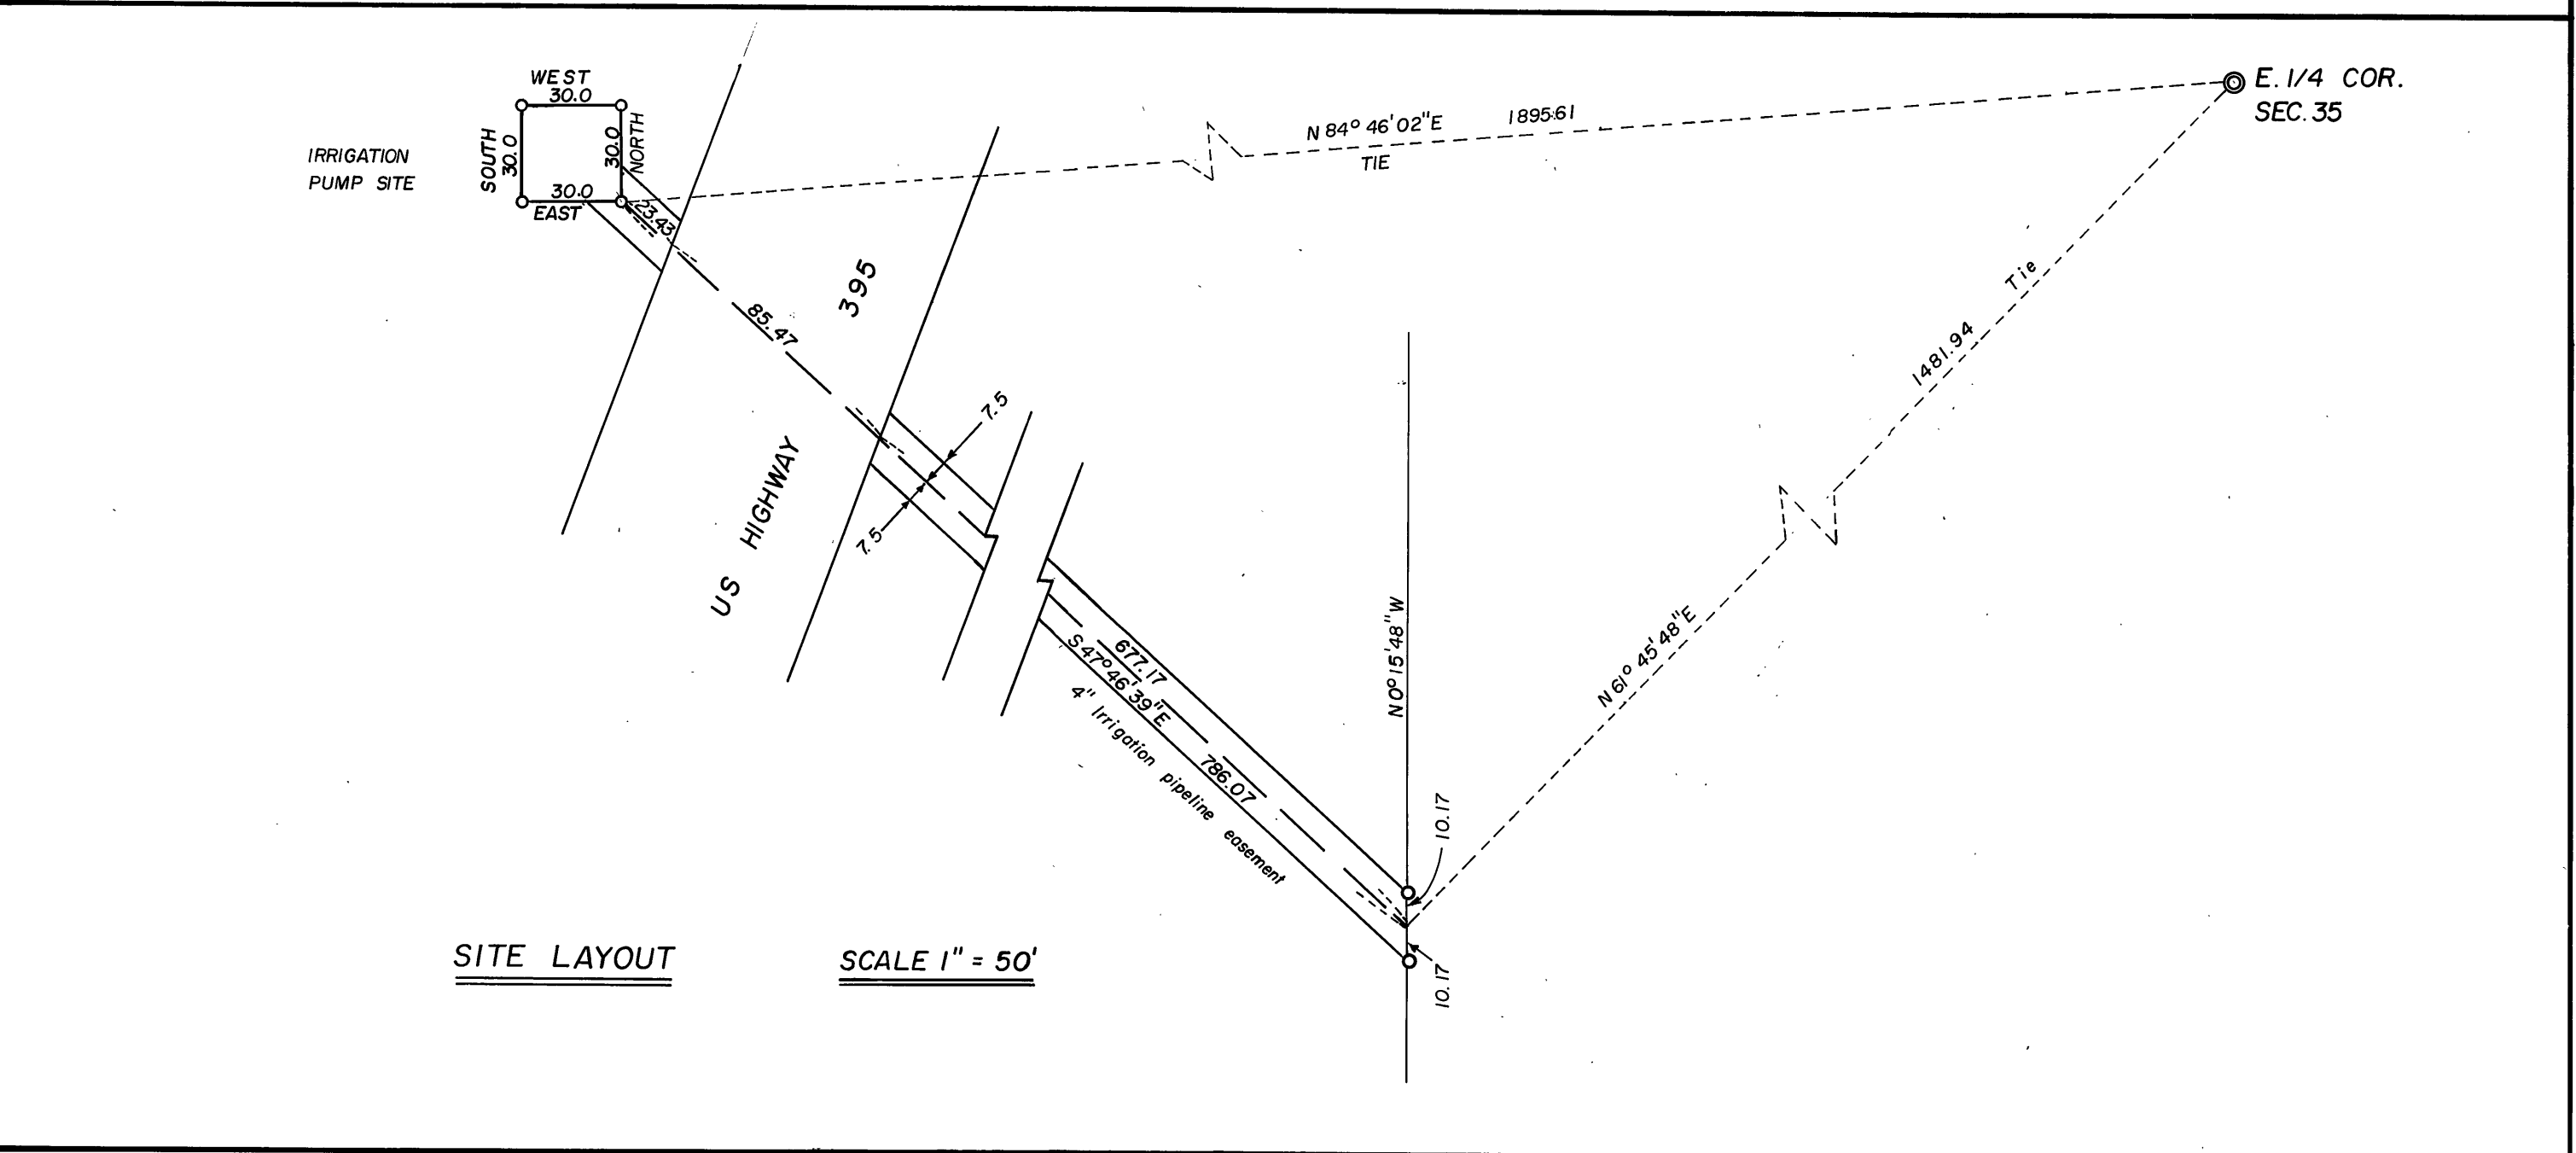


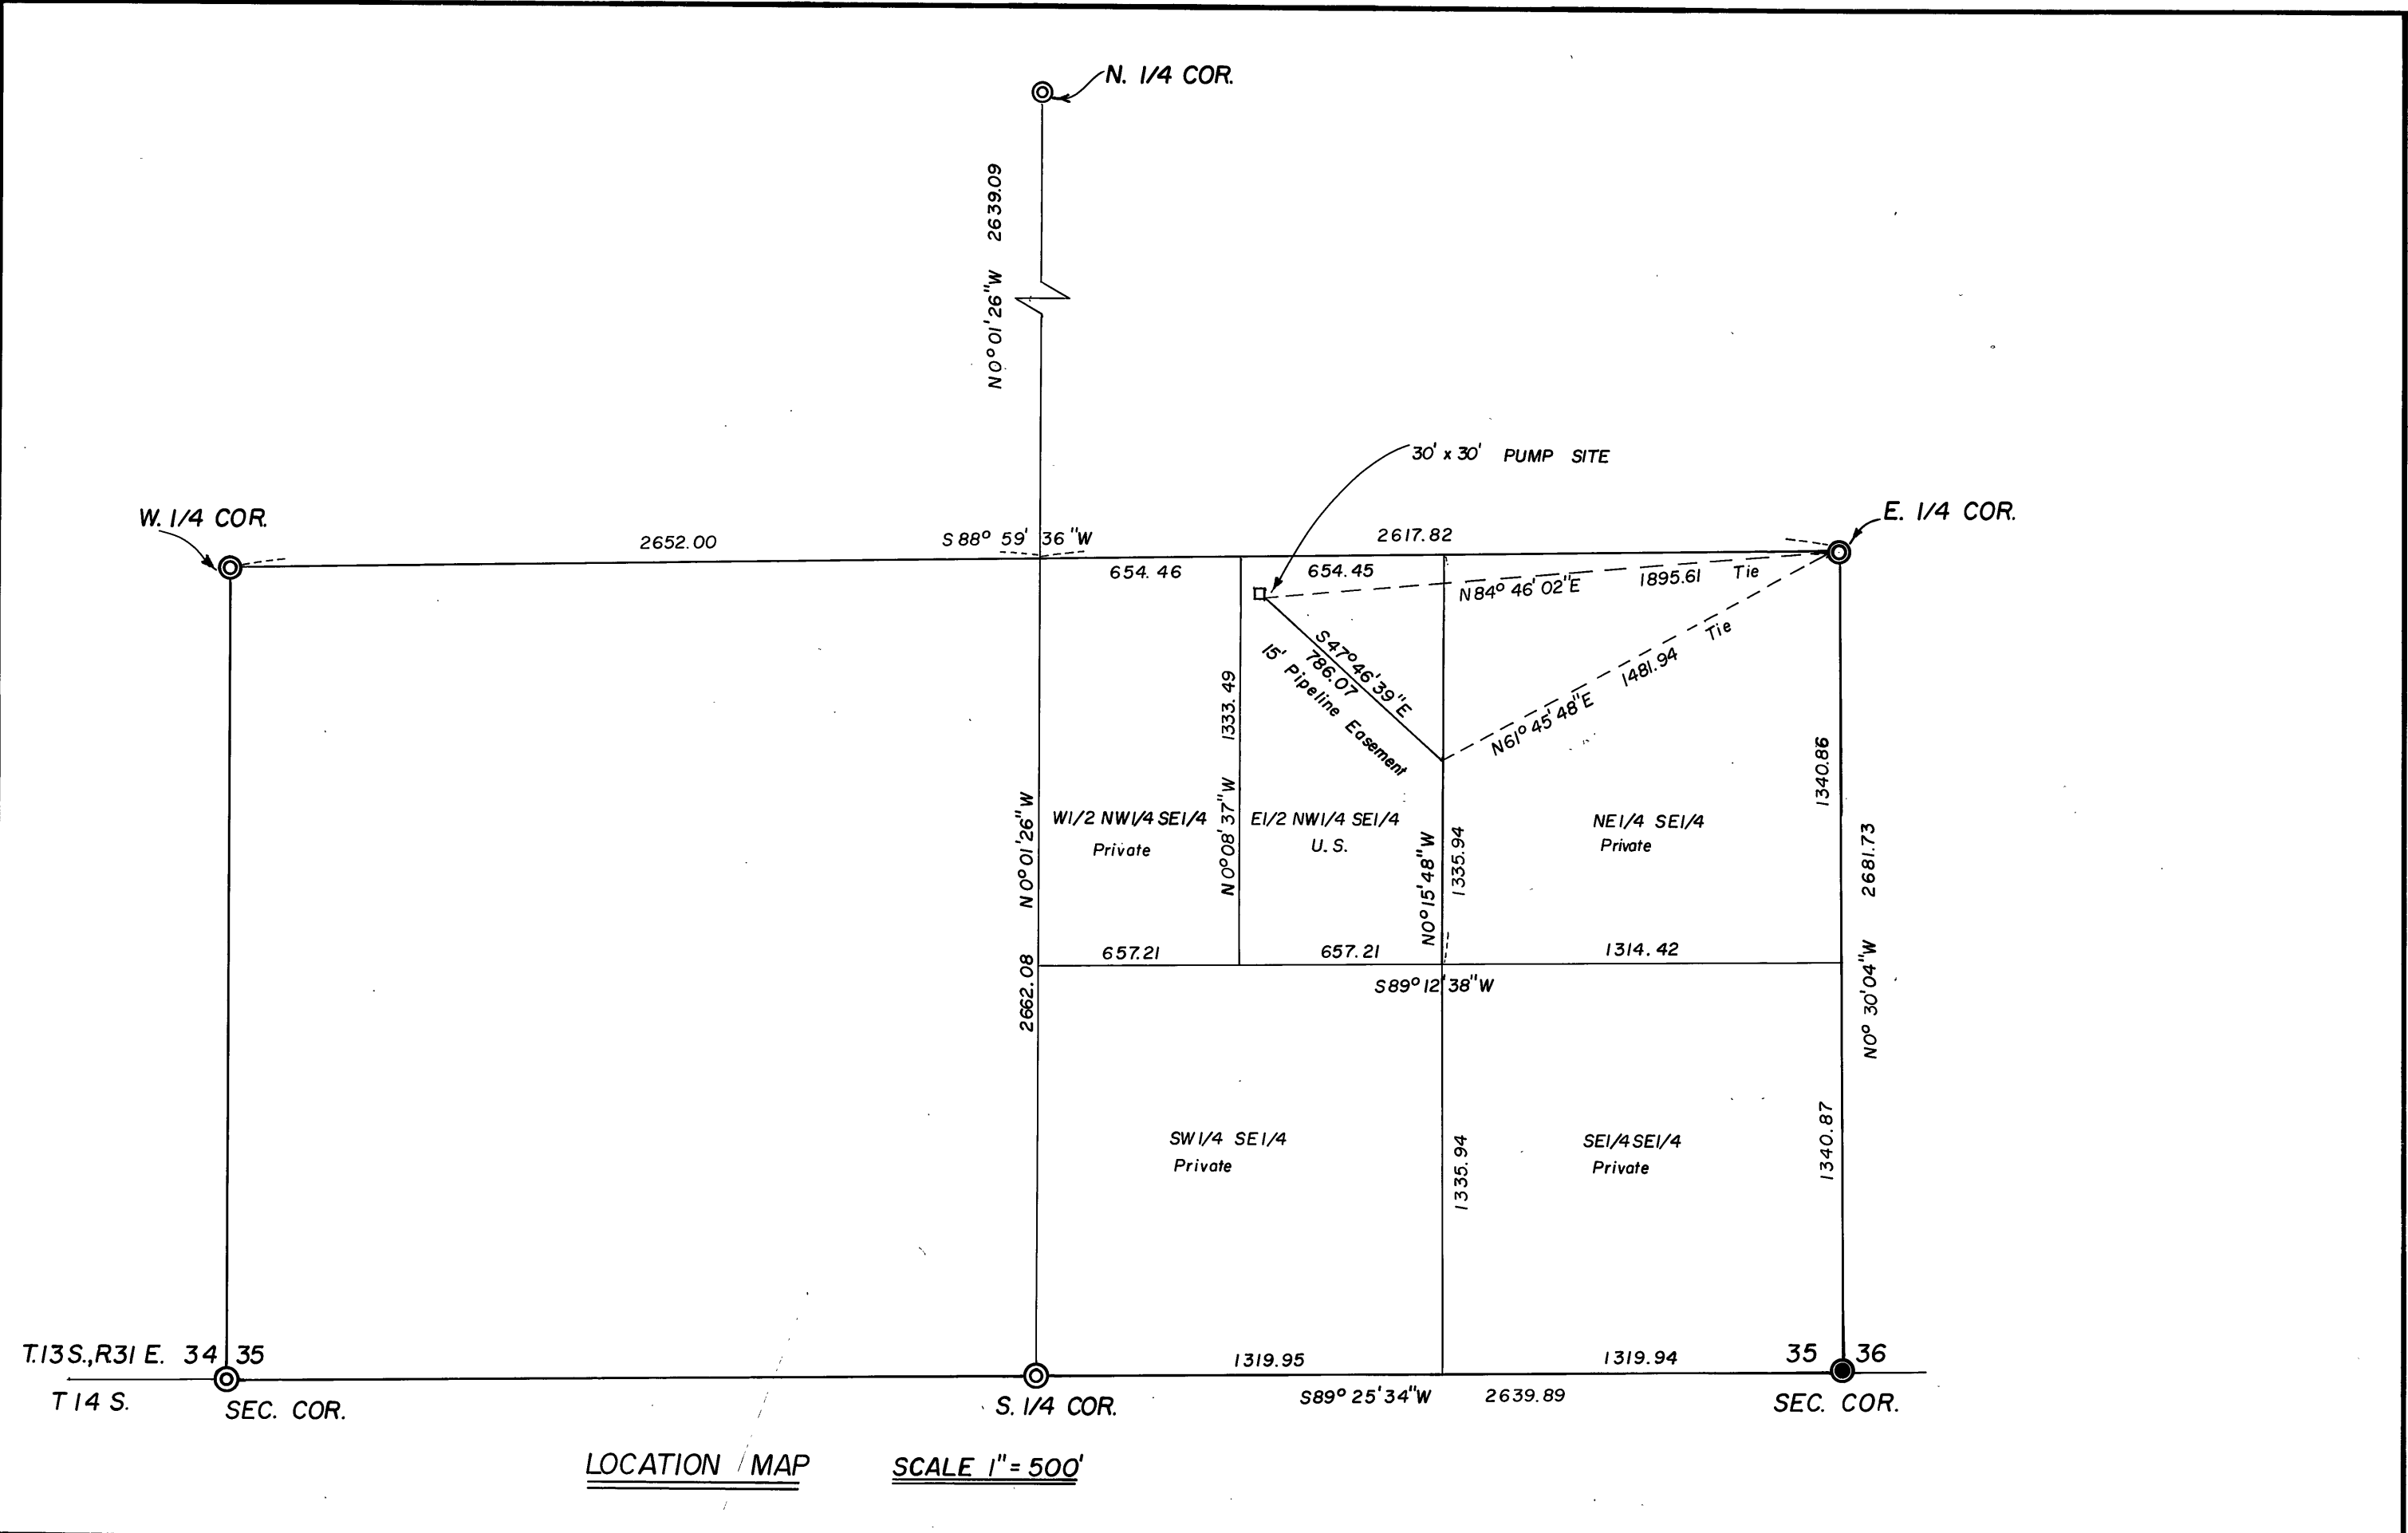

BASIS OF BEARINGS
solar observation

- LEGEND**
- SET 5/8" x 30" IRON PIN
 - F.D. BLM BRASS CAP
 - COUNTY SURVEYOR BRASS CAP

RECEIVED AND
FILED
JUL 26 1973
JOHN D. BAGETT
COUNTY CLERK

REGISTERED
PROFESSIONAL
LAND SURVEYOR

Robert D. Bagett
OREGON
JULY 12, 1963
ROBERT D. BAGETT
598

BAGETT-GRIFFITH-FERGUSON		
John Day, Oregon		
Map of Survey		
RIGHT-OF-WAY APPLICATION MAP OF		
IRRIGATION PUMP SITE AND PIPELINE EASEMENT		
CANYON CITY		
GRANT COUNTY, OREGON		
SURVEYED FOR	MID COUNTY CEMETERY DISTRICT	
SURVEYED BY	R.D.B. & J.D.B.	3/26/73
Scale:	Drawn by: J.D.B.	3/27/73