
TOWNSHIP 14 SOUTH, RANGE 31 EAST, OF THE WILLAMETTE MERIDIAN, OREGON.

SURVEY OF TRACT 38

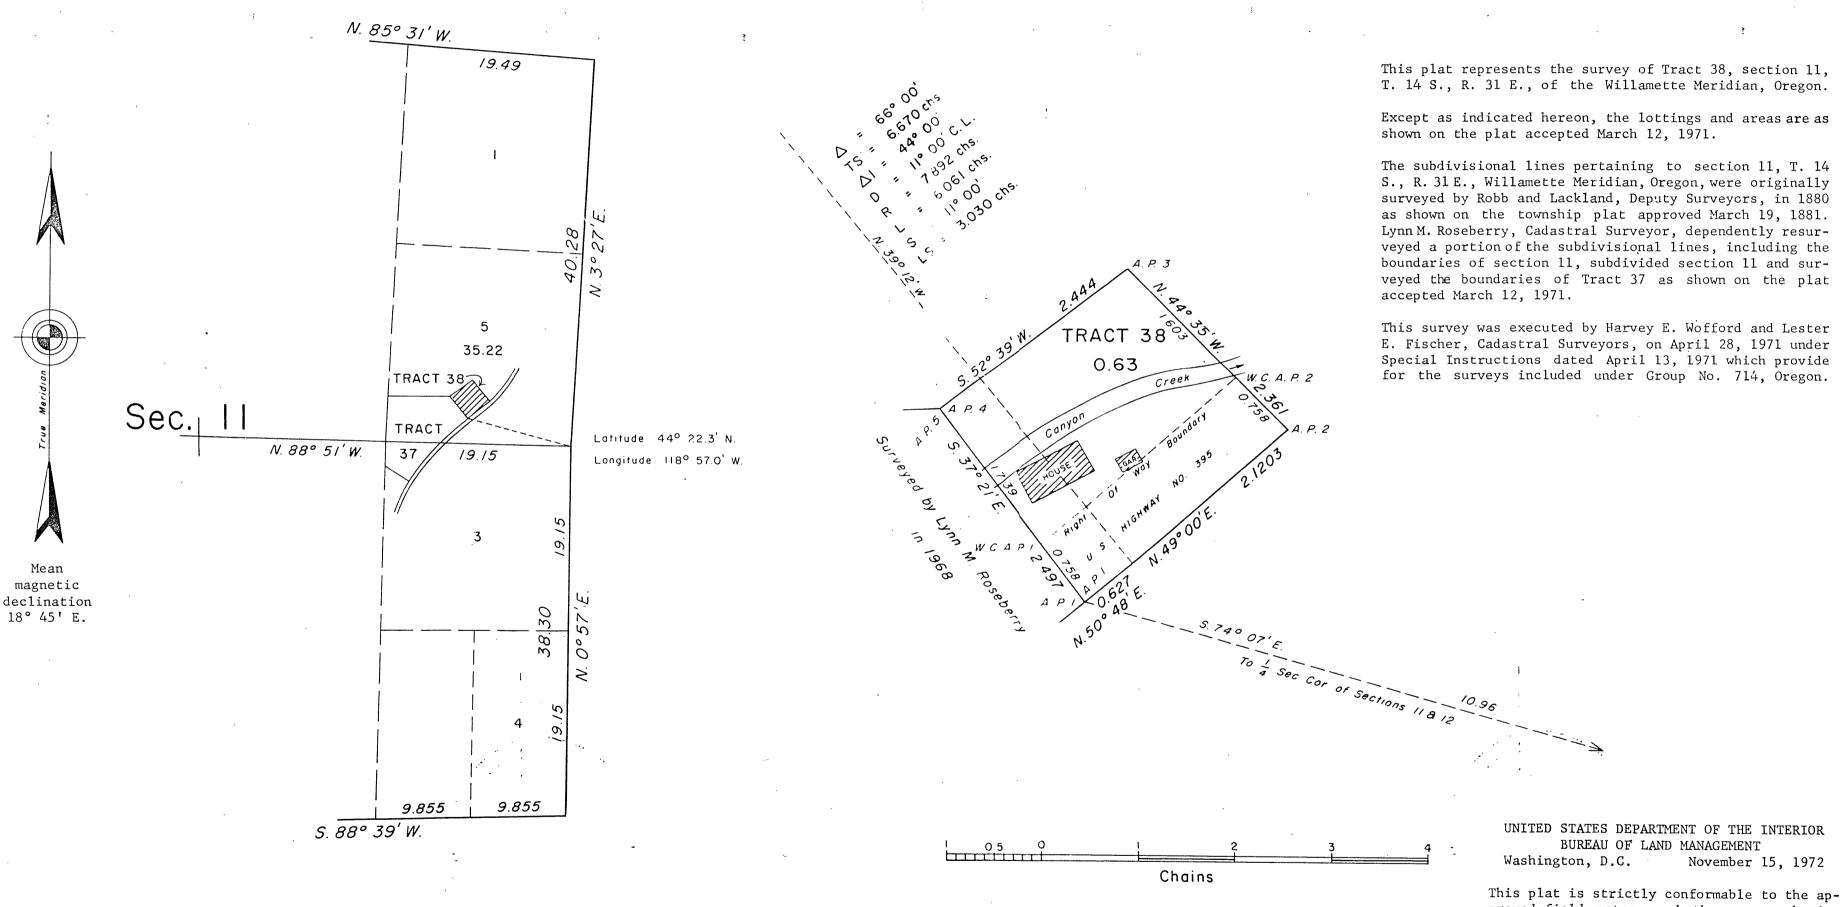

Timber in this area consists of cottonwood.

RECEIVED AND

PR25/973

JOHN LIVEIRA, County Clerk

By Denty

This plat is strictly conformable to the approved field notes, and the survey, having been correctly executed in accordance with the requirements of law and the regulations of this Bureau, is hereby accepted.

For the Director

Clark I Summ

Chief, Division of Cadastral Survey