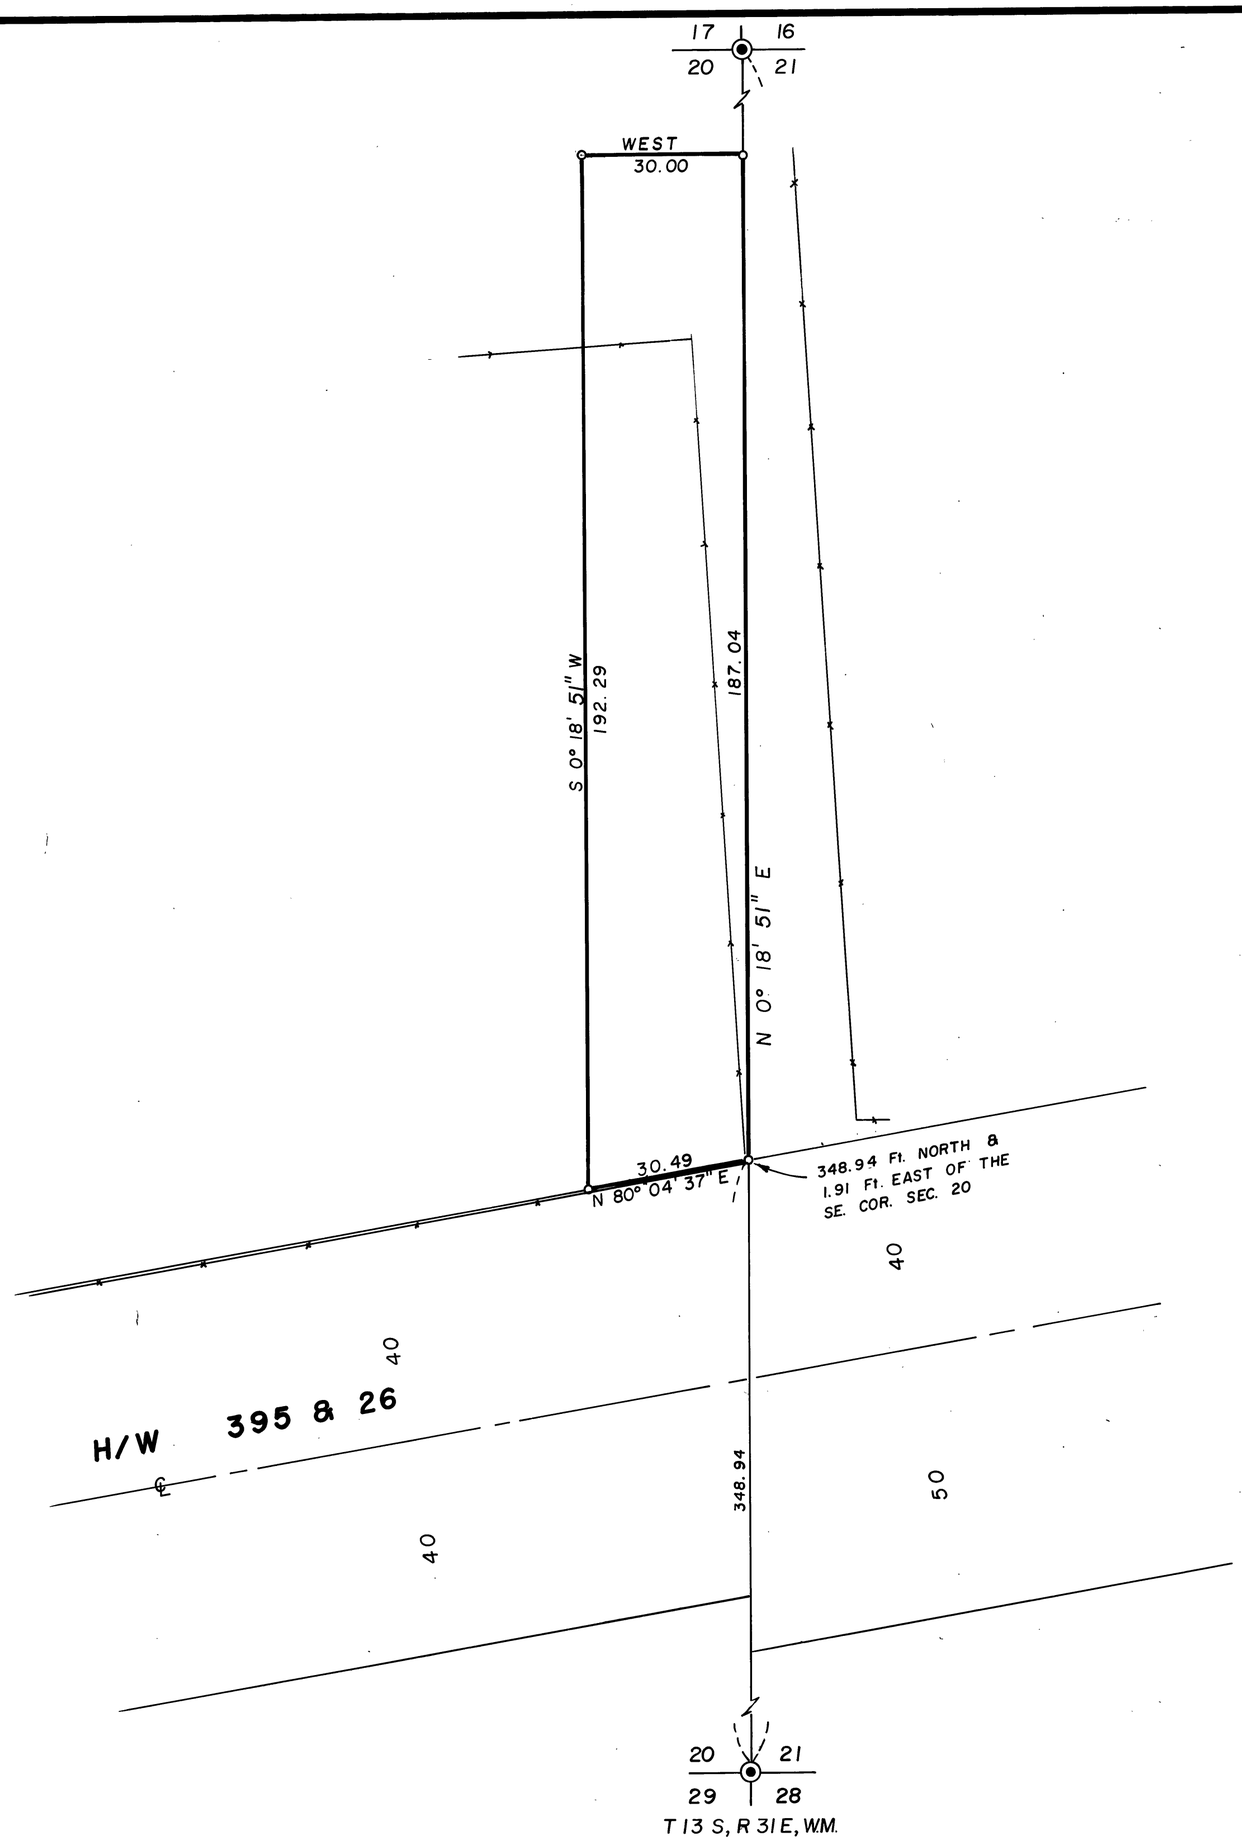

BASIS OF BEARING
Solar Observation

RECEIVED AND
FILED
MAY 8 1973
JOHN OIVEIRA, County Clerk
By Betty Lowery Deputy

REGISTERED
PROFESSIONAL
LAND SURVEYOR

Robert D. Bagett
OREGON
JULY 13, 1965
ROBERT D. BAGETT
598

LEGEND

- Fd. monument of record
- Set 5/8"x30" iron pin
- Existing fence

BAGETT-GRIFFITH-FERGUSON
John Day, Oregon

Map of Survey
Parcel in the S.E. 1/4 of the S.E. 1/4
Section 20
T 13 S, R 31 E, W.M.
GRANT COUNTY, OREGON

SURVEYED FOR	Grant County Road Department	
SURVEYED BY	R.D.B.	APR. 1973
Scale: 1" = 20'	Drawn by: D.I.G.	APR. 1973

Map of Survey No. 298