


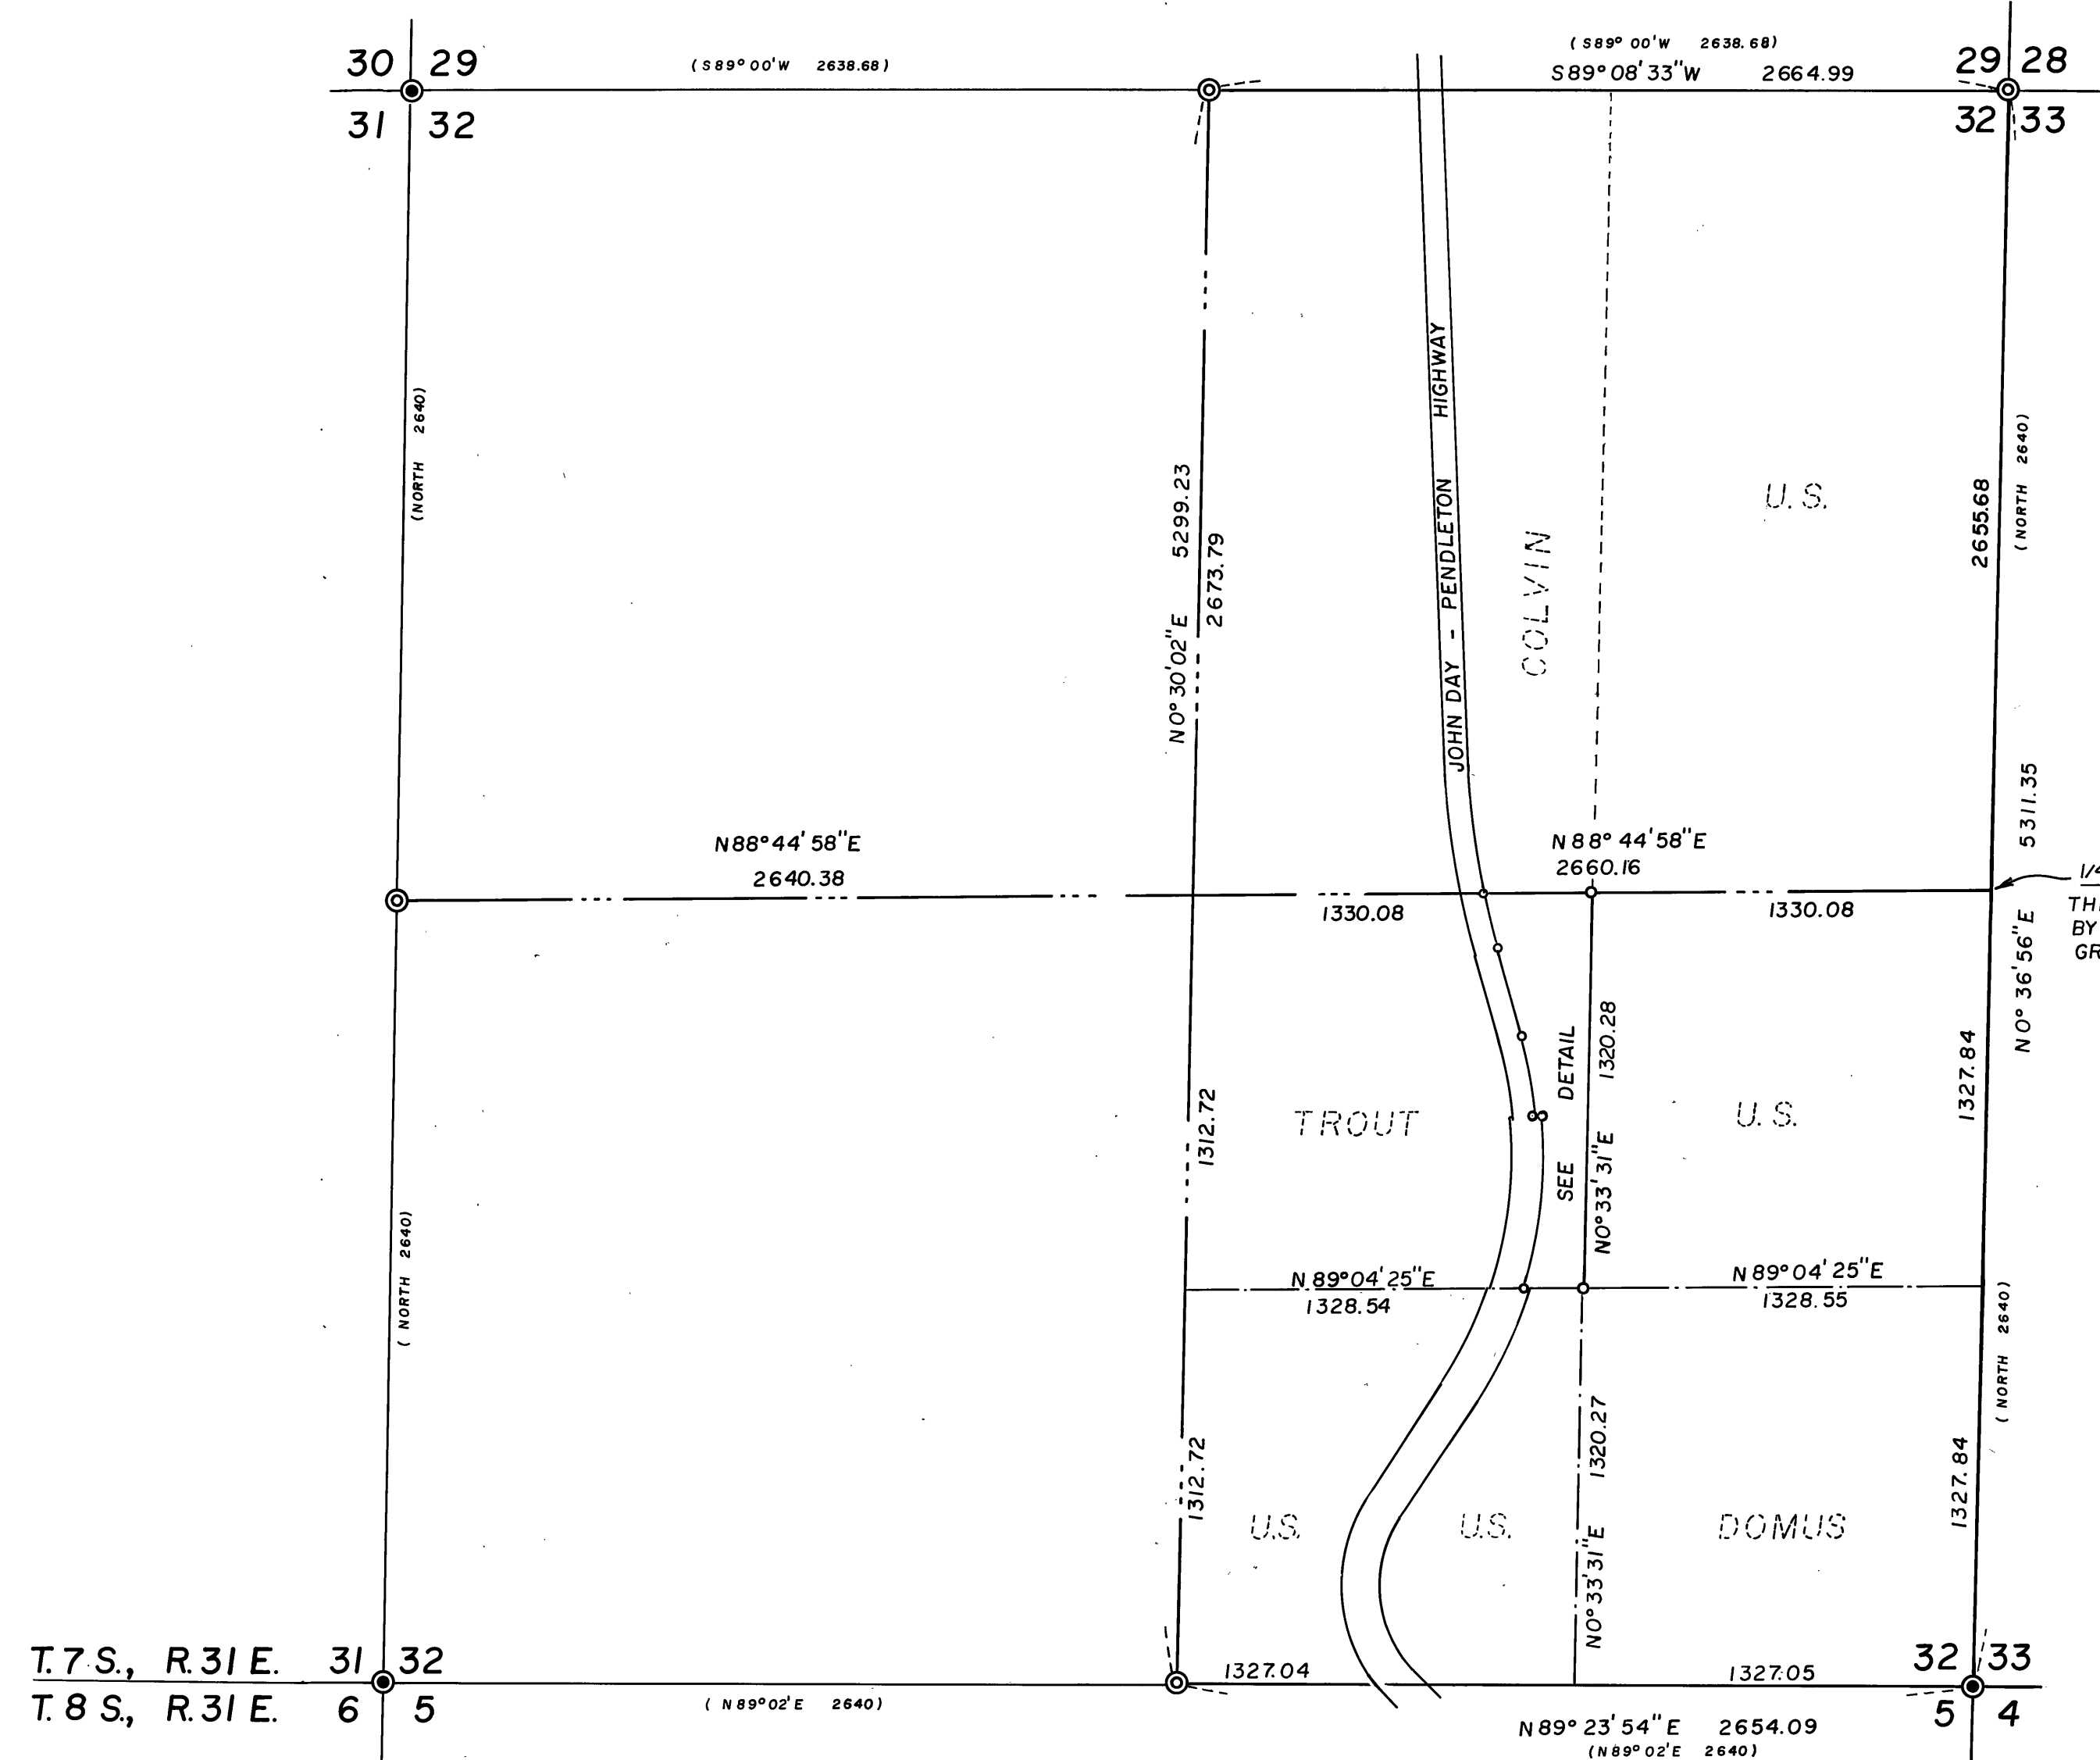

SCALE 1" = 500'

LEGEND

- FD. BRASS CAP MONUMENT OF RECORD
- SET BRASS CAP MONUMENT
- SET 5/8"x 30" IRON PIN, WITH ATTACHED, PLASTIC CAP MARKED BGF SURVEY MK
- RECORD BEARING AND DISTANCE

— FENCE

NOTE:

SEE RECORDED CORNER REMONUMENTATION SHEETS FOR DESCRIPTION OF MONUMENTS AND BEARING TREES AT SECTION CORNERS


REFERENCE MATERIAL

OREGON STATE HIGHWAY DEPT. DRAWING NO. 58-33-19
GRANT COUNTY DEEDS BOOK 39 PAGE 418
" " " " 87 PAGE 103

REGISTERED
PROFESSIONAL
LAND SURVEYOR

ROBERT D. BAGETT
598

SCALE 1" = 100'

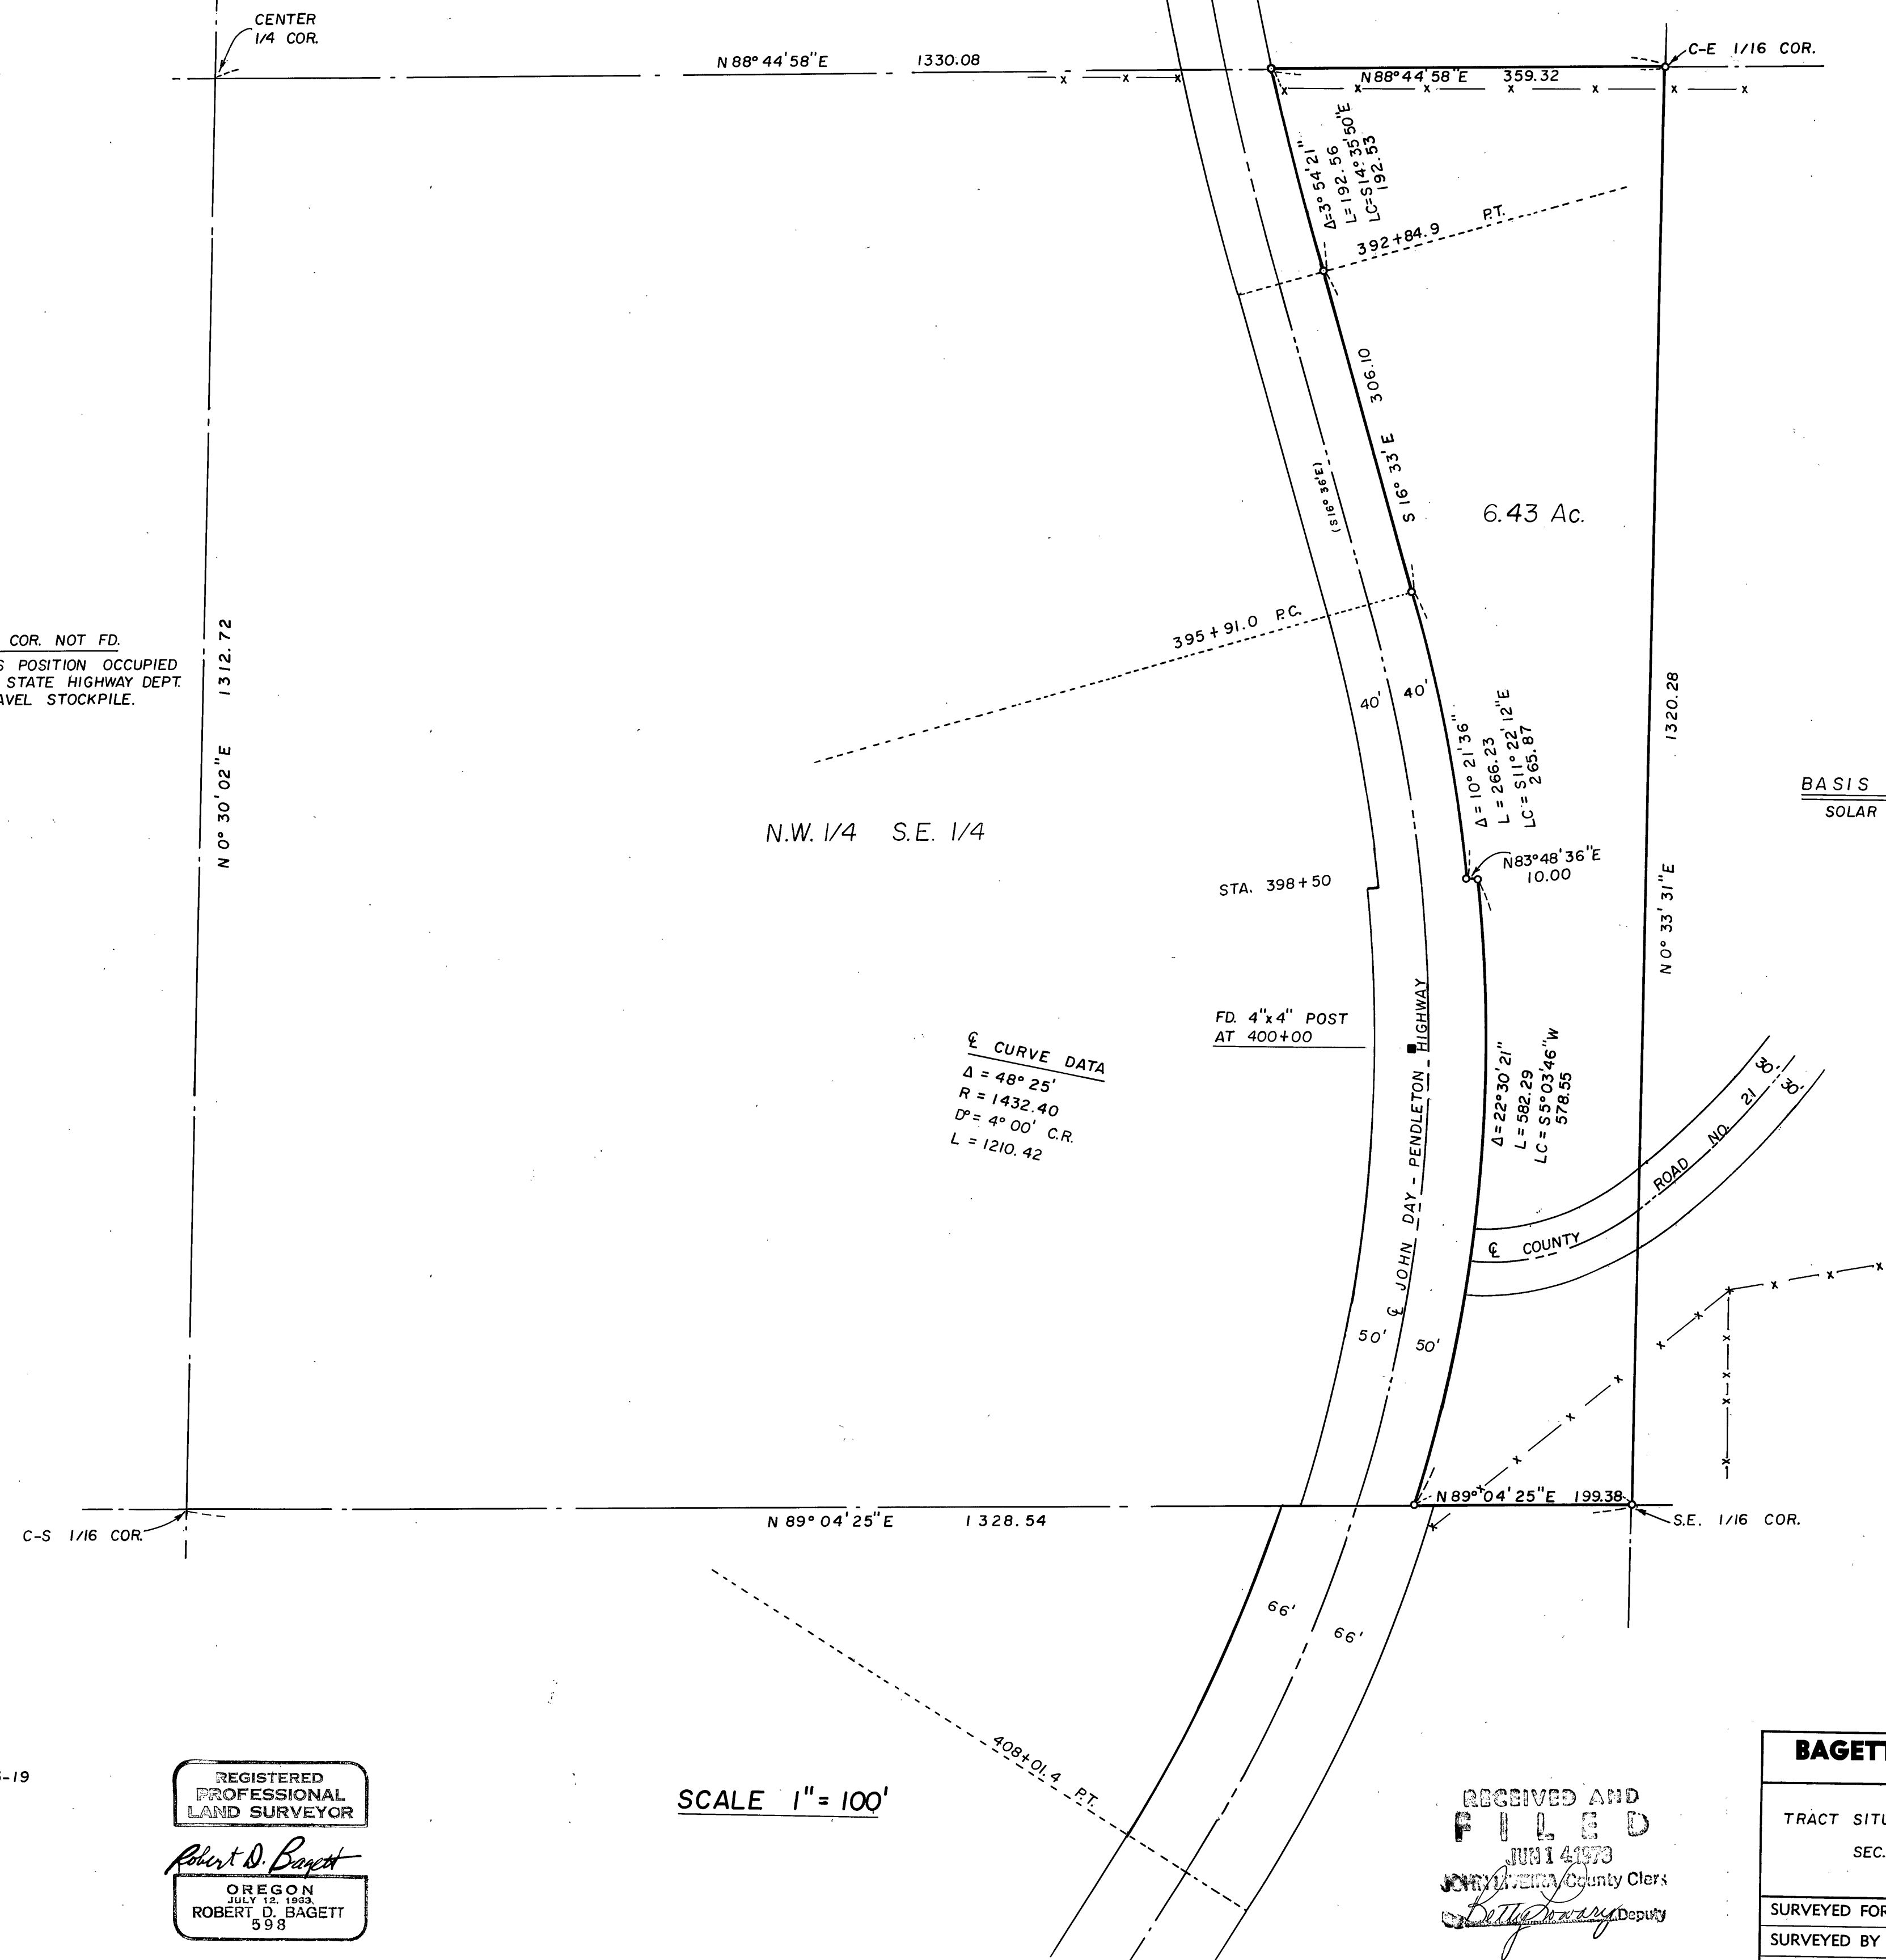

Q CURVE DATA
Δ = 13° 45'
R = 2864.79
D = 2° 00' C.L.
L = 687.50

Q CURVE DATA
Δ = 48° 25'
R = 1432.40
D = 4° 00' C.R.
L = 1210.42

RECEIVED AND
FILED
JUN 14 1973
Deputy

BAGETT-GRIFFITH-FERGUSON			
John Day, Oregon			
Map of Survey			
TRACT SITUATED IN THE E. 1/2 NW 1/4 SE 1/4			
SEC. 32, T. 7 S., R. 31 E., W. 4			
GRANT COUNTY, OREGON			
SURVEYED FOR	JOHN JORDEN		
SURVEYED BY	R.D.B. - D.I.G.-D.M.F.-J.D.B.		
Scale:	Drawn by: R.D.B.	5/73	