


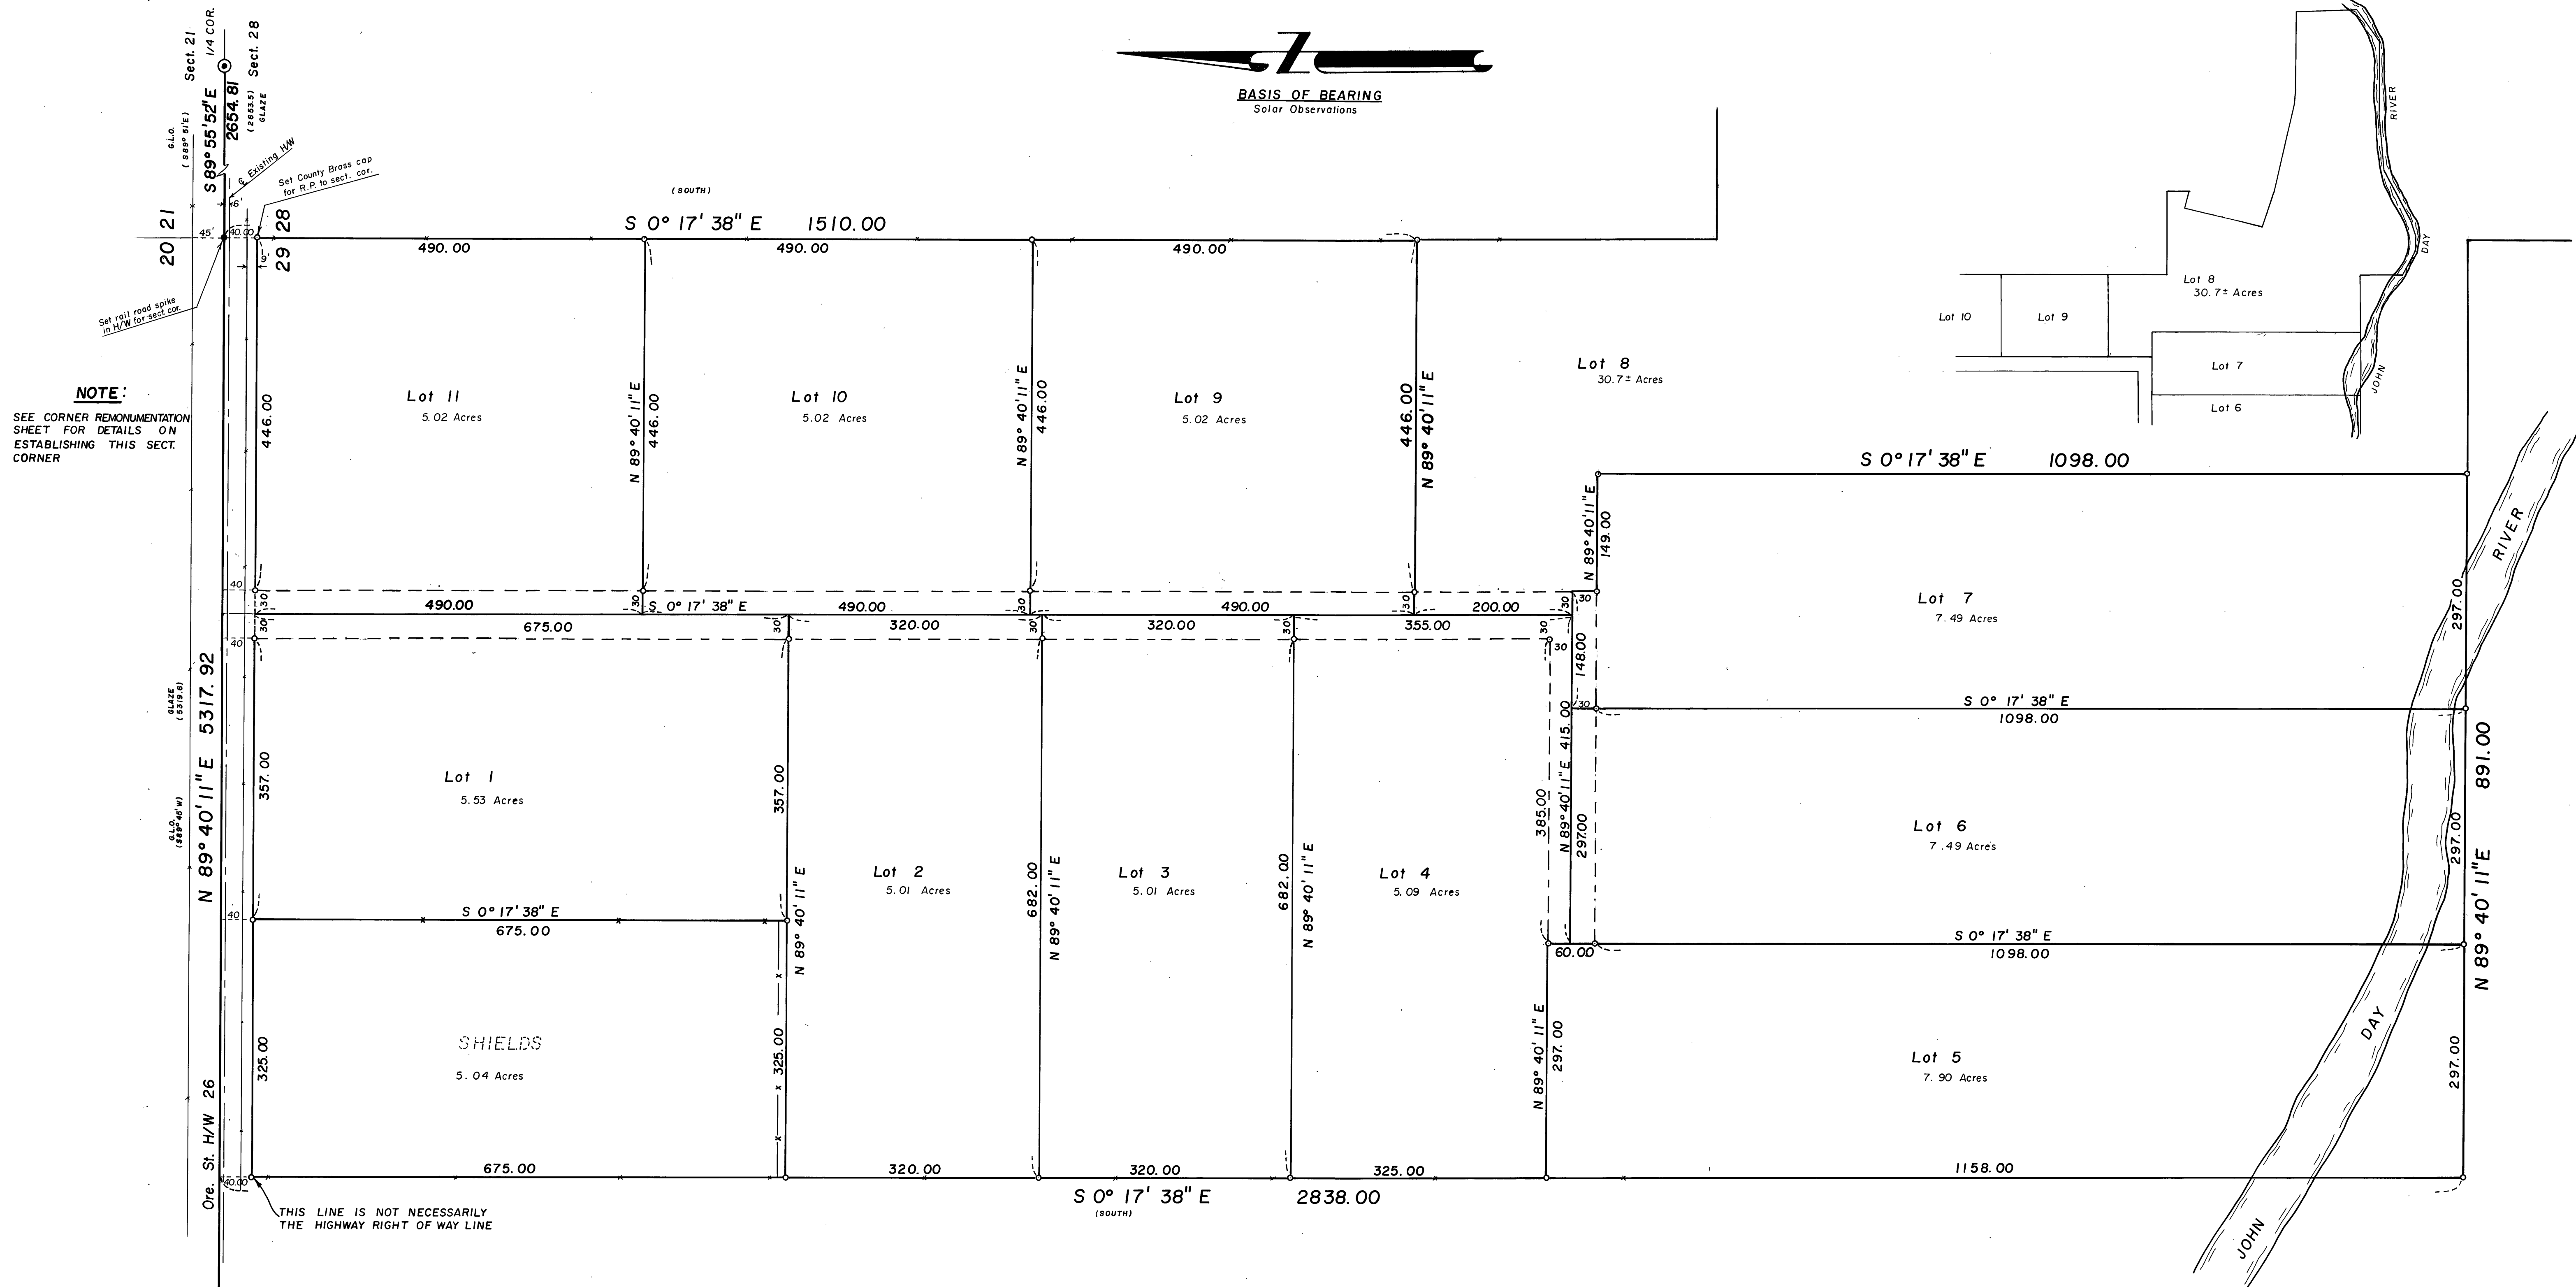

BASIS OF BEARING
Solar Observations



NOTE:

SEE CORNER REMONUMENTATION
SHEET FOR DETAILS ON
ESTABLISHING THIS SECT.
CORNER

LEGEND

- ⊙ FD. MONUMENT OF RECORD
- SET 5/8" x 30" IRON PIN
UNLESS OTHERWISE NOTED
- () RECORD BEARING & DISTANCE
- FENCE

REFERENCE MATERIAL

GLAZE SURVEY OF 1914
GLO NOTES
SURVEY NO. 294
" " 118
DEED VOL. 108 PAGE 735

NOTE

ACREAGE ON EACH LOT EXCLUDES
THAT PORTION INSIDE THE EASEMENT

REGISTERED
PROFESSIONAL
LAND SURVEYOR

Robert D. Baggett
OREGON
JULY 12, 1963
ROBERT D. BAGGETT
598

RECEIVED AND
FILED
JUN 14 1973
JOHN LIVERA, County Clerk
BAGETT-GRIFFITH-FERGUSON

BAGETT-GRIFFITH-FERGUSON			
John Day, Oregon			
Map of Survey			
PARCEL IN THE			
E. 1/2 OF THE NE 1/4			
SECTION 29			
T.3S., R.30E., W.M.			
GRANT COUNTY, OREGON			
SURVEYED FOR	STAN KRASOWSKI		
SURVEYED BY	R.D.B. D.I.G. J.D.B.	MAY, 1973	
Scale: 1" = 100'	Drawn by: D.I.G.		MAY, 1973