


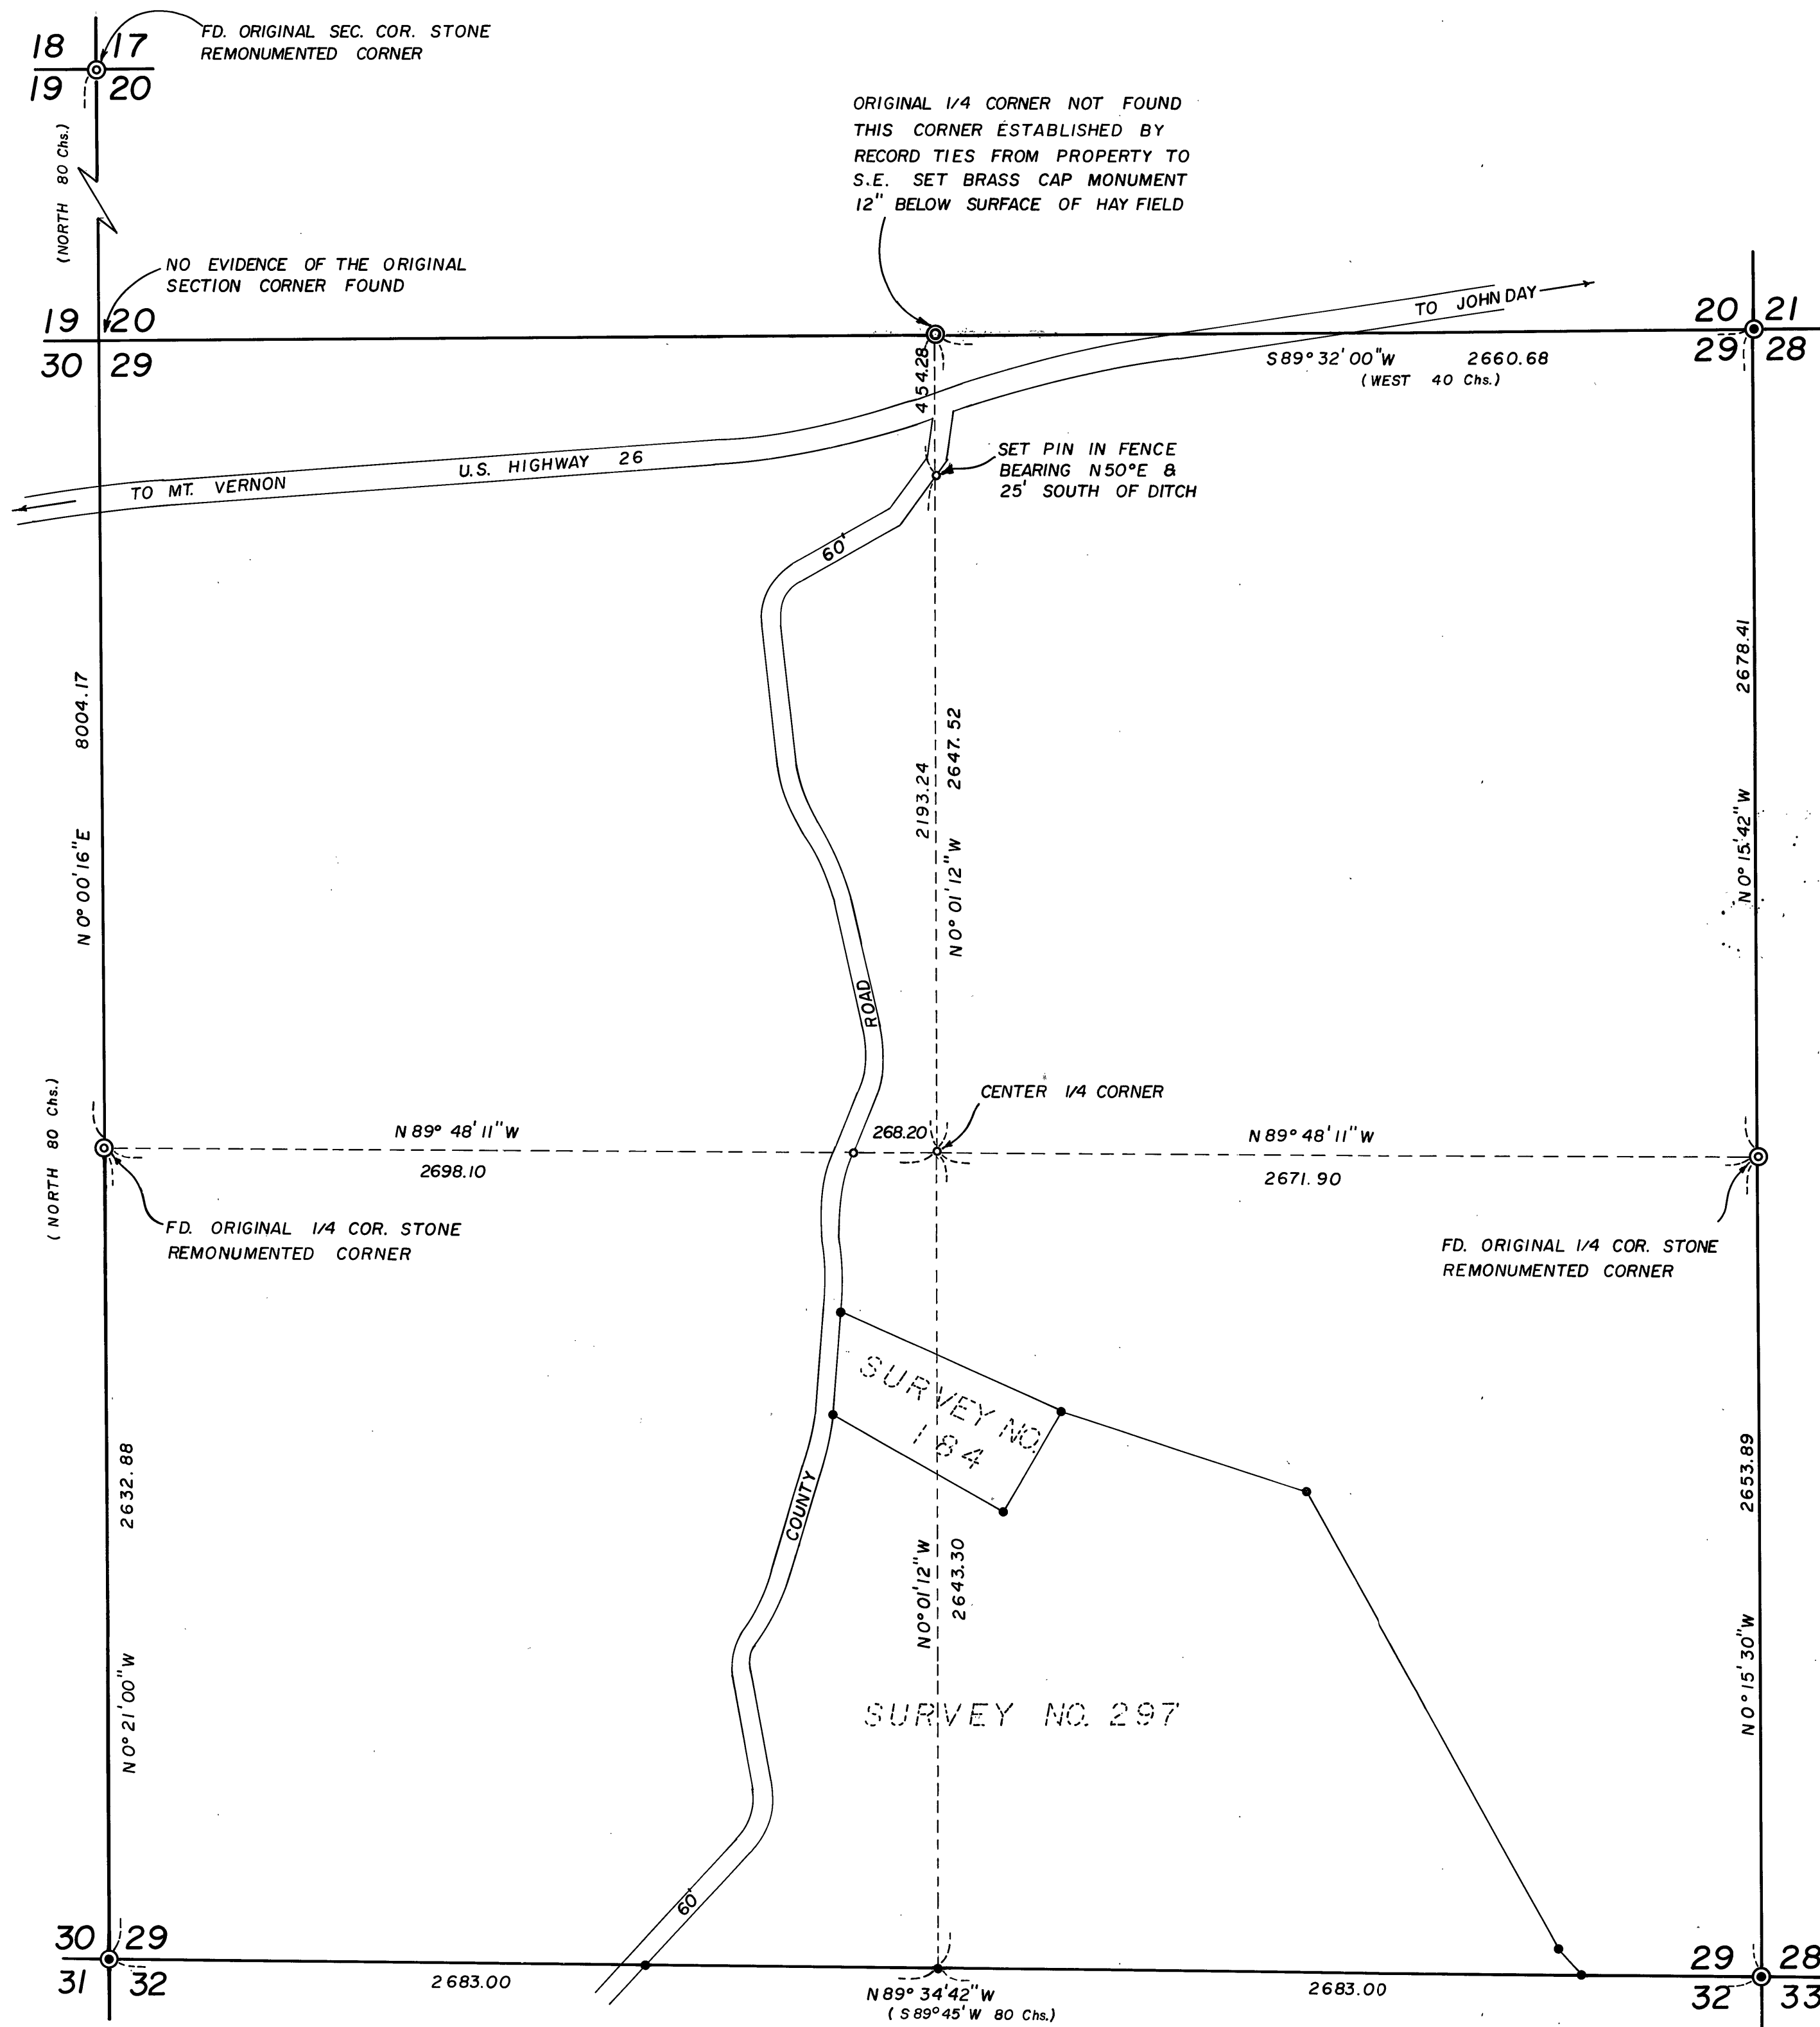

BASIS OF BEARINGS
SURVEY NO. 297

REFERENCE MATERIAL

DEEDS:			
BOOK	50	PAGE	111
"	74	"	595
"	93	"	600

LEGEND

- FD 5/8"x30" IRON PIN
- SET 5/8"x30" IRON PIN
- ⊙ FD. COUNTY SURVEYOR BRASS CAP MONUMENT
- ⊙ SET COUNTY SURVEYOR BRASS CAP MONUMENT
- () RECORD BEARING AND DISTANCE

NOTE

SEE COUNTY SURVEYOR REMONUMENTATION
RECORDS FOR DESCRIPTION OF MONUMENTS
FOUND AND SET AND FOR DESCRIPTION OF
NEW CORNER ACCESSORIES.

REGISTERED
PROFESSIONAL
LAND SURVEYOR
Robert D. Bagett
OREGON
JULY 12, 1963
ROBERT D. BAGETT
598

RECEIVED AND
FILED
JUN 14 1973
JOHN VIVEIRA, County Clerk
John Viveira

BAGETT-GRIFFITH-FERGUSON		
John Day, Oregon		
Map of Survey		
SUBDIVISION OF SECTION 29		
T.13S., R. 31 E., W.M.		
GRANT COUNTY, OREGON		
SURVEYED FOR	STAN KRASOWSKI	
SURVEYED BY	R.D.B. & J.D.B.	5 / 73
Scale: 1" = 400'	Drawn by: J.D.B.	5 / 73