

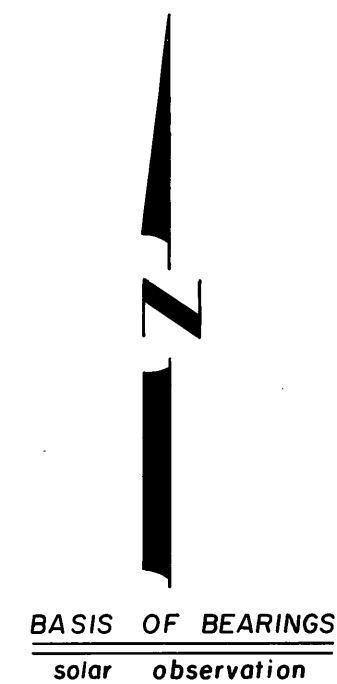


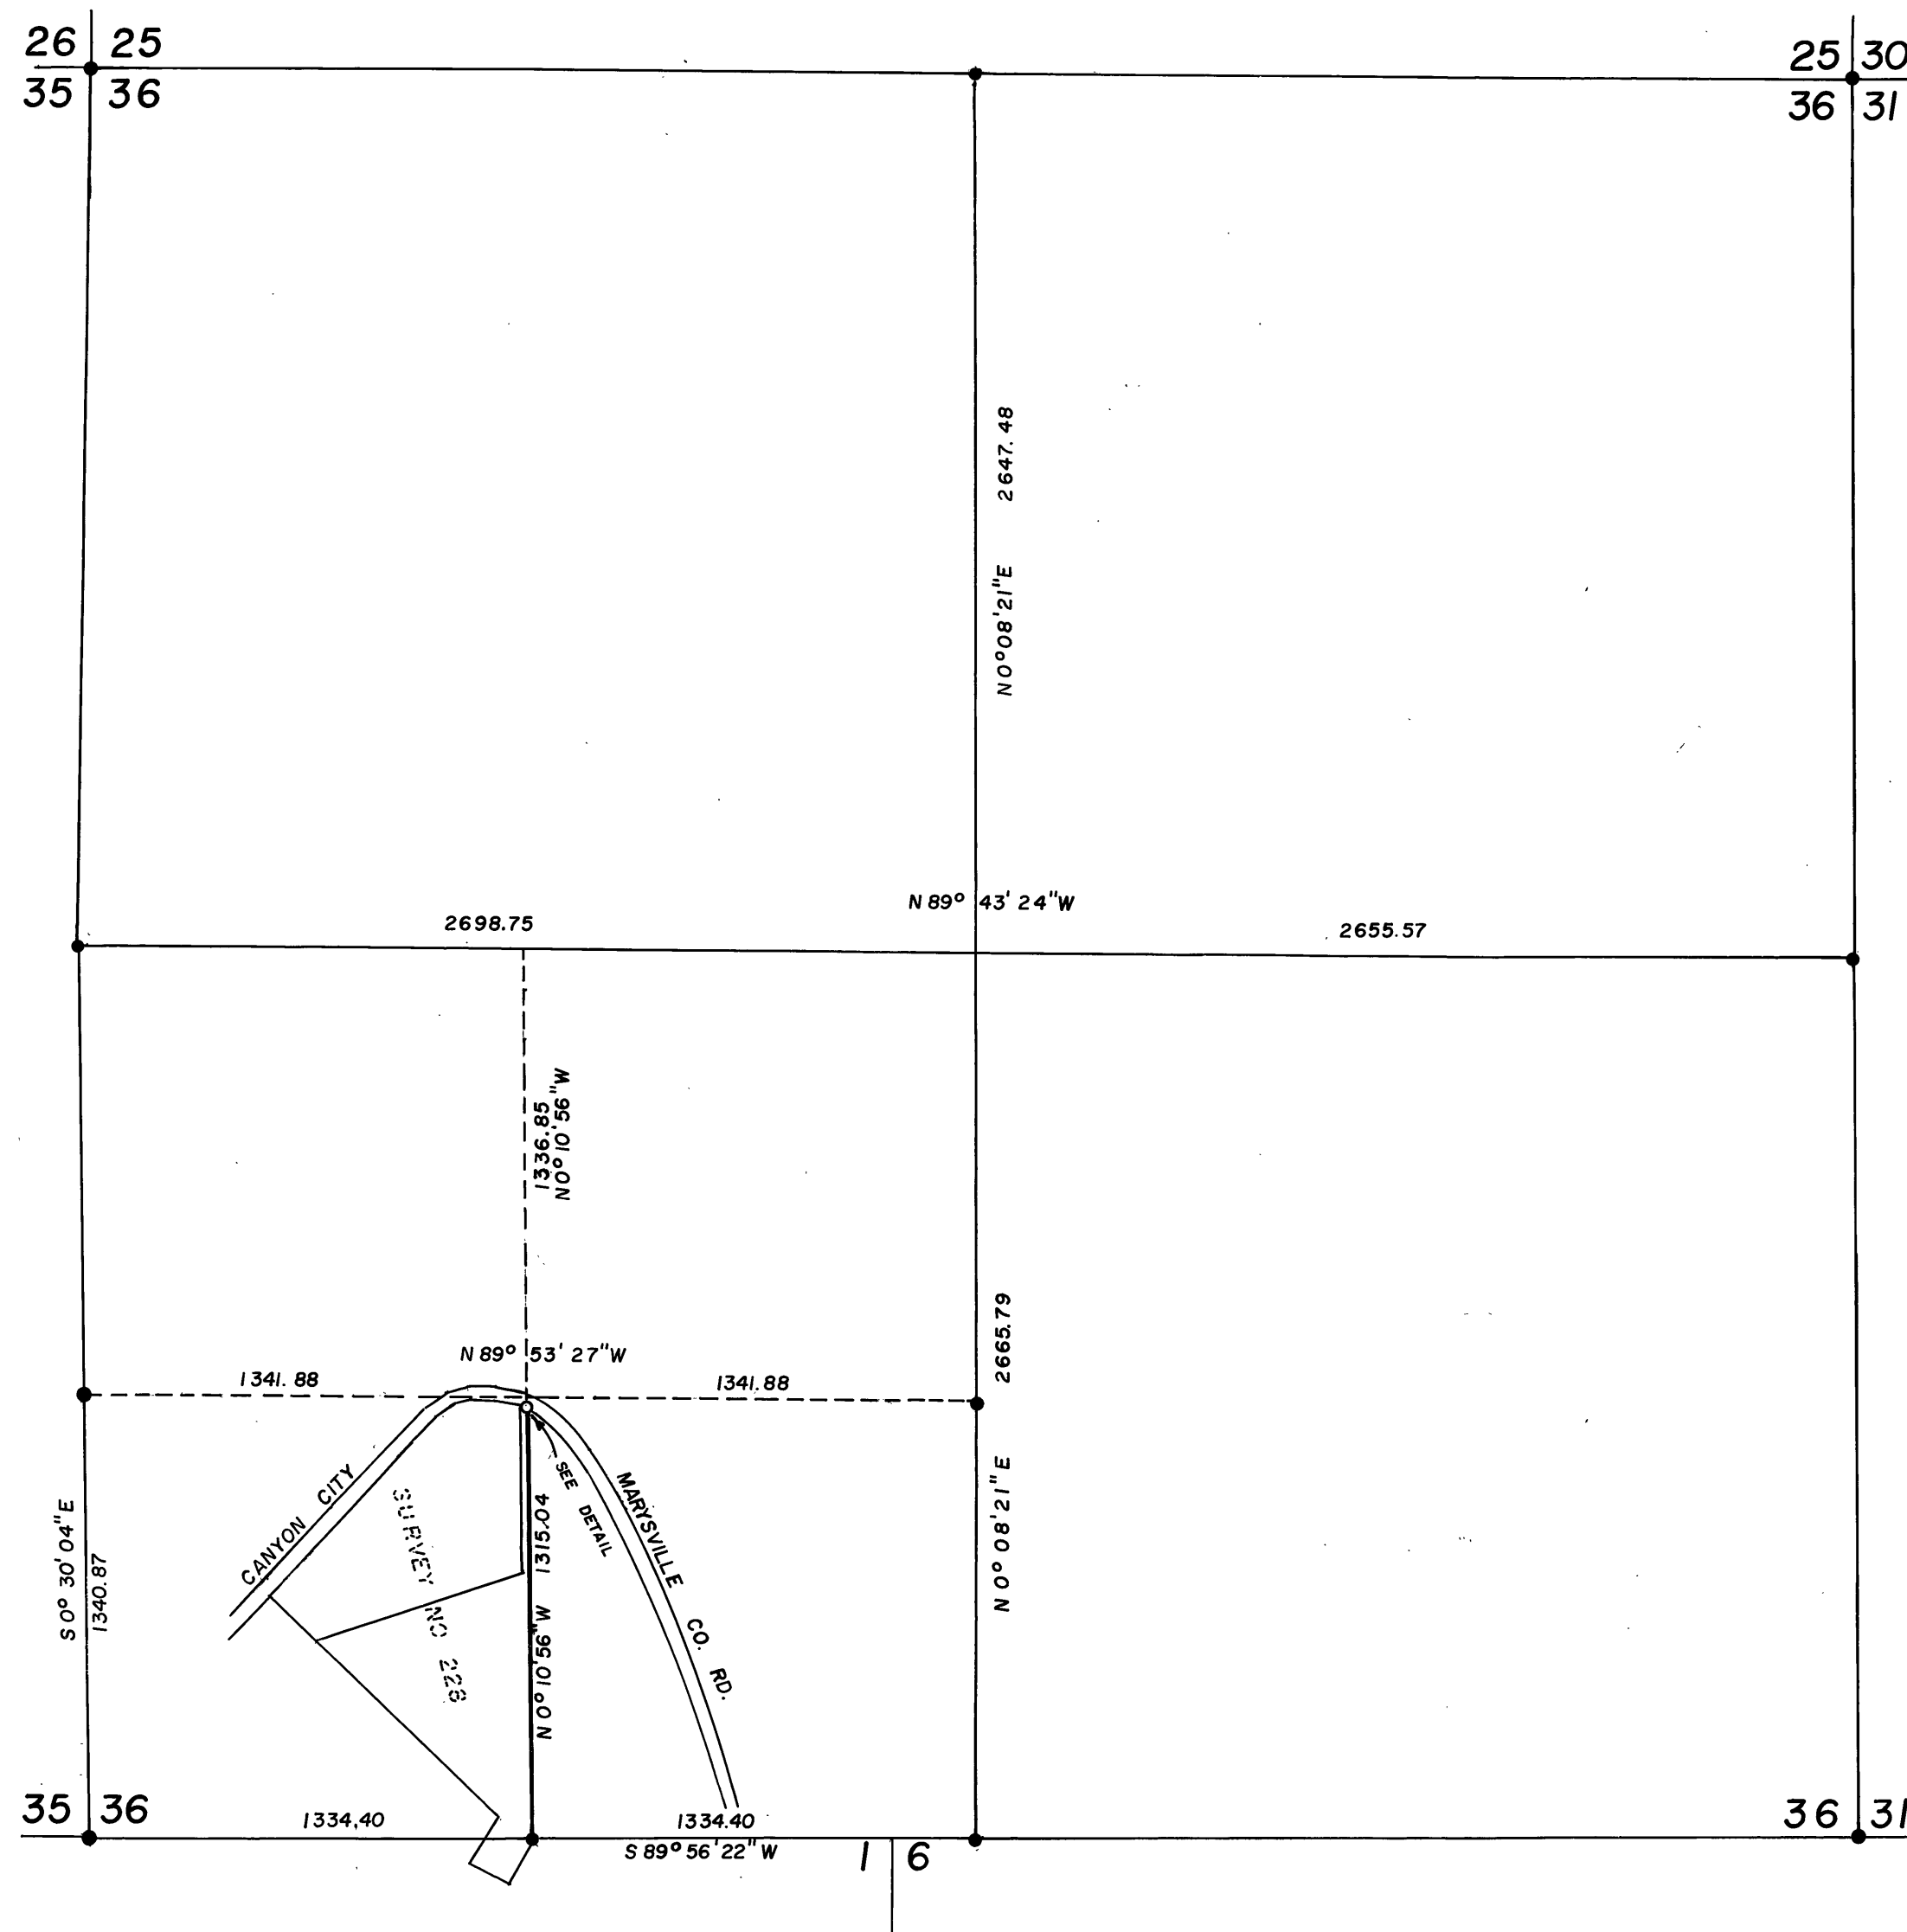


DETAIL
SCALE 1" = 20'

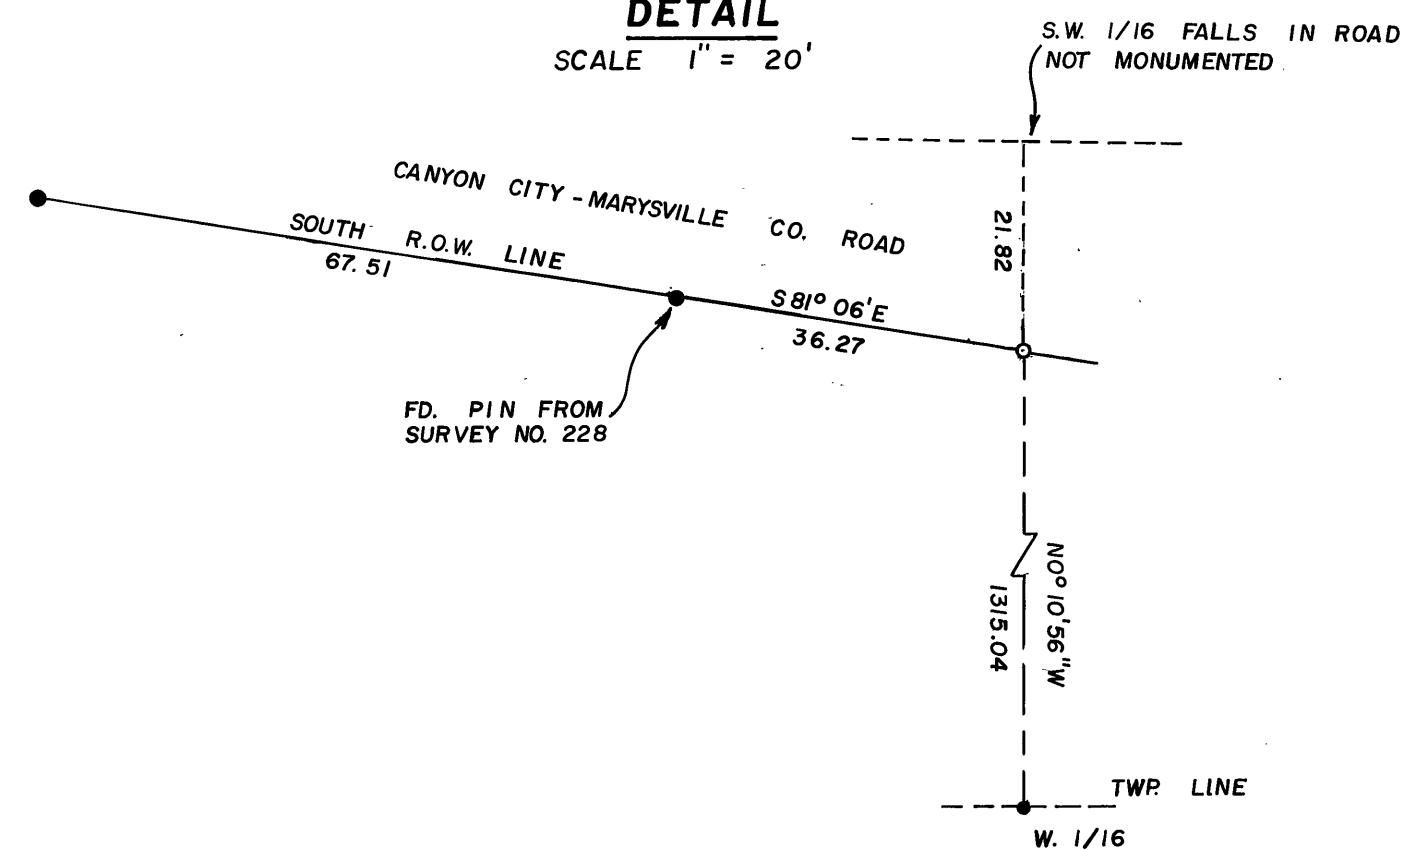

LEGEND

- SET 5/8"x30" IRON PIN WITH ATTACHED PLASTIC CAP MARKED "BGF SURVEY MK"
- FD. MONUMENT OF RECORD

RECEIVED AND
FILED
JUN 14 1973
JOHN L. VEIRA, County Clerk
By *Betty G. Veira* Deputy

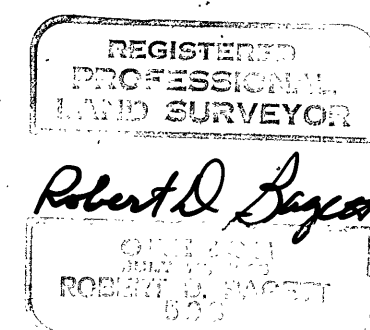

BAGETT-GRIFFITH-FERGUSON

John Day, Oregon

Map of Survey

INTERSECTION OF THE WEST 1/16 LINE AND THE S. R.O.W. CANYON CITY - MARYSVILLE COUNTY ROAD
SEC. 36, T.13 S., R.31 E., W.M.

GRANT COUNTY, OREGON

SURVEYED FOR	GLEN GODDARD	
SURVEYED BY	R.D.B. & D.I.G.	5/26/73
Scale: 1" = 500'	Drawn by: J.D.B.	5/29/73