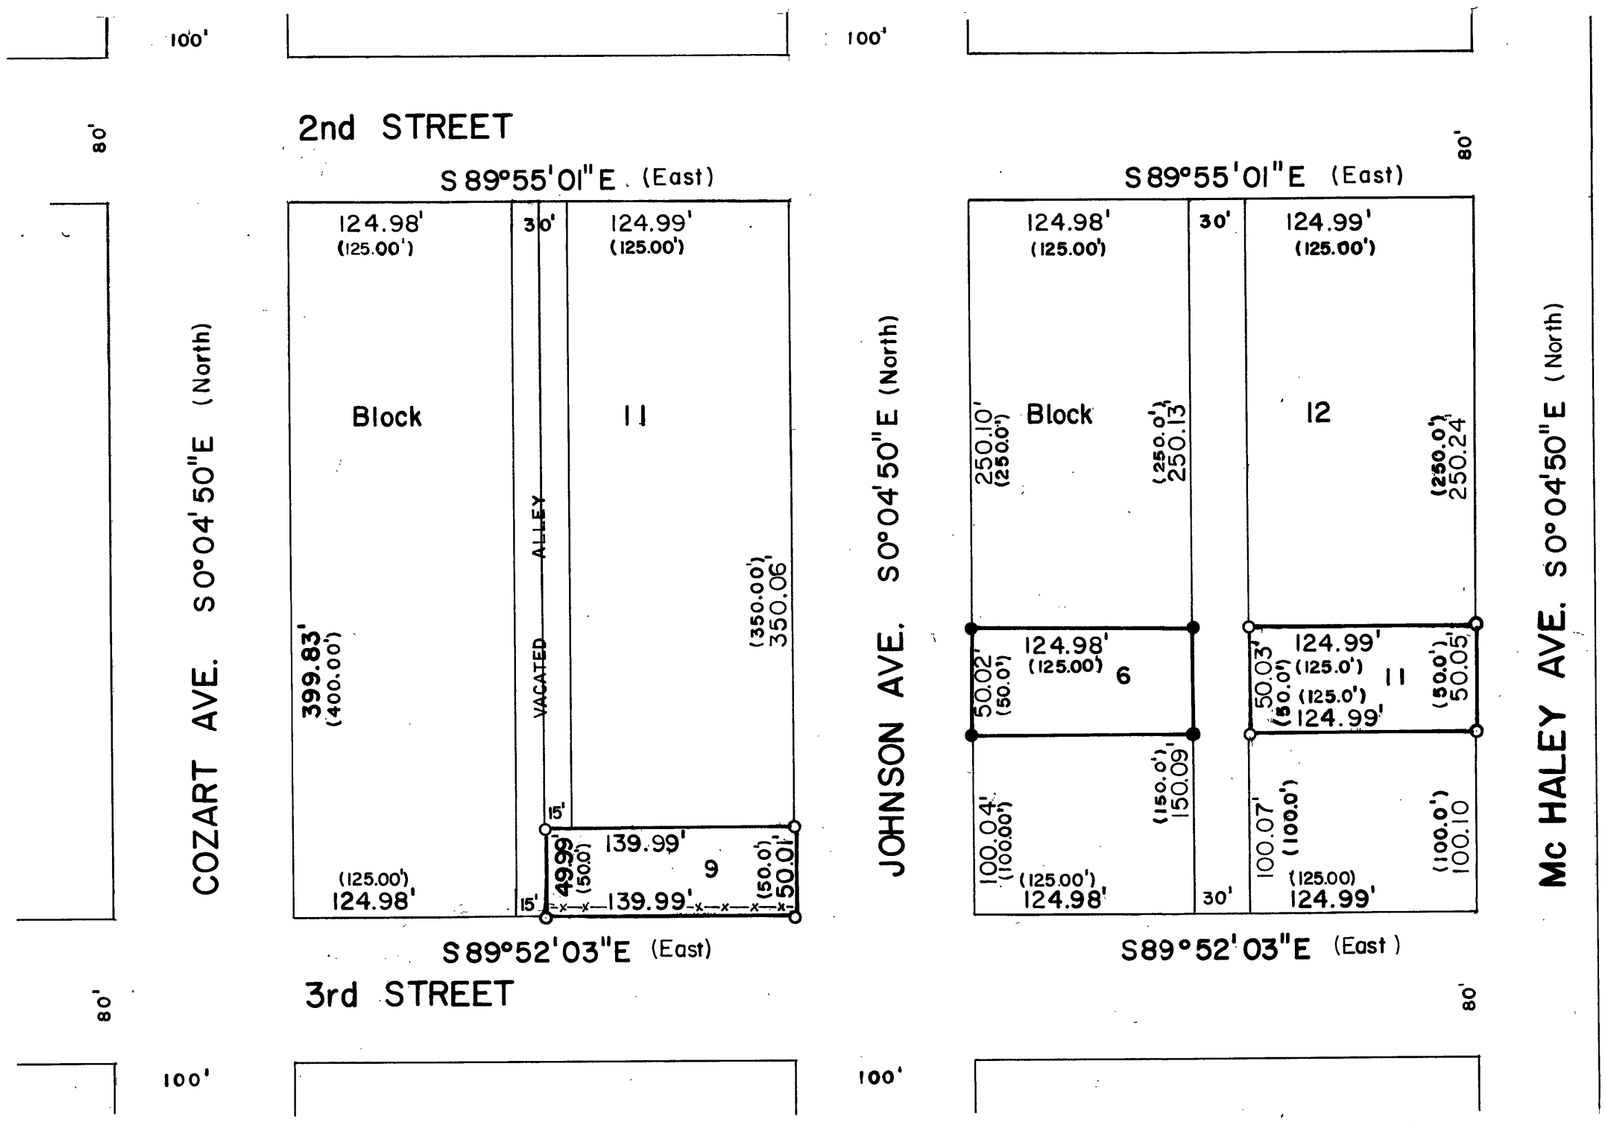

BASIS OF BEARINGS
From Survey No. 113

REGISTERED
PROFESSIONAL
LAND SURVEYOR
Robert D. Bagett
OREGON
JULY 12, 1963
ROBERT D. BAGETT
598

RECEIVED AND
FILED
JUL 9 1973
JOHN LIVEIRA, County Clerk
By _____ Deputy

REFERENCE MATERIAL

Map of Survey no. 113

LEGEND

- ● Fd. Monument
- o Set 5/8" X 30" iron pin
- ( ) Rec. Bearing & Distance
- —x— Fence

BAGETT-GRIFFITH-FERGUSON
John Day, Oregon

Map of Survey

LOT 9, BLOCK 11
LOT 11, BLOCK 12
CLEAVER and COZART ADDITION
to
PRAIRIE CITY
GRANT COUNTY, OREGON

SURVEYED FOR	D. KLINE & J. MASTERSON	
SURVEYED BY	R.D.B. & D.I.G	6/23/73
Scale: 1" = 80'	Drawn by: M.L.H.	6/27/73

MAP OF SURVEY NO. 308