


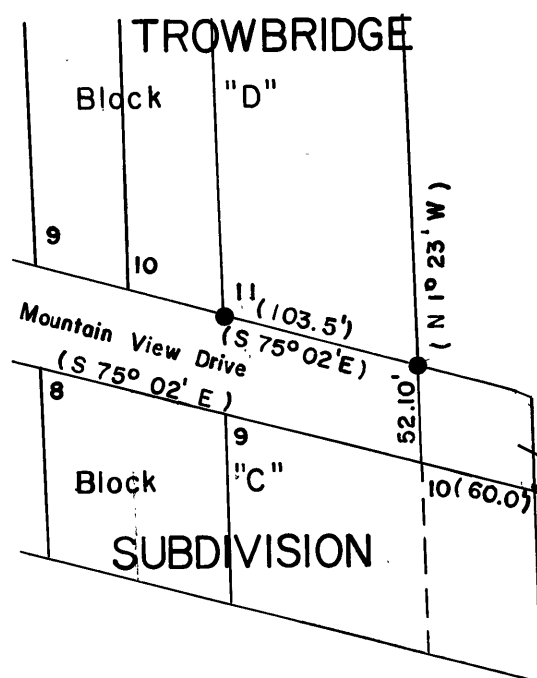


- LEGEND**
- FOUND IRON PIN
  - SET 5/8" X 30" IRON PIN
  - ( ) RECORD BEARING & DISTANCE
  - x — FENCE

**REFERENCE MATERIAL**

MAP OF SURVEY No. 93

RECEIVED AND  
FILED  
JUL 20 1973  
JOHN LIVEIRA, County Clerk  
By \_\_\_\_\_ Deputy

**BASIS OF BEARINGS**  
SOLAR OBSERVATION

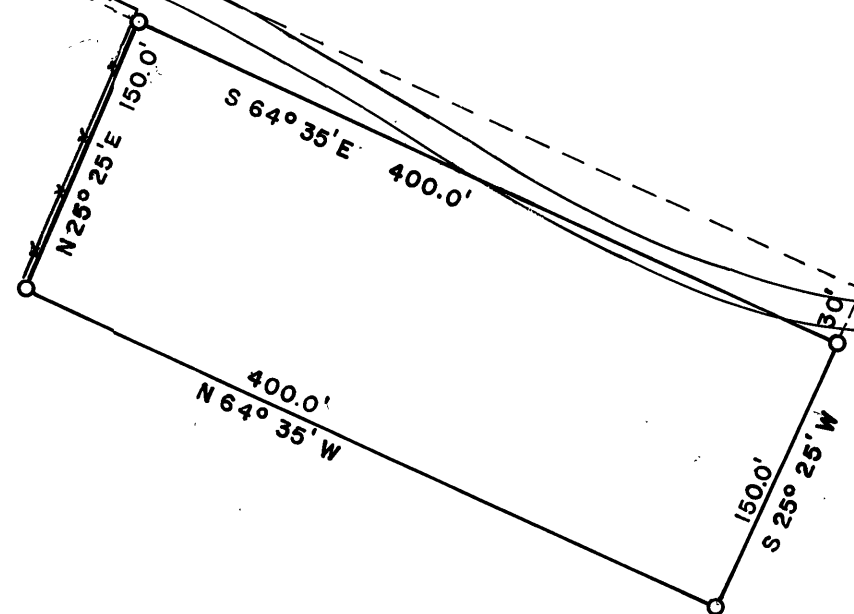

REGISTERED  
PROFESSIONAL  
LAND SURVEYOR

Robert D. Baggett  
OREGON  
JULY 12, 1963  
ROBERT D. BAGETT  
598

**BAGETT-GRIFFITH-FERGUSON**

John Day, Oregon

Map of Survey

A TRACT OF LAND IN THE W 1/2 SE 1/4  
SEC. 23, TWP. 13S., R. 31 E., W.M.

GRANT COUNTY, OREGON

|                  |                 |         |
|------------------|-----------------|---------|
| SURVEYED FOR     | JAMES HENNING   |         |
| SURVEYED BY      | R.A.M. & M.L.H. | 7/9/73  |
| Scale: 1" = 100' | Drawn by: MLH   | 7/11/73 |