


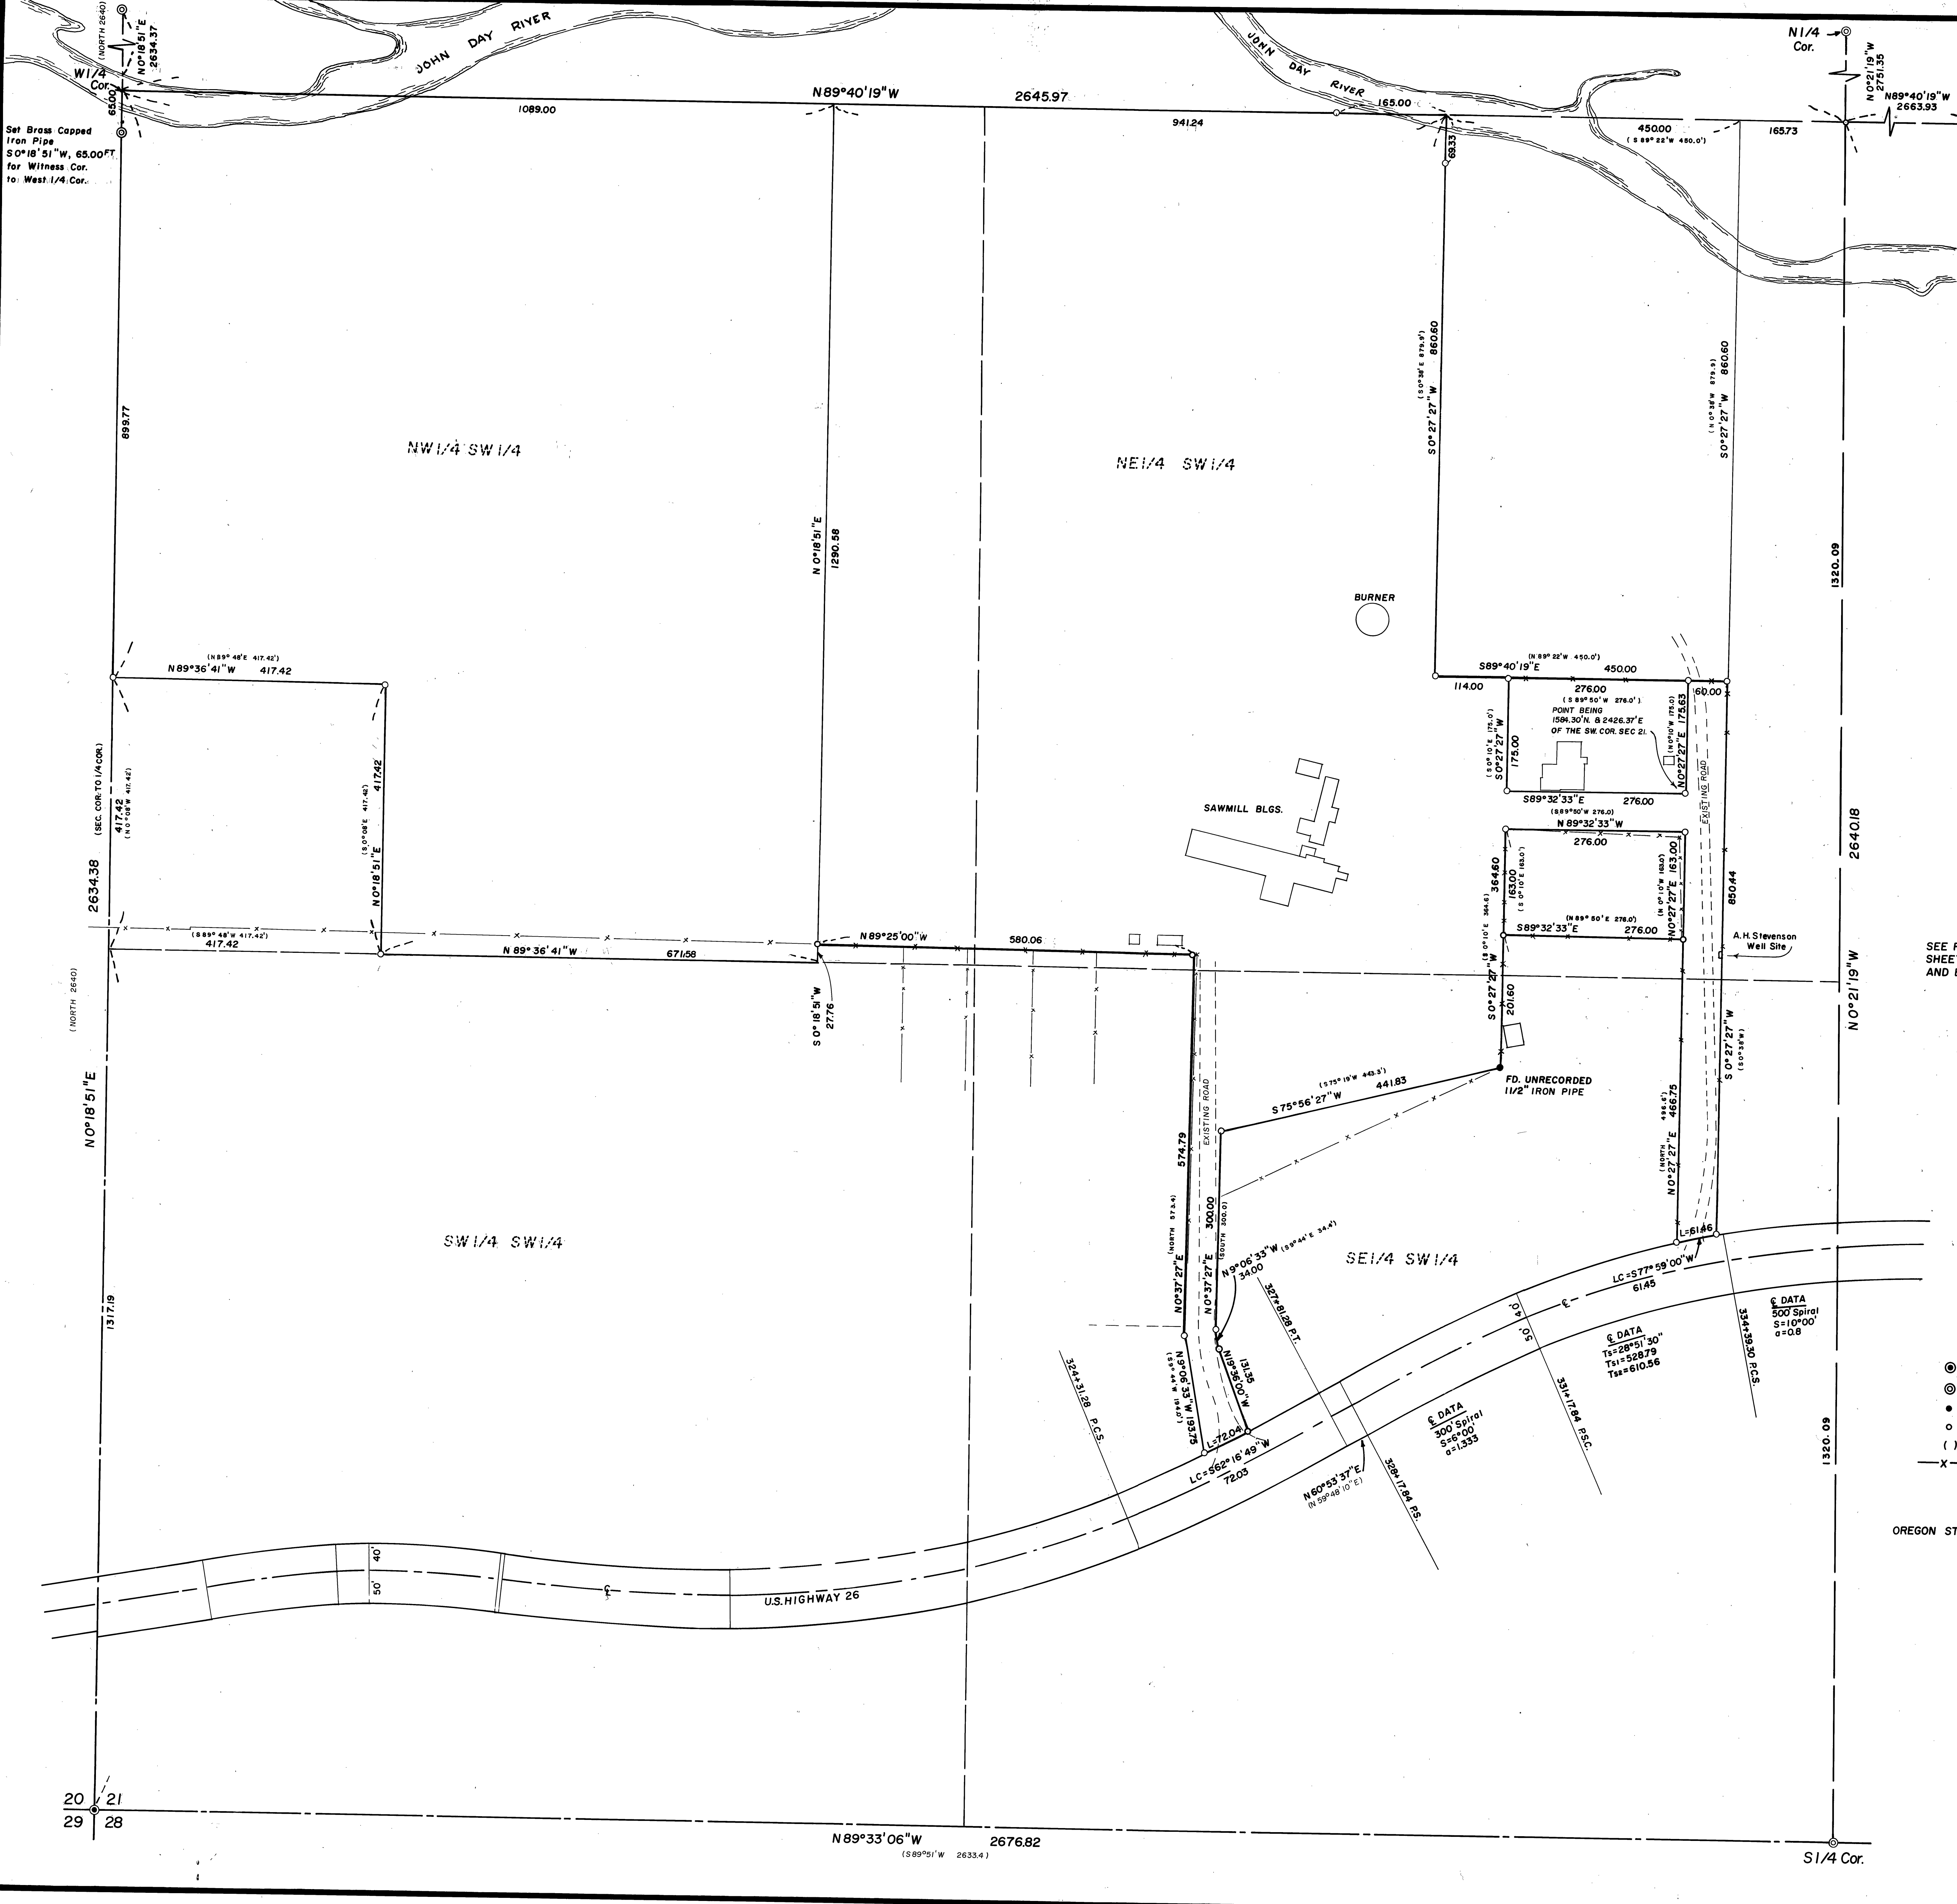

BASIS OF BEARINGS
Solar Observation

NOTE:
SEE RECORDED CORNER REMONUMENTATION
SHEETS FOR DESCRIPTION OF MONUMENTS
AND BEARING TREES AT SECTION CORNERS

RECEIVED AND
FILED
By *Robert D. Baggett*

- LEGEND**
- Fd. Brass Capped Monument
 - Set " " " "
 - Fd. 5/8" X 30" Iron pin
 - Set " " " "
 - () Record Bearing and Dist.
 - X— Fence Line

REFERENCES
OREGON STATE HIGHWAY DEPT. Drawing No. 7B-16-21
SURVEY NO. 161
" " 298
Deed Descriptions

REGISTERED
PROFESSIONAL
LAND SURVEYOR
Robert D. Baggett
OREGON
ROBERT D. BAGGETT
598

BAGETT-GRIFFITH-FERGUSON John Day, Oregon			
Map of Survey			
PARCELS IN THE SW 1/4 OF SEC 21 T.13S, R.31E, W.M.			
GRANT COUNTY, OREGON			
SURVEYED FOR	M. DALE - G. LEE - W. STUTSMAN		
SURVEYED BY	R.D.B. D.G.	7/73-2/74	
Scale: 1" = 100'	Drawn by: C.M.	8/20/73	