


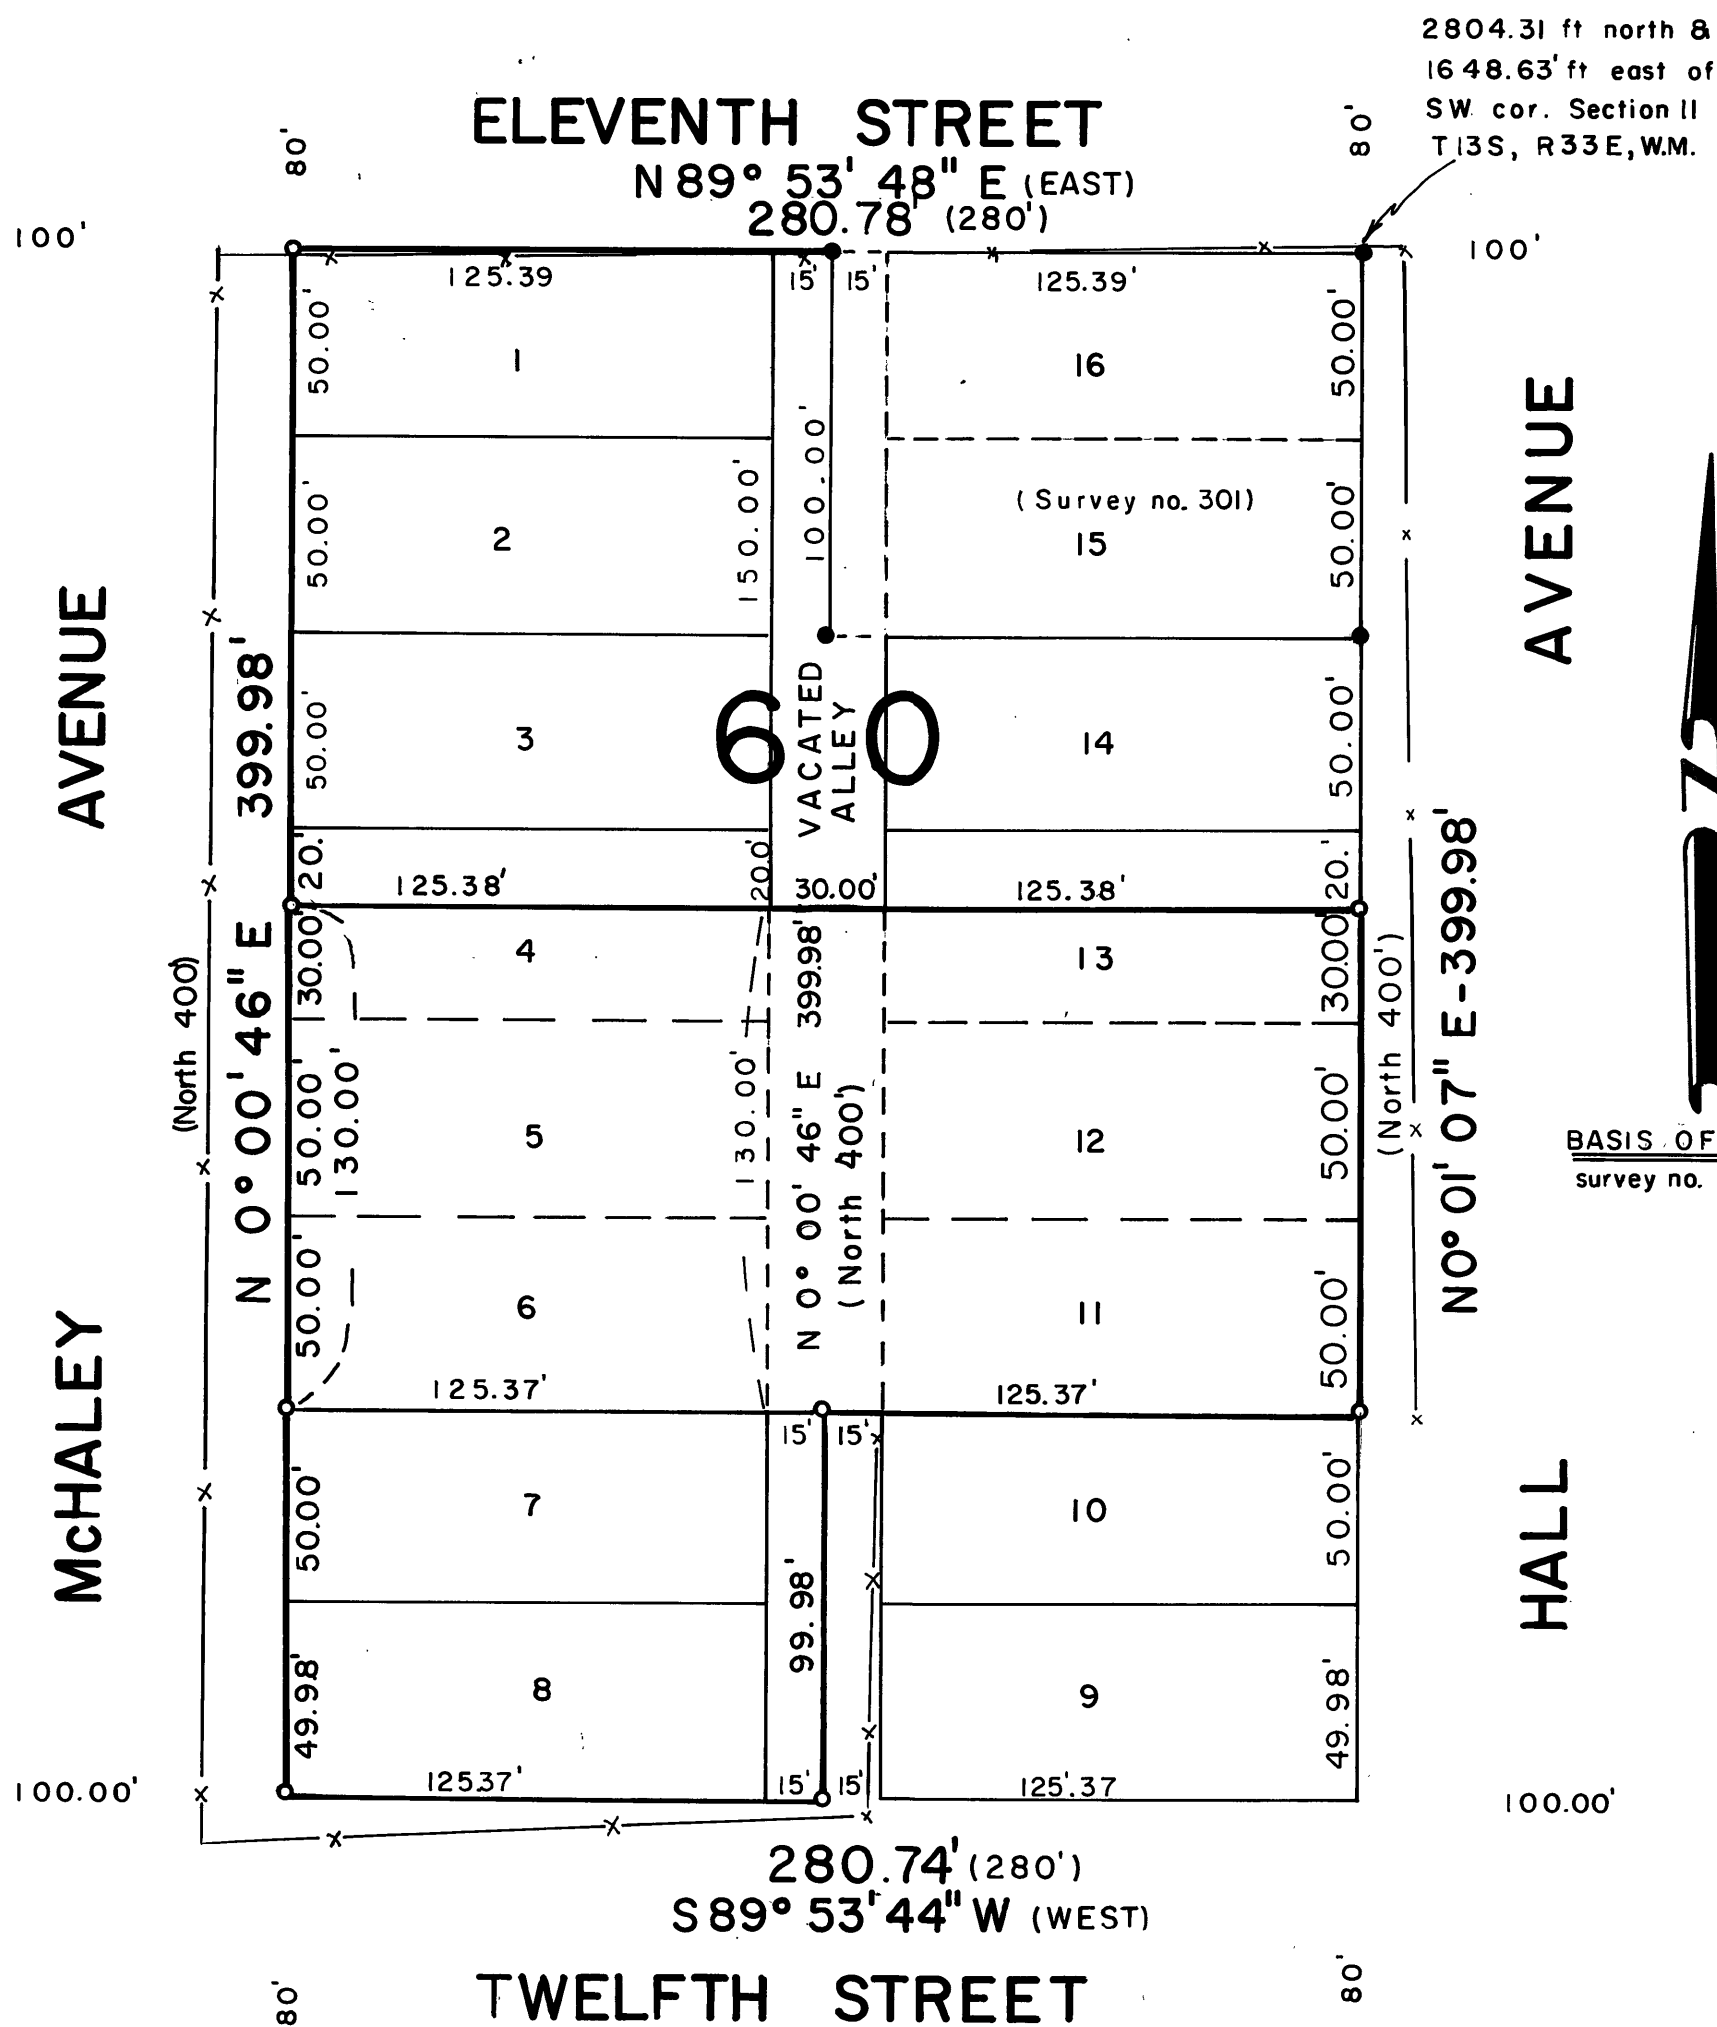

# LEGEND

- set 5/8" x 30" iron pin
- found 5/8" iron pin
- x — fence
- ( ) record bearing and distance

RECEIVED AND  
FILED

OCT 23 1973

JOHN LIVEIRA, County Clerk

By \_\_\_\_\_ Deputy

REGISTERED  
PROFESSIONAL  
LAND SURVEYOR

Robert D. Bagett

OREGON  
JULY 12, 1963  
ROBERT D. BAGETT  
598

BAGETT-GRIFFITH

John Day, Oregon

Map of Survey  
 West boundary of lots 1, 2, 3, and North 20 ft of 4  
 Lots 4, 5, 6, 7, 8, 11, 12, and South 30' of 13  
 Block 60, Praire City Land Co. First Addition  
 Praire City GRANT COUNTY, OREGON

SURVEYED FOR J. C. DREWETT

SURVEYED BY RDB, DIG, GJ

9/10/73

Scale: 1" = 50'

Drawn by: J.S.P.

10/11/73