


PROPERTY SURVEY: CITY OF DAYVILLE, OREGON	
Located in the NW 1/4, NE 1/4, Sec. 12, T. 13 S., R. 26 E. W.M.	
Grant County, Oregon	
DATE Nov. 1973	SCALE 1" = 200'
J. VAL TORONTO AND ASSOCIATES 213 S W EMIGRANT AVE — PENDLETON, OREGON	



RECEIVED AND
FILED
OCT 23 1973
JOHN LIVELINA, County Clerk
By _____ Deputy

BASIS OF BEARING:
1. SURVEY # 226, BAGGITT-GRIFFITH-FERGUSON
MAY 1971 - COUNTY SURVEYOR'S OFFICE
2. MAP OF DAYVILLE & VICINITY, OREGON STATE
TAX COMMISSION, 1950

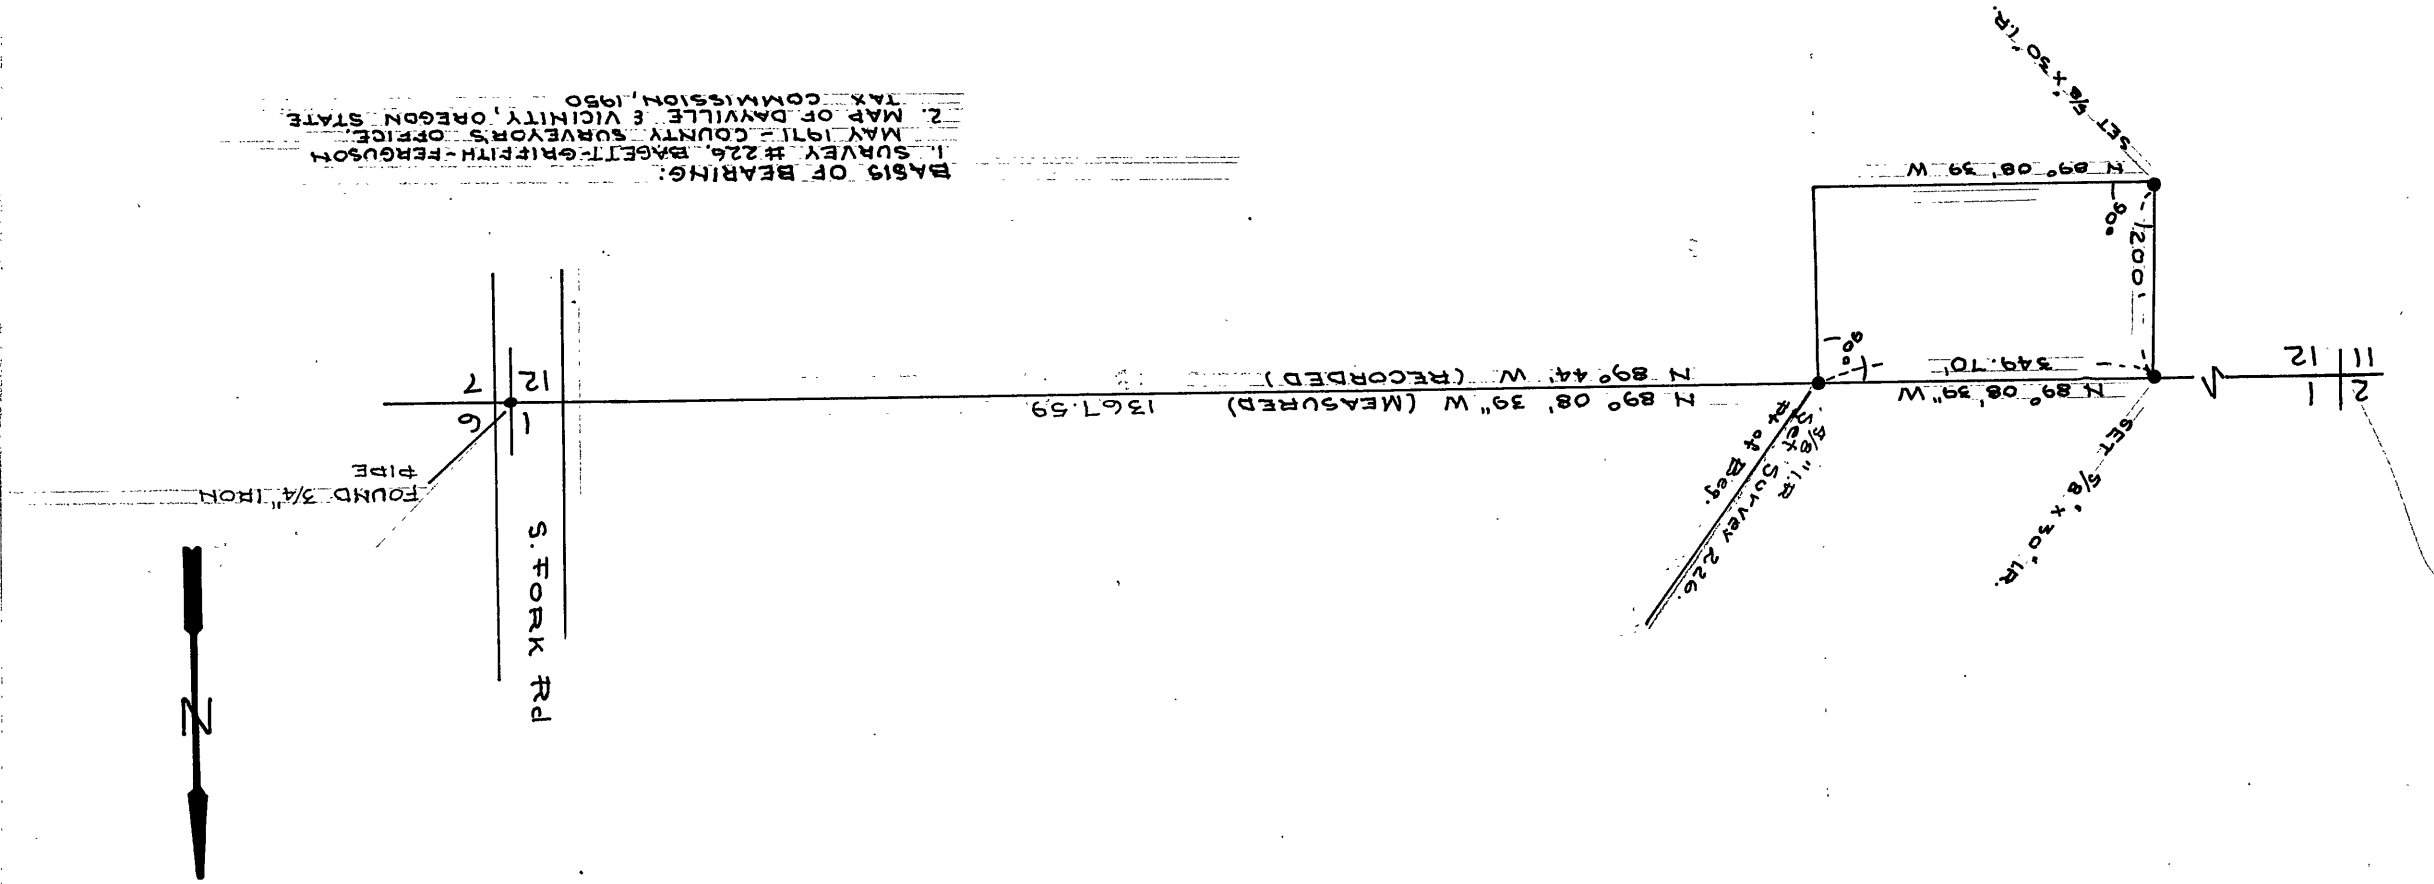

MAP OF SURVEY NO. 319