
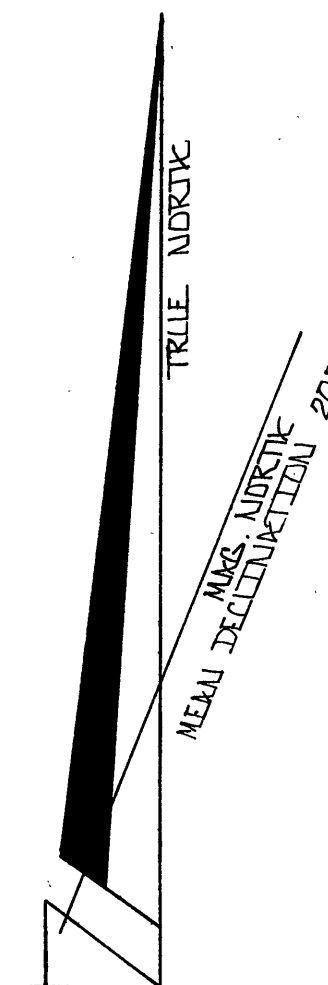


SECTION SUBDIVISION

SECTION 33, TOWNSHIP 18 SOUTH, RANGE 26 EAST, W.M.
SEPTEMBER 1973

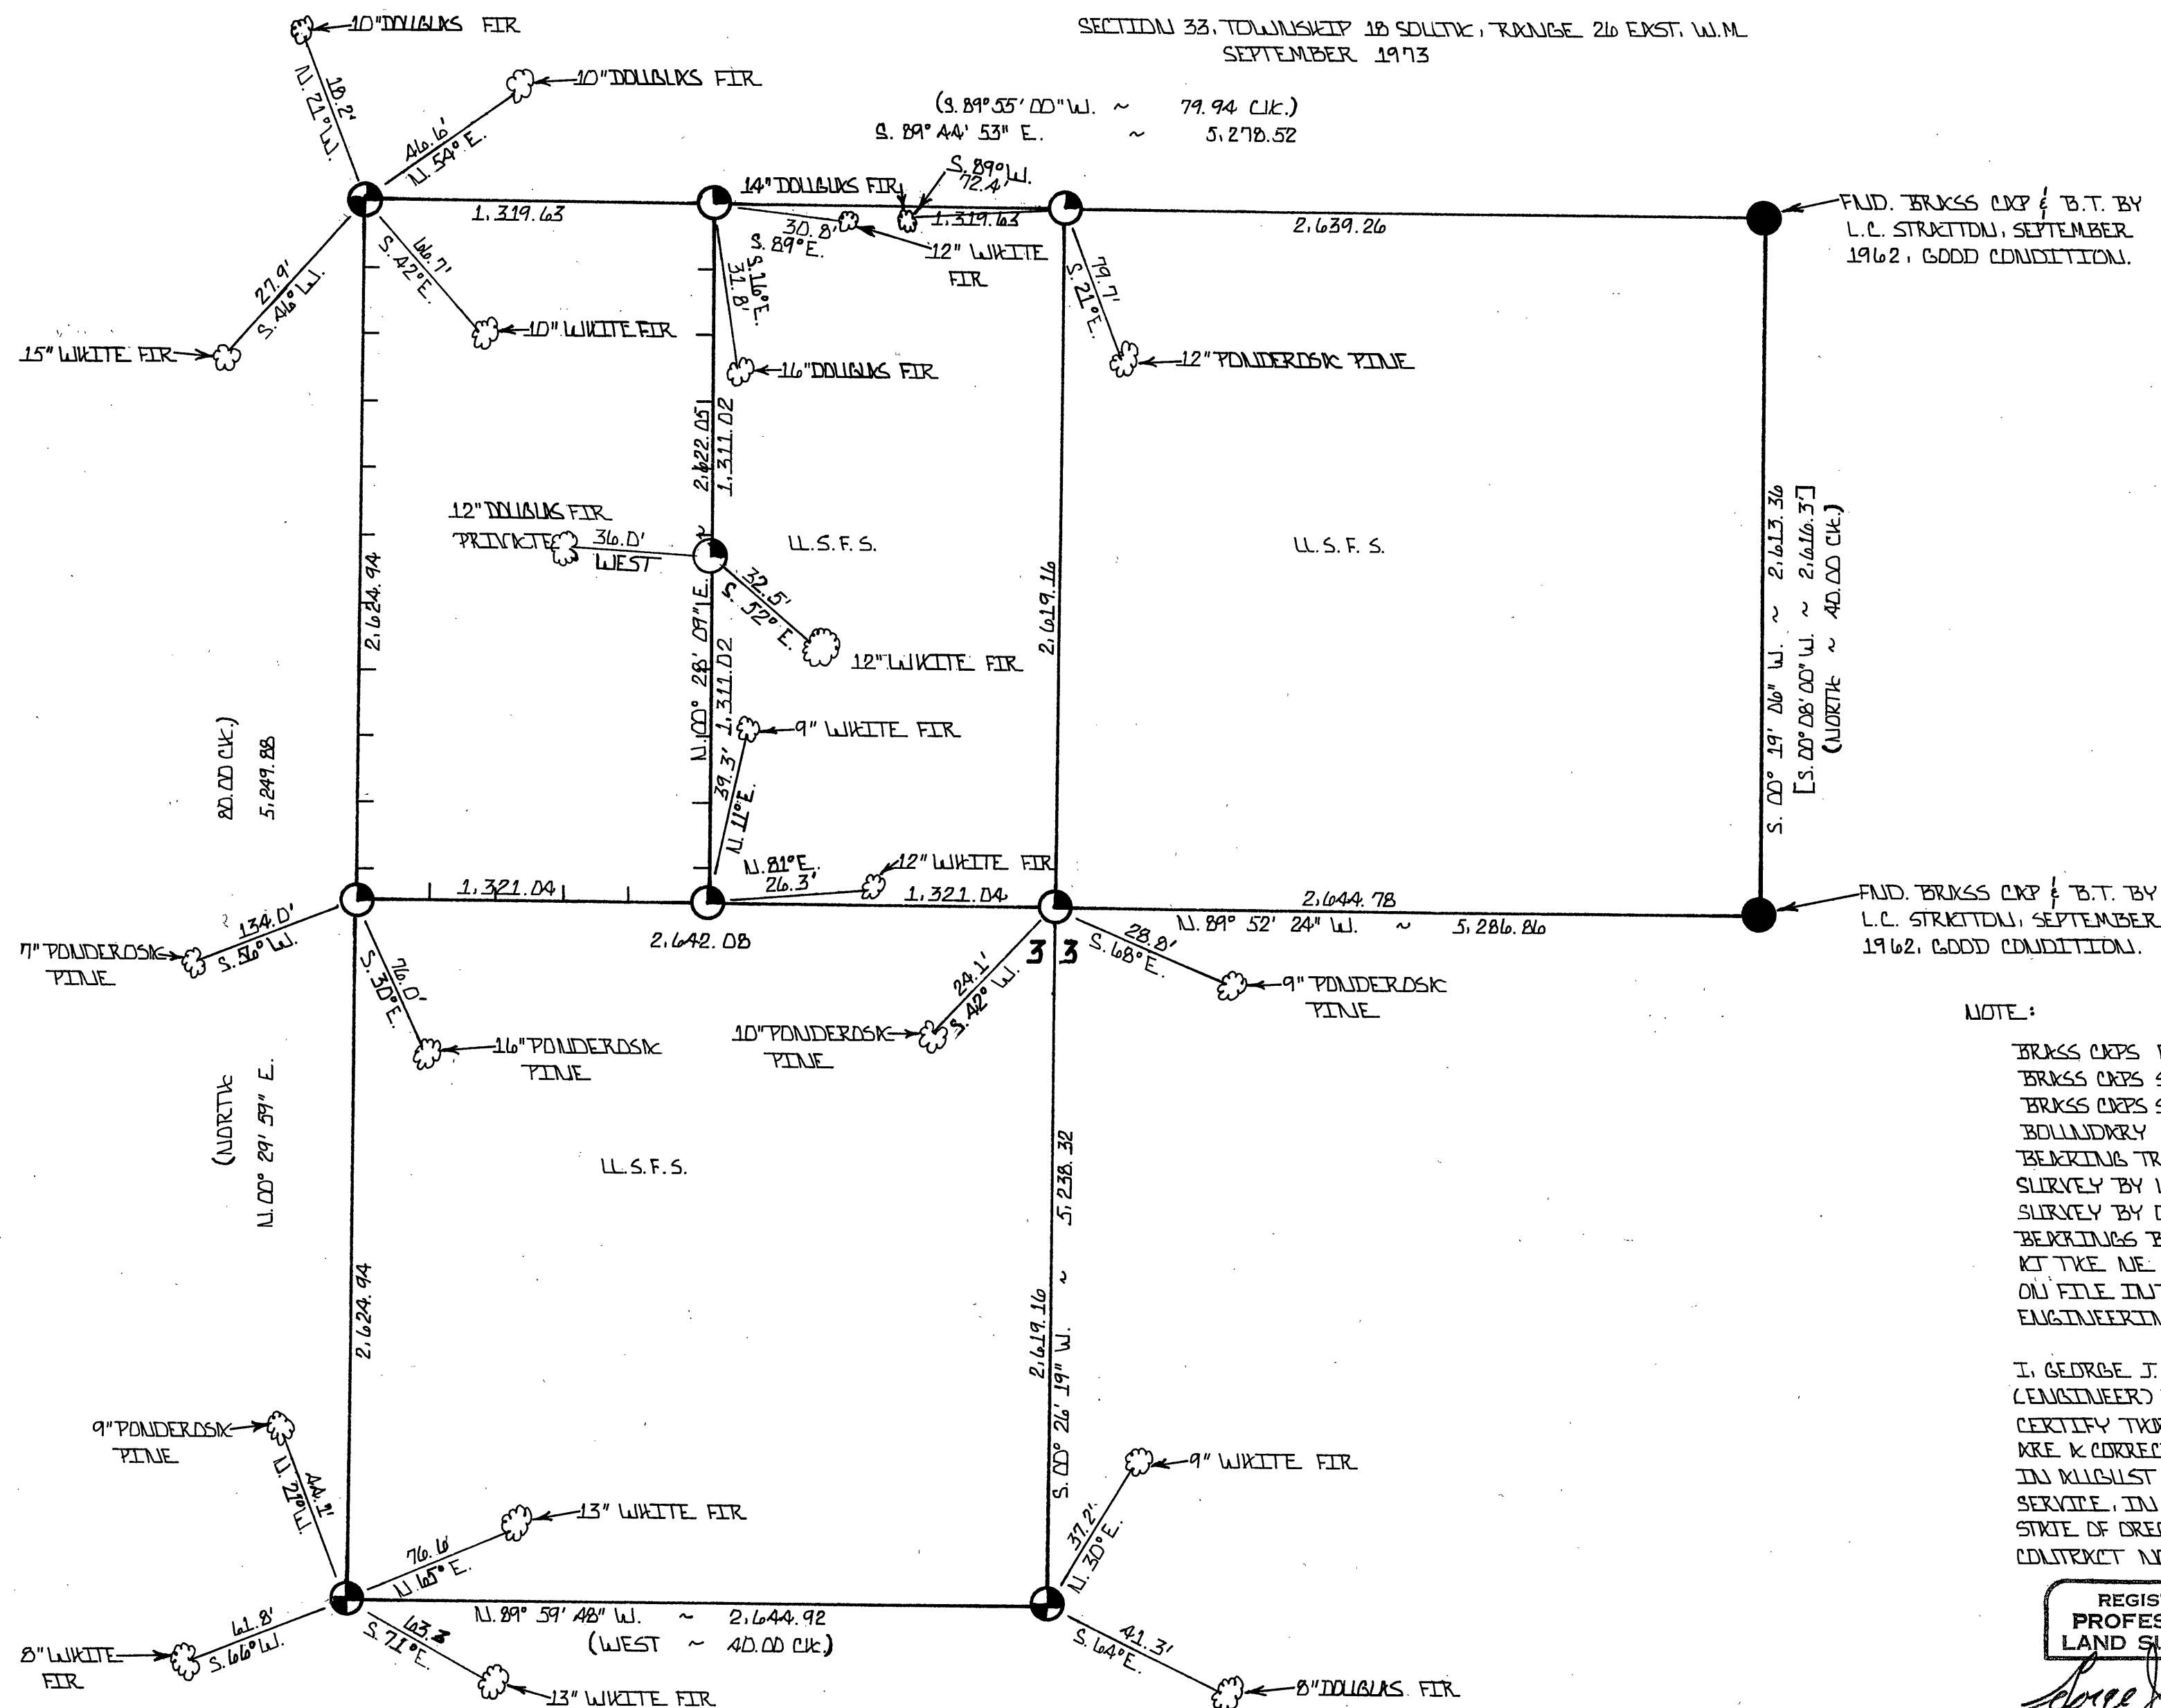

NOTE:

BRASS CRIPS FND.
BRASS CRIPS SET FROM EXISTING EVIDENCE
BRASS CRIPS SET FROM SURVEYED DICTION
BOUNDARY LINES MARKED
BEARING TREE DISTANCES NOT TO SCALE
SURVEY BY L.C. STRATTON ~ P.E. 4563
SURVEY BY ORIGINAL NOTES
BEARINGS BASED ON SOLAR OBSERVATION
AT THE NE CORNER, ORIGINAL FIELD BOOK
ON FILE IN THE OFFICES OF GEORGE J. COOK,
ENGINEERING, INC.

I, GEORGE J. COOK, A REGISTERED LAND SURVEYOR
(ENGINEER) IN THE STATE OF OREGON, HEREBY
CERTIFY THAT THIS PLAN AND THE NOTES ATTACHED
ARE A CORRECT REPRESENTATION OF A SURVEY I PERFORMED
IN AUGUST ~ SEPTEMBER, 1973, FOR THE U.S. FOREST
SERVICE, IN ACCORDANCE WITH THE STATUTES OF THE
STATE OF OREGON AND WITH THE ARTICLES OF MY CONTRACT.
CONTRACT NO. 004075

151 GEORGE J. COOK
REGISTERED LAND SURVEYOR
OREGON LICENSE 540

REGISTERED
PROFESSIONAL
LAND SURVEYOR

OREGON
JULY 14, 1967
GEORGE J. COOK
540

500 250 0 500 1,000 FEET
SCALE

RECEIVED AND
FILED

NOV 5 1973

JOHN LIVEIRA, County Clerk

By *Betty* Deputy

GEORGE J. COOK
ENGINEERING
ASSOCIATES

ENGINEERS
LAND SURVEYORS
2200 N. 10TH - 97001
CORVALLIS, OREGON

TITLE: SECTION SUBDIVISION
SECTION 33, TOWNSHIP 18 SOUTH, RANGE 26 EAST, W.M.

DRN BY: G.J.C.	SCALE: 1" = 100'
CR. BY: G.J.C.	DATE PLD. ~ SEPT. 1973
ENR BY: G.J.C.	SHEET NO. 1 OF 1

MAP OF SURVEY NO. 321