


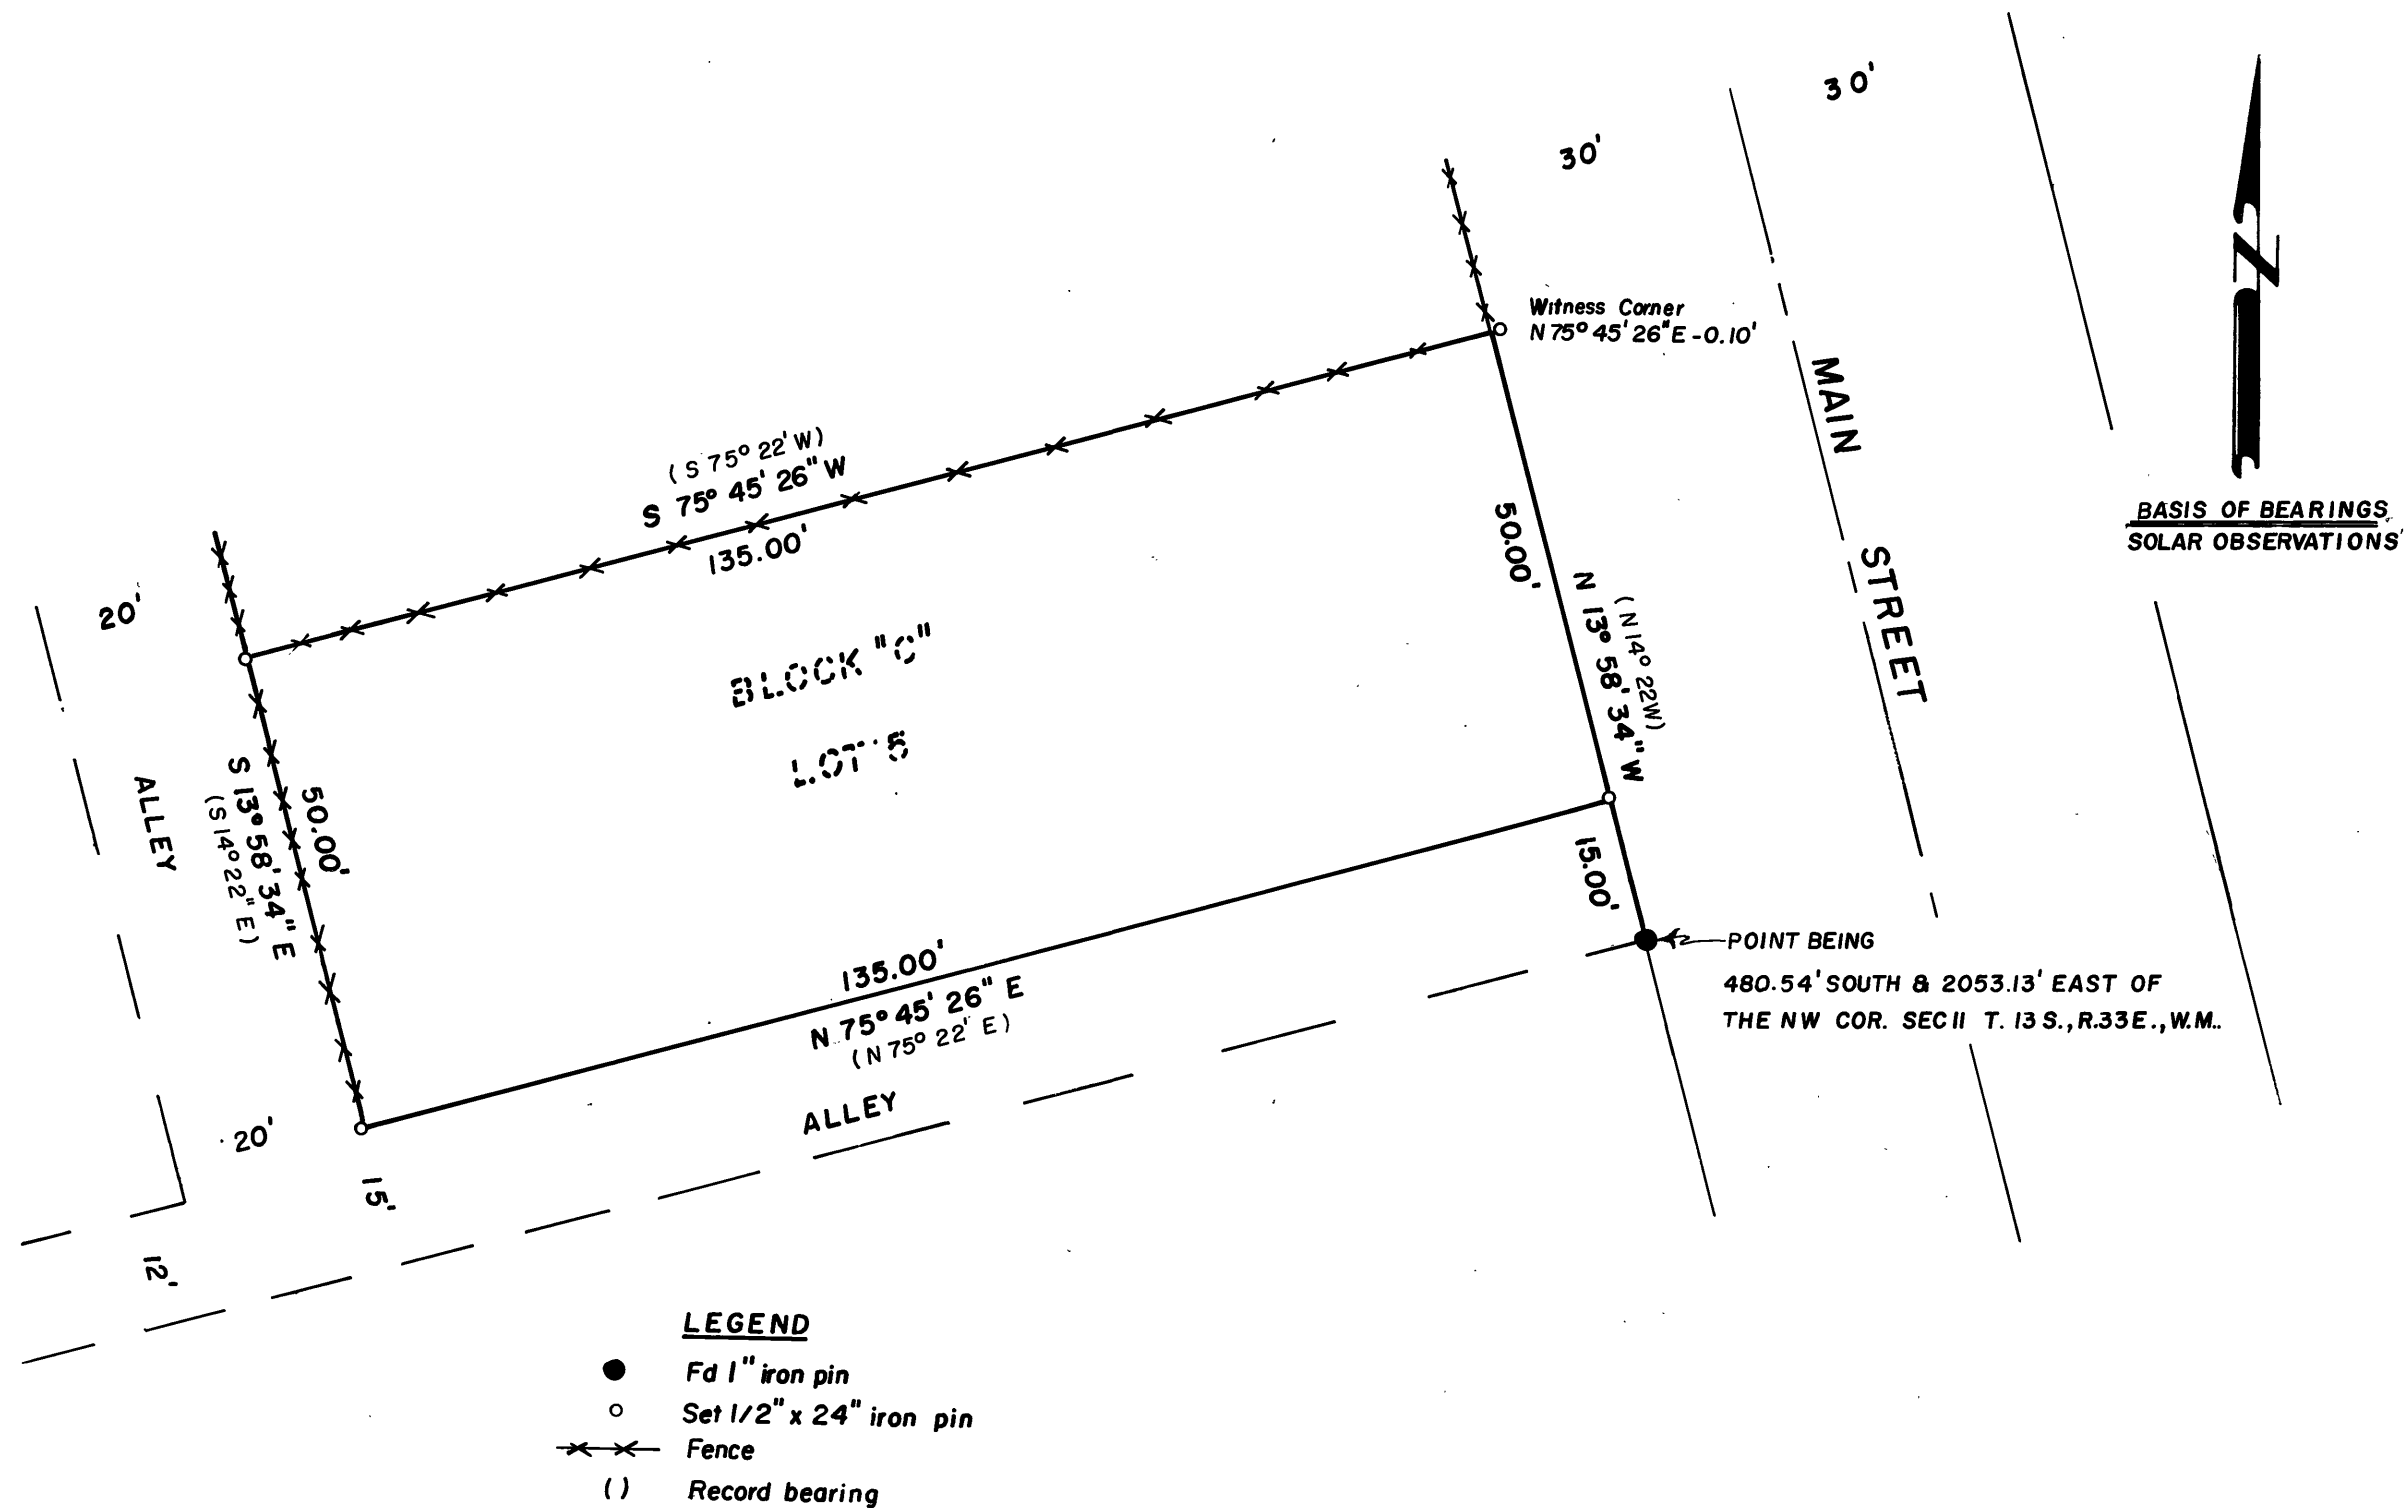

RECEIVED AND
FILED

FEB 22 1974

JOHN LIVEIRA, County Clerk

By *Betty Lowery* deputy

REGISTERED
PROFESSIONAL
LAND SURVEYOR

Robert D. Baggett

OREGON
JULY 11, 1969
ROBERT D. BAGGETT
598

BAGETT, GRIFFITH & ASSOCIATES

John Day, Oregon

Map of Survey

LOT 5, BLOCK C

BRADFORD LAYCOCK ADDITION TO

PRAIRIE CITY, OREGON

GRANT COUNTY, OREGON

SURVEYED FOR	J.N. SCHMIT	
SURVEYED BY	R.D.B., D.G., J.S.P.	2/15/74
Scale: 1" = 20'	Drawn by: JSP	2/16/74

SURVEY NO. 331