


SURVEY of MINING CLAIM BOUNDARY
 Mineral Survey No. 547
 Sec's 16 & 17, T10S, R35E W.M.
 Baker & Grant Counties, Oregon
 Wallowa Whitman National Forest
 Scale 1" = 400' Date 11-5-73

NOTE: True meridian used this survey is based on Line 1-2 of the Diadem claim of the original survey of 1903.

Variation 21'13" ± 22'45" East

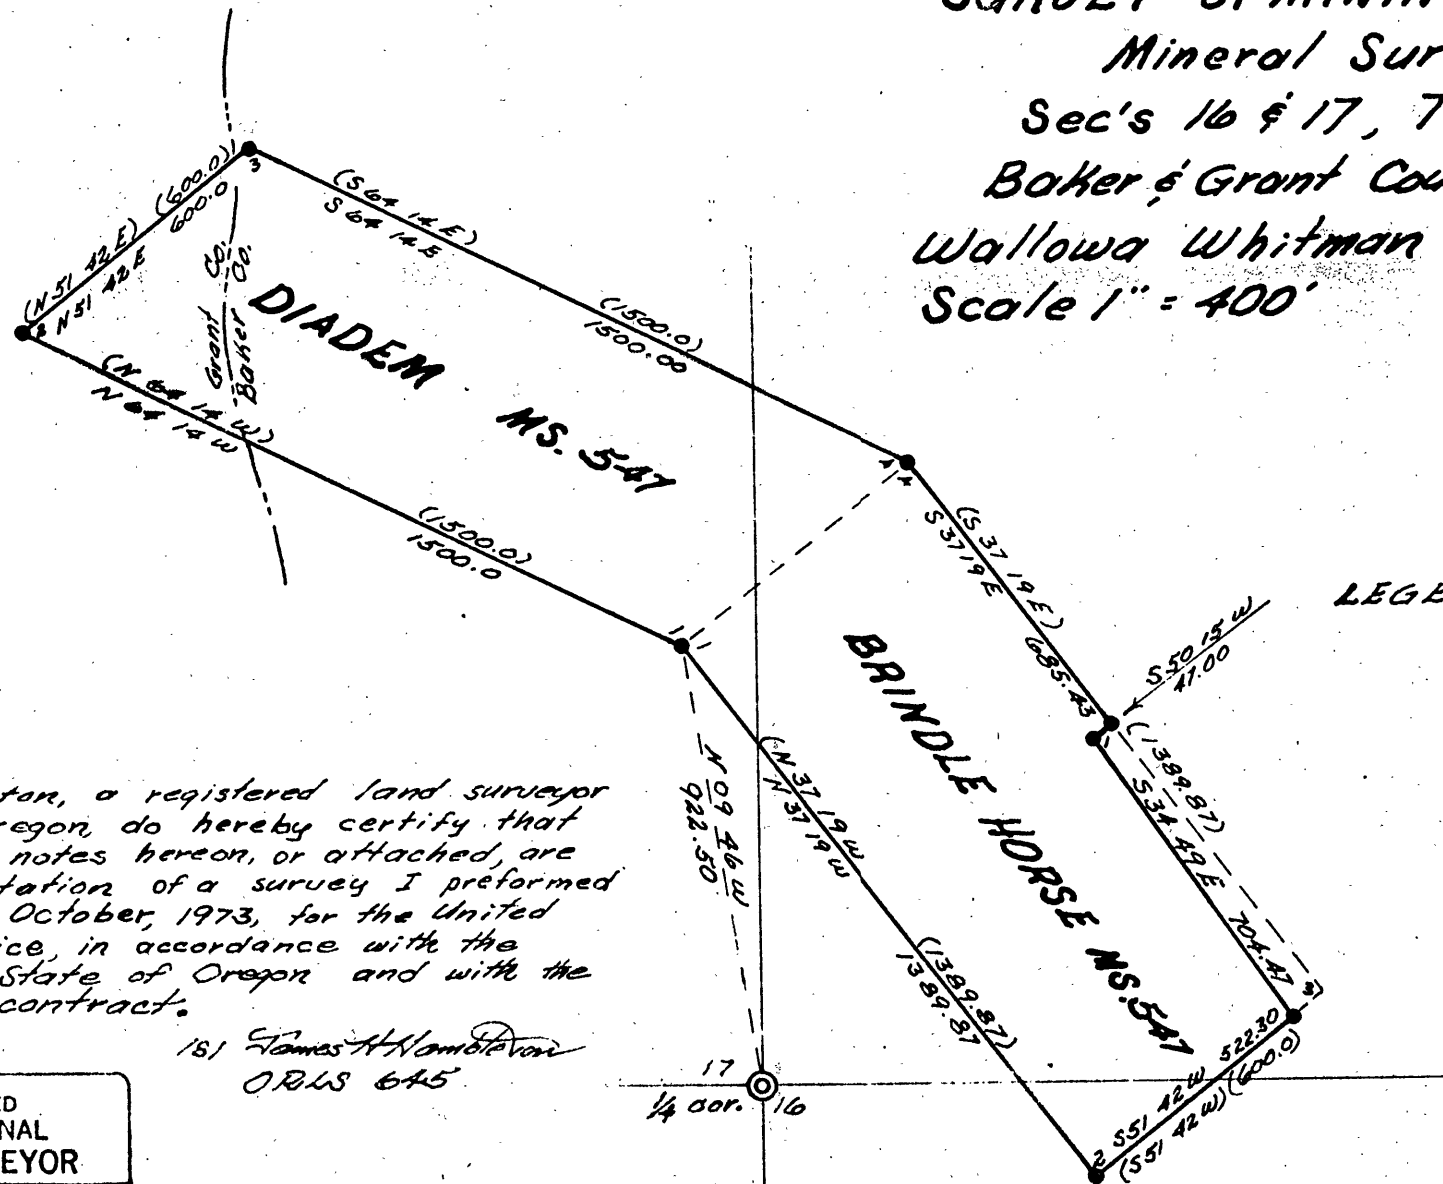

I, James H. Hambleton, a registered land surveyor in the State of Oregon, do hereby certify that this plat and the notes hereon, or attached, are a correct representation of a survey I performed during August thru October, 1973, for the United States Forest Service, in accordance with the statutes of the State of Oregon and with the Articles of my contract.

181 James H. Hambleton
 ORLS 645

REGISTERED
 PROFESSIONAL
 LAND SURVEYOR

James H. Hambleton

OREGON
 JULY 10, 1964
 JAMES H. HAMBLETON
 645

RECEIVED AND
FILED

APR 1 1974

JOHN LIVEIRA, County Clerk

By *Betty Lowery* Deputy

MAP OF SURVEY NO 332