
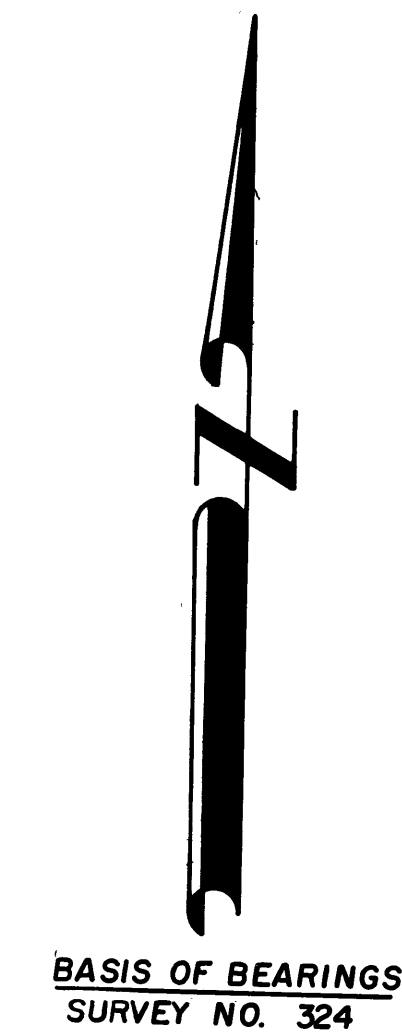


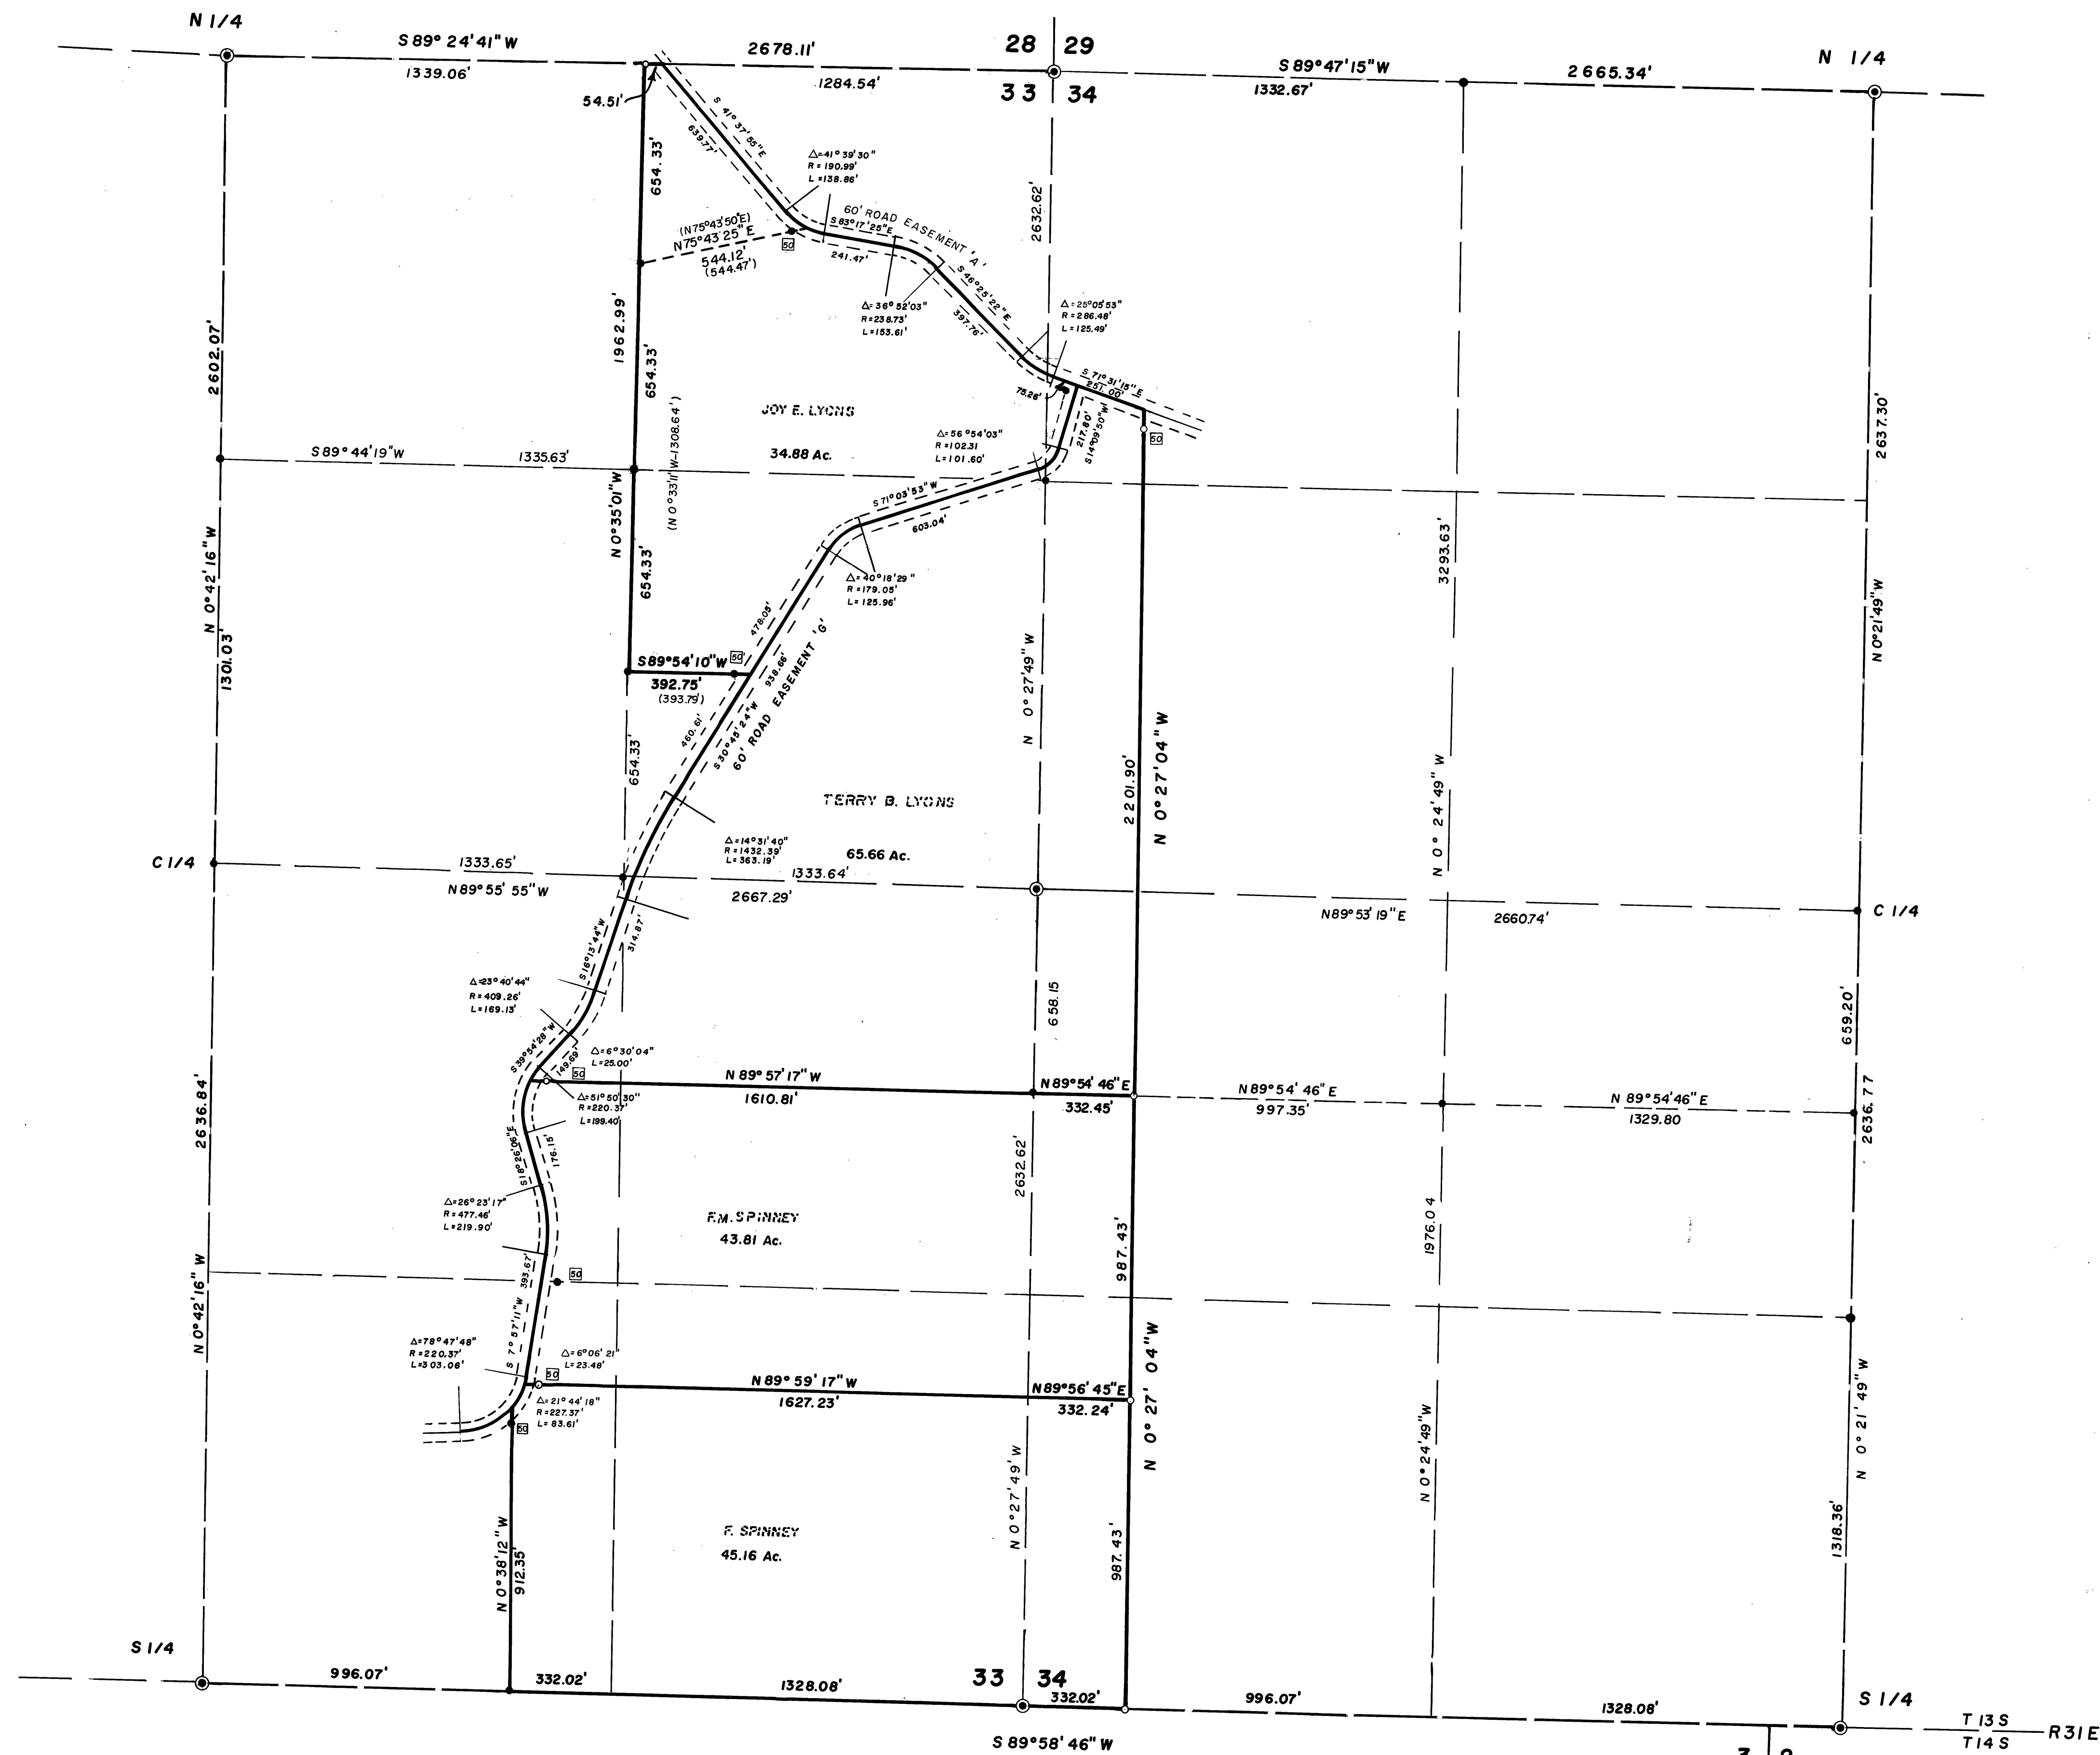

REFERENCE DATA
SURVEY NO. 324

LEGEND

- Fd. Brass Cap Monument (Survey No. 324)
- Fd. 5/8" Iron pin (Survey No. 324)
- Set 5/8" x 30" Iron pin
- () Record bearing and distance / Sur. No. 324
- Offset distance from centerline road to iron pin

NOTE:

True dimensions of tracts are shown.
Offset distances are not part of the
true dimensions.

REGISTERED
PROFESSIONAL
LAND SURVEYOR

Robert D. Bagett
OREGON
JULY 12, 1963
ROBERT D. BAGETT
598

BAGETT, GRIFFITH & ASSOCIATES		
John Day, Oregon		
Map of Survey		
TRACTS SITUATED IN		
SECTIONS 33, 34		
T. 13 S., R. 31 E., W. 4 M.		
GRANT COUNTY, OREGON		
SURVEYED FOR	RLC INVEST. INC. & TERRY LYONS	
SURVEYED BY	R.D.B., J.S.P.	3/74
Scale: 1" = 300'	Drawn by: J.S.P.	4/74

RECEIVED AND
FILED

APR 23 1974

JOHN LIVEIRA, County Clerk

By *Barbara Simon* Deputy