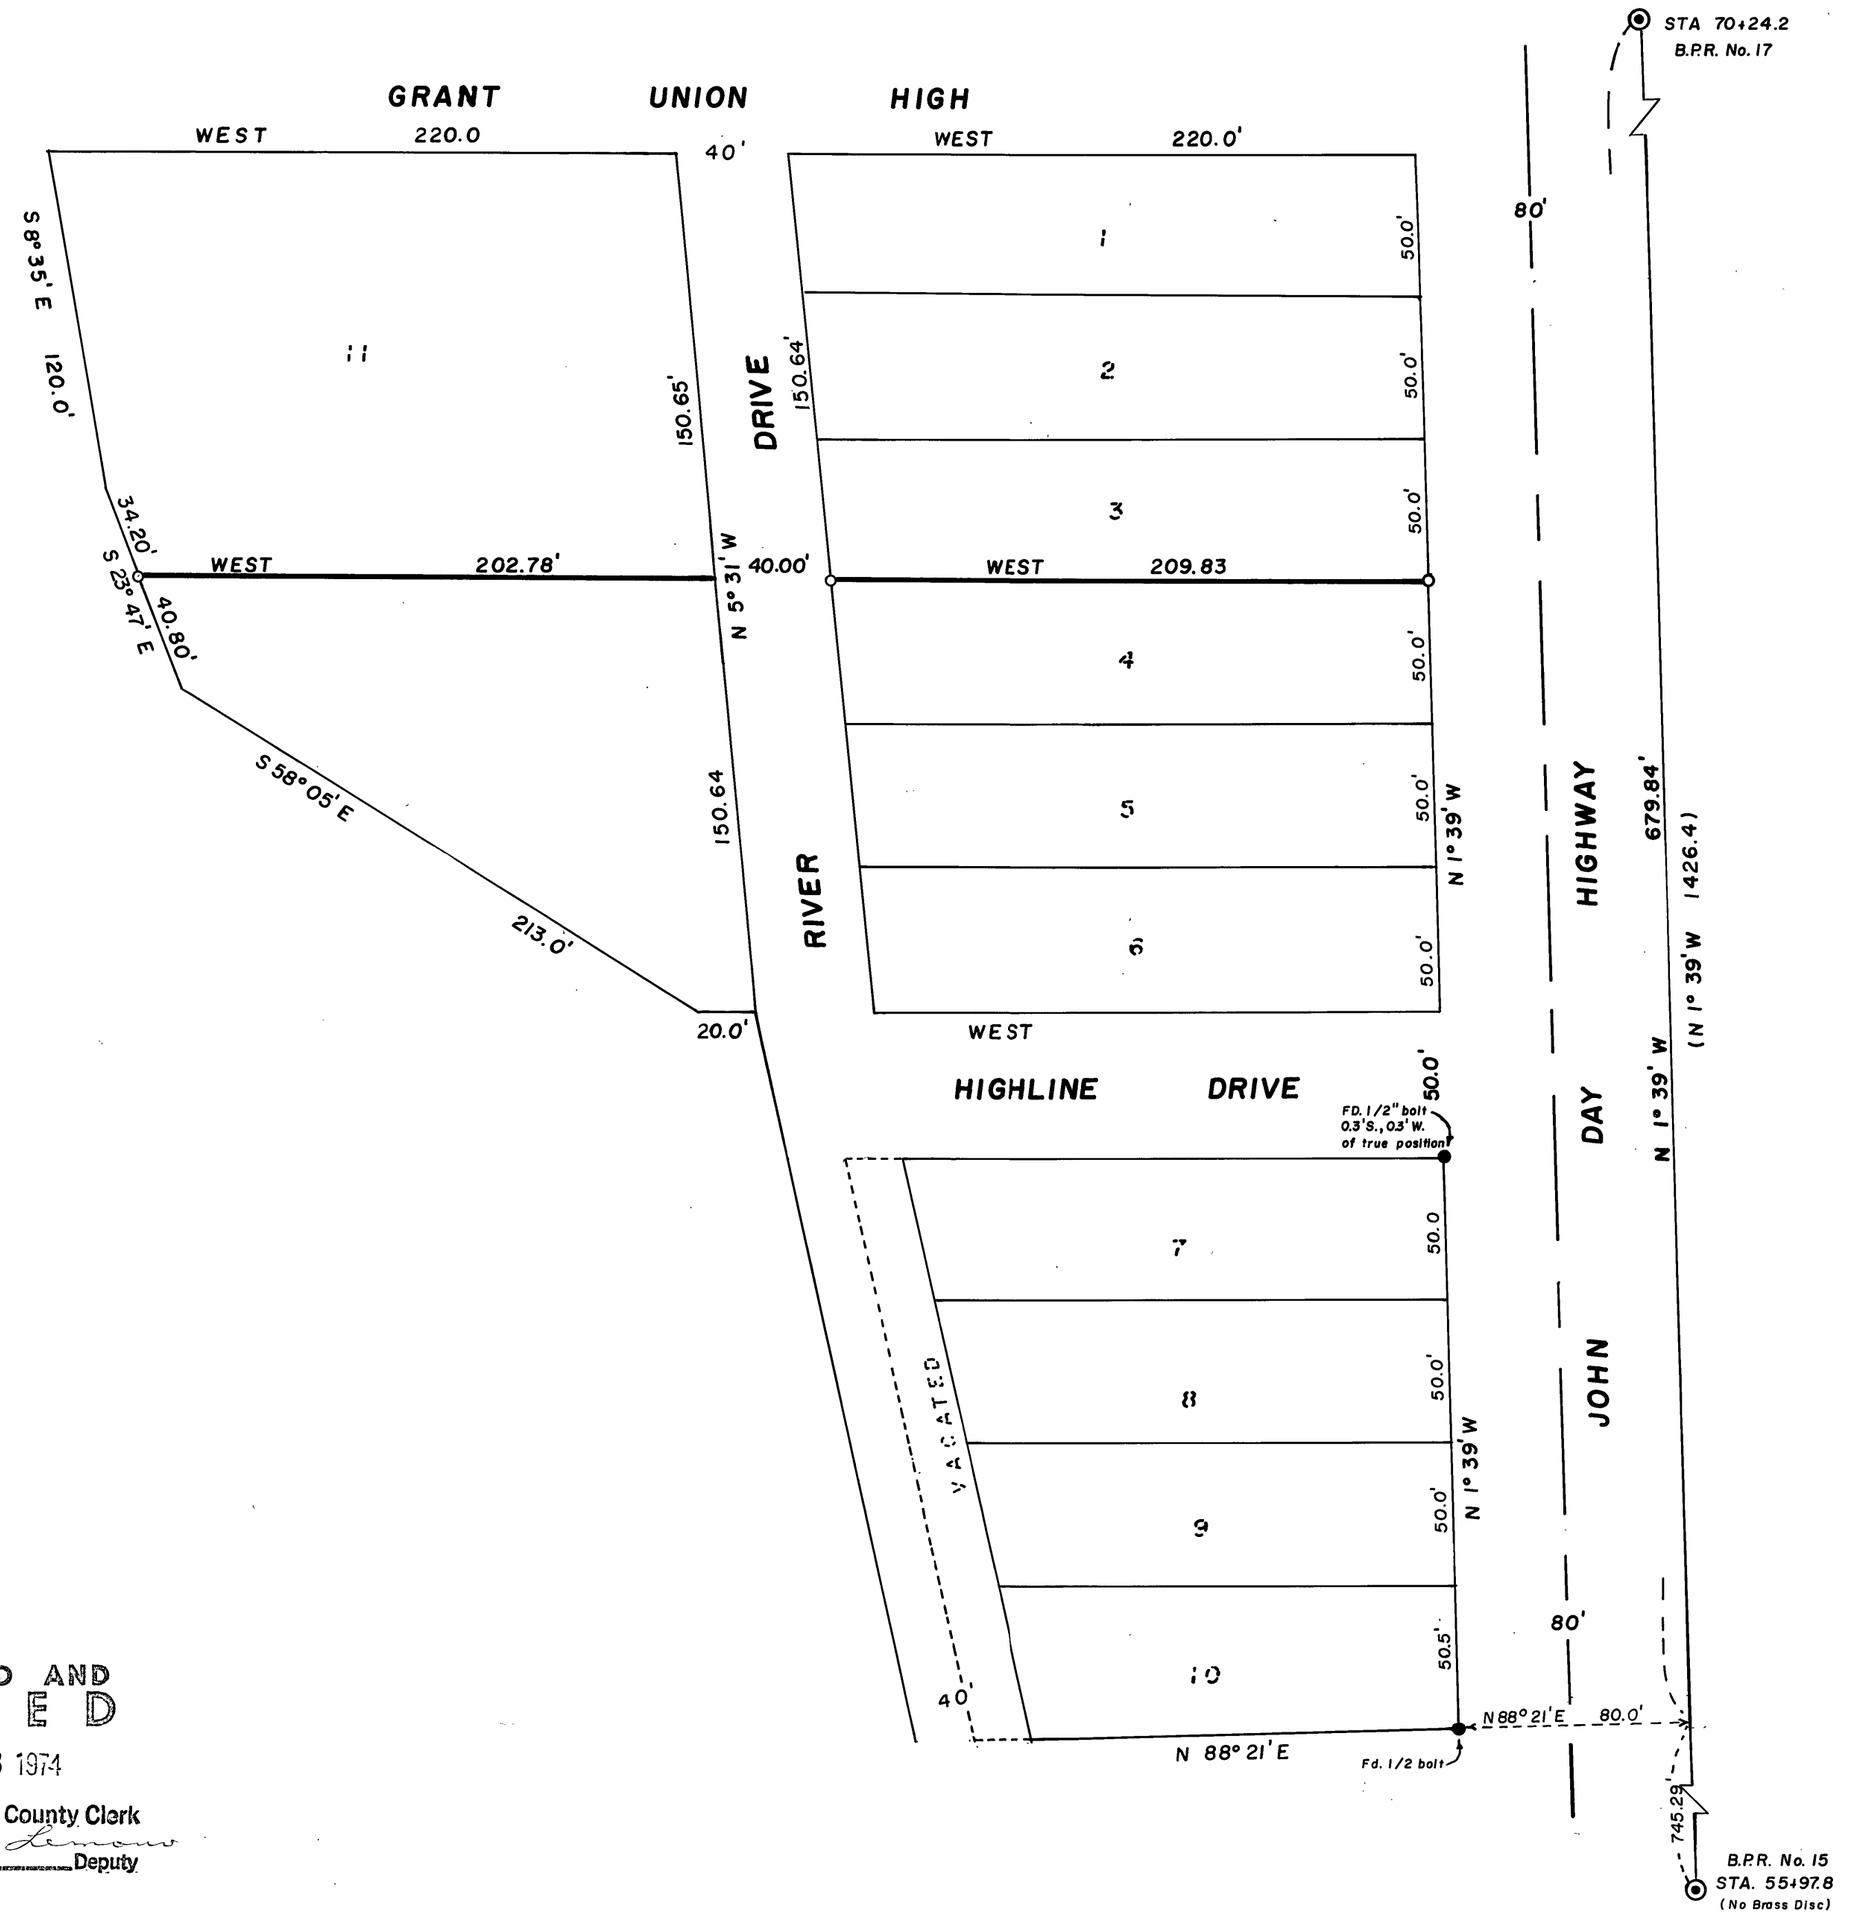

BASIS OF BEARINGS
RECORD BEARING BETWEEN
B.P.R. MONUMENTS
15 & 17

LEGEND

- Found B.P.R. Monument - 10" concrete post
- Found 1/2" bolt
- Set 5/8" x 30" iron pin
- ( ) Record bearing and distance

REGISTERED
PROFESSIONAL
LAND SURVEYOR
Robert D. Bagett
OREGON
JULY 12, 1963
ROBERT D. BAGETT
598

RECEIVED AND
FILED
APR 23 1974
JOHN LIVEIRA, County Clerk
By Darlene Lemons Deputy

BAGETT, GRIFFITH & AS	
John Day, Oregon	
Map of Survey	
HIGHWAY ADDITIO	
CANYON CITY	
GRANT COUNTY, OREGO	
SURVEYED FOR	GRANT CO. SCHO
SURVEYED BY	R.D.B., J.S.P.
Scale: 1" = 50'	Drawn by: J.S.

MAP OF SURVEY 3