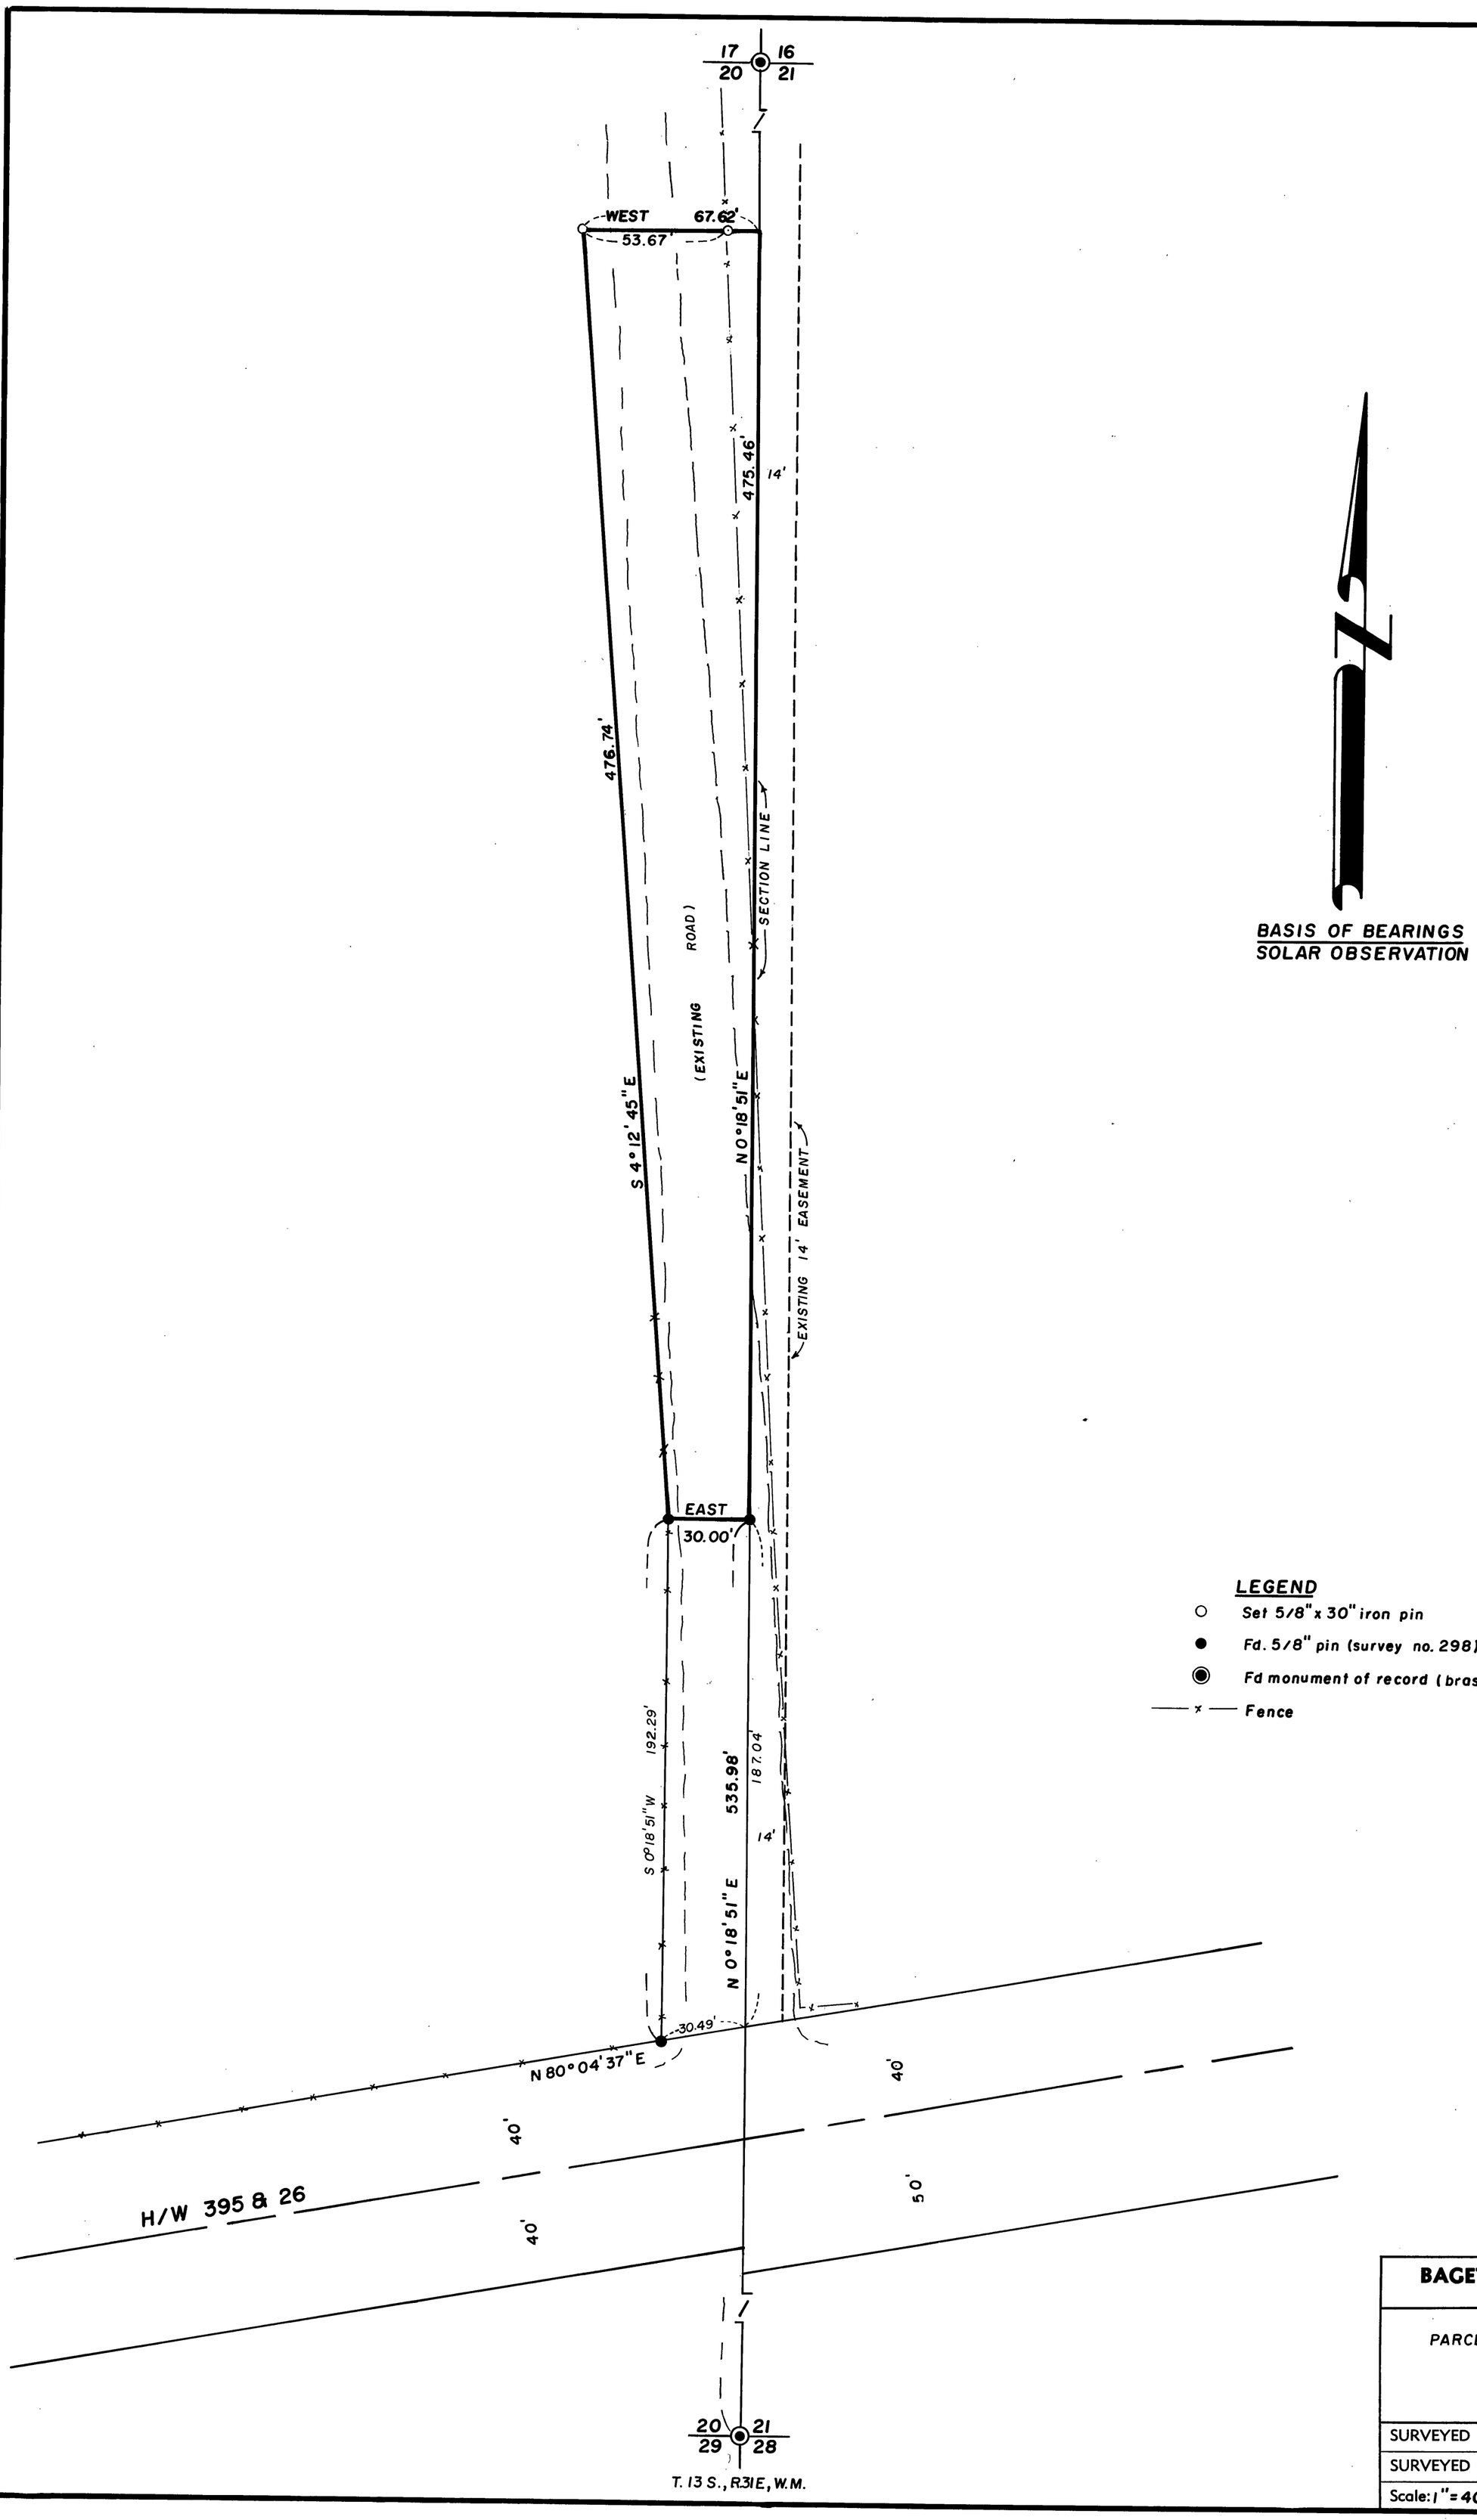


BASIS OF BEARINGS
SOLAR OBSERVATION

**LEGEND**

- ○ Set 5/8" x 30" iron pin
- ● Fd. 5/8" pin (survey no. 298)
- ◉ Fd monument of record (brass cap)
- —x— Fence

RECEIVED AND
FILED
JUN 10 1974
JOHN LIVEIRA, County Clerk
By Betty Lowry Deputy

REGISTERED
PROFESSIONAL
LAND SURVEYOR

Robert D. Bagett

OREGON
JULY 12, 1963
ROBERT D. BAGETT
598

**BAGETT, GRIFFITH & ASSOCIATES**
**John Day, Oregon**

Map of Survey

PARCEL IN THE SE.1/4 OF THE SE.1/4
SECTION 20
T.13S., R.31E., W.M.

GRANT COUNTY, OREGON

| | | |
|---|---|---|
| SURVEYED FOR | GRANT COUNTY ROAD DEPT. | |
| SURVEYED BY | R.D.B., J.S.P. | 4/74 |
| Scale: 1" = 40' | Drawn by: J.S.P. | 4/74 |

SURVEY NO. 338