

TELEPHONE 573-6451


MARC PALMER
REGISTERED LAND SURVEYOR
254 N. ALDER
BURNS, OREGON 97720

342

1/6

CITY OF SENECA
GRANT COUNTY,
OREGON

Brass Monument set in
concrete in metal
Monument Box

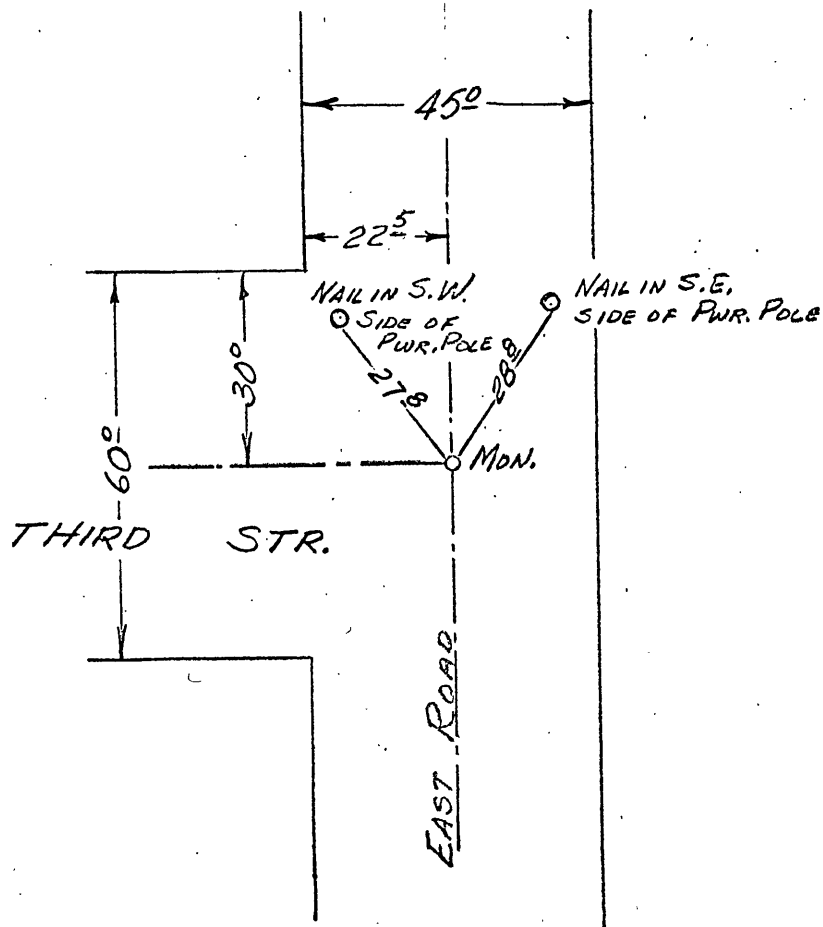

REGISTERED
PROFESSIONAL
LAND SURVEYOR

Macalmer 5/10/74

OREGON
MAY 6, 1955
M. A. PALMER
350

RECEIVED AND
FILED

JUN 10 1974

JOHN LIVEIRA, County Clerk

By: *Detty Lowery* Deputy

342