

MARC PALMER


REGISTERED LAND SURVEYOR

254 N. ALDER

BURNS, OREGON 97720

CITY OF SENECA
GRANT COUNTY,
OREGON

Brass Monuments set in
concrete within metal
monument box

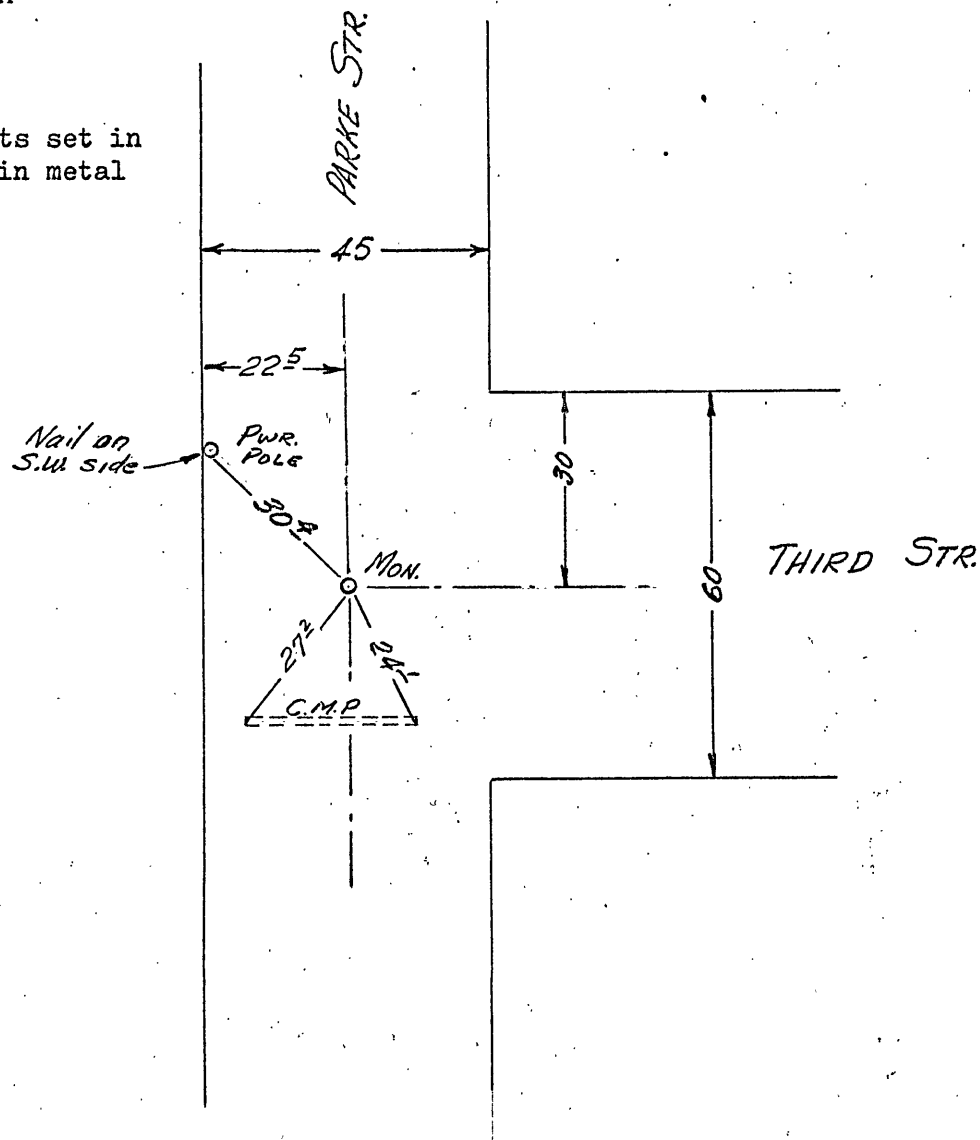

RECEIVED AND
FILED

JUN 10 1974

JOHN LIVEIRA County Clerk

By Petty Officer Deputy

**REGISTERED
PROFESSIONAL
LAND SURVEYOR**

McAlister 5/10/74

OREGON
MAY 6, 1935
M. A. PALMER
350