


TELEPHONE 573-6451

MARC PALMER
REGISTERED LAND SURVEYOR
254 N. ALDER
BURNS, OREGON 97720

CITY OF SENECA
GRANT COUNTY,
OREGON

Brass Monuments set in
concrete in metal
Monument Box

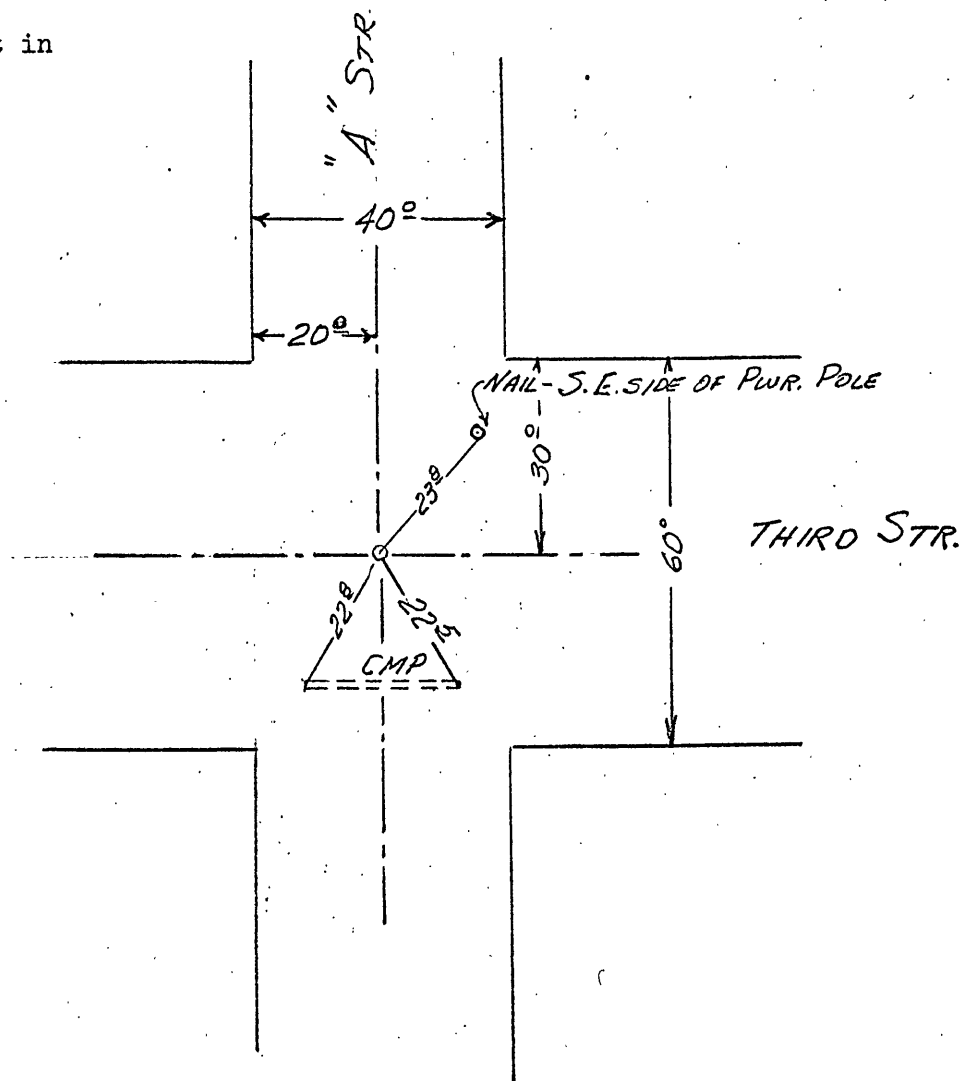

RECEIVED AND
FILED

JUN 10 1974

JOHN LIVEIRA, County Clerk
By *[Signature]* Deputy

REGISTERED
PROFESSIONAL
LAND SURVEYOR

M. A. Palmer 5/10/74

OREGON
MAY 6, 1985
M. A. PALMER
350