


MARC PALMER
REGISTERED LAND SURVEYOR
254 N. ALDER
BURNS, OREGON 97720

CITY OF SENECA
GRANT COUNTY
OREGON

Brass Monuments set in
concrete within metal
Monument box

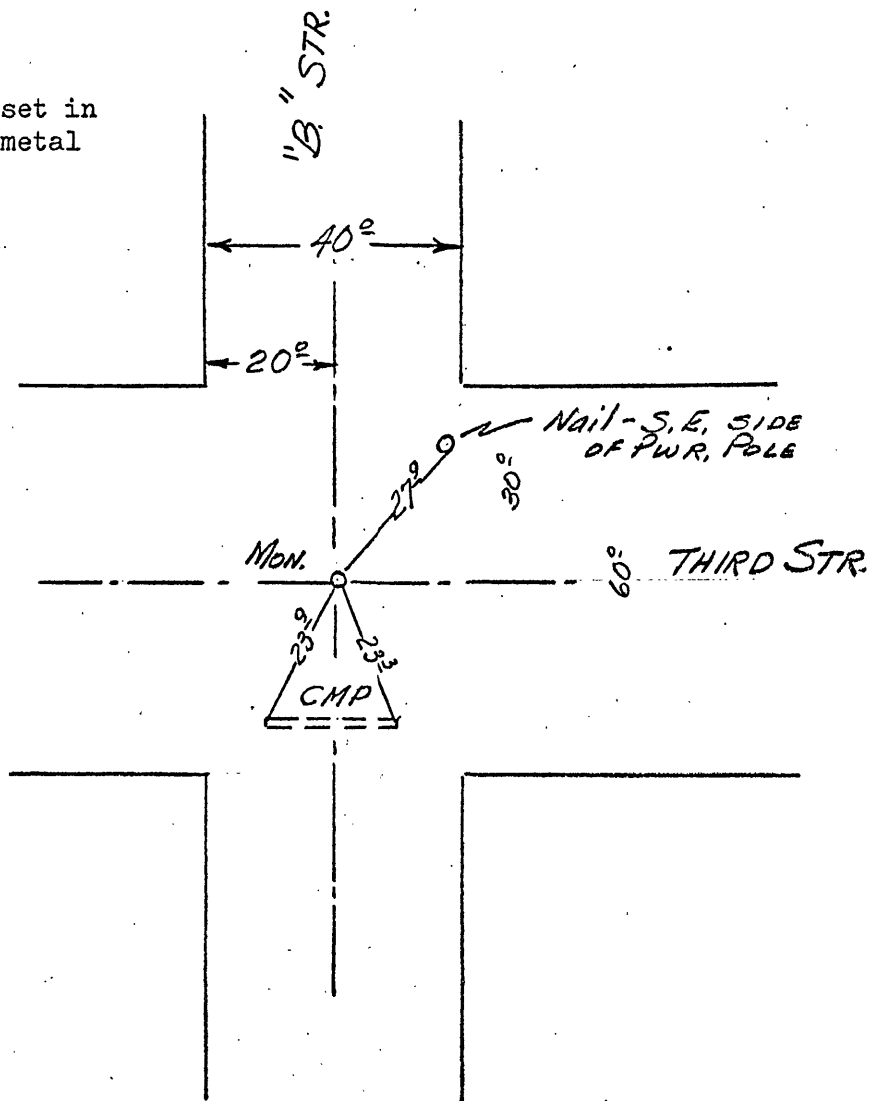

RECEIVED AND
FILED

JUN 10 1974

JOHN LIVEIRA, County Clerk


REGISTERED
PROFESSIONAL
LAND SURVEYOR

Mathew 5/10/74

OREGON
MAY 6, 1955
M. A. PALMER
350