


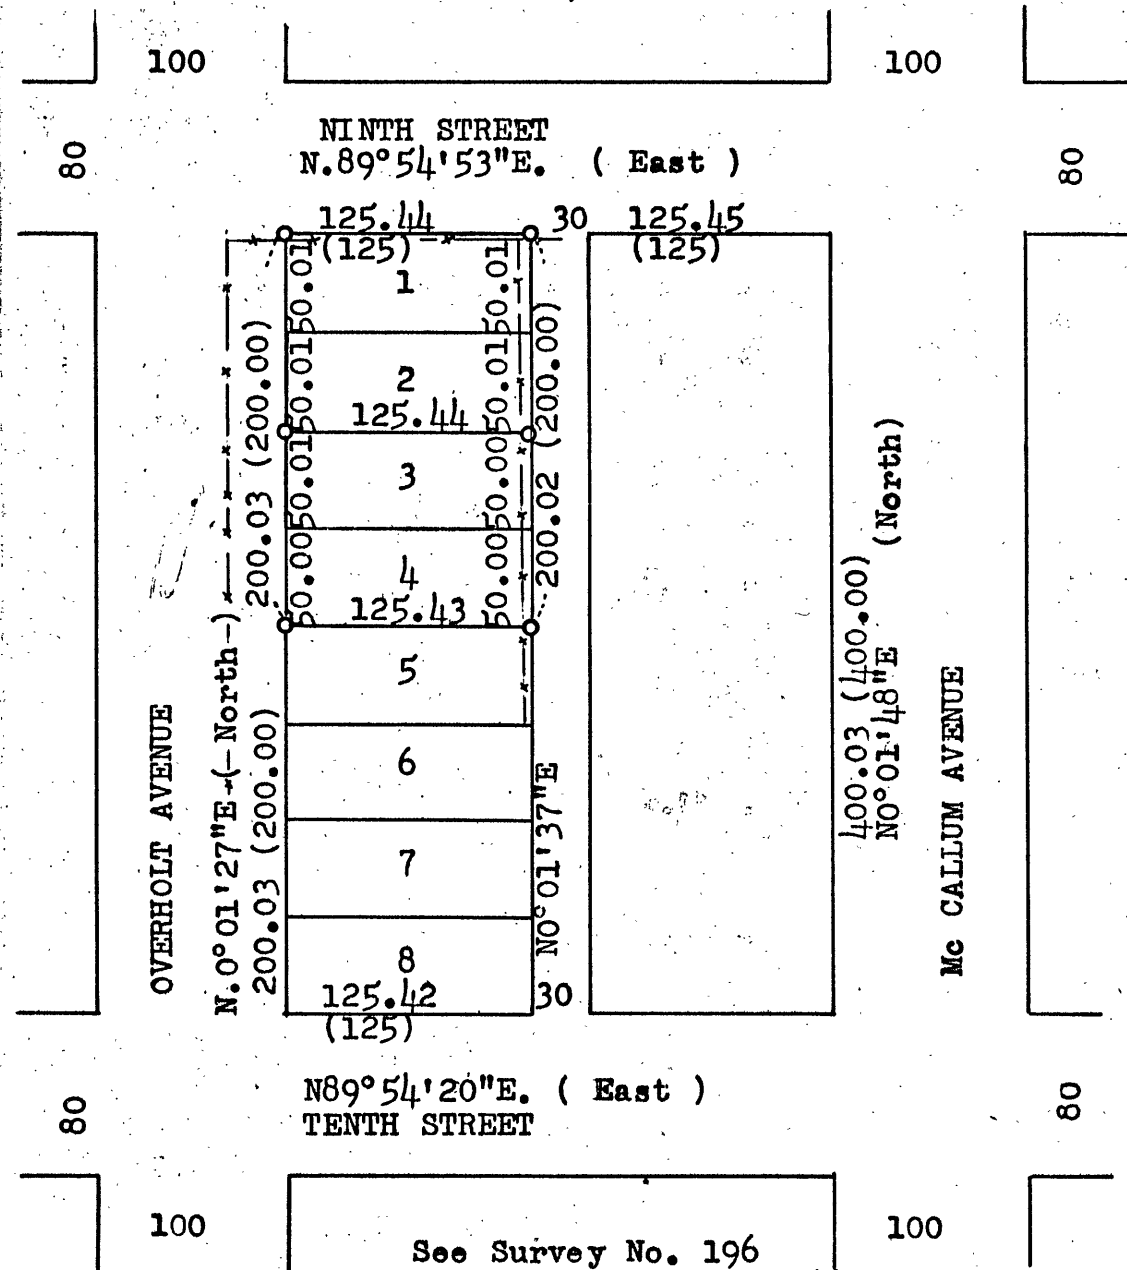

RECEIVED AND
FILED

AUG 28 1974
JOHN LIVEIRA, County Clerk
By _____ Deputy

REGISTERED
PROFESSIONAL
LAND SURVEYOR

ROBERT D. BAGETT
JULY 12, 1963
OREGON
598

BASIS OF BEARINGS
SURVEY NO.196

LEGEND

- o Set 5/8"x30" iron pin
- Fence
- (*) Record Bearing & Distance.

BAGETT, GRIFFITH & ASSOCIATES

John Day, Oregon

Map of Survey

A PORTION OF BLOCK 42 OF THE PRAIRIE
CITY LAND COMPANY FIRST ADDITION TO
THE CITY OF PRAIRIE CITY,

GRANT COUNTY, OREGON

SURVEYED FOR	LARRY WRIGHT	
SURVEYED BY	R.D.B.	8/1974
Scale: 1"-100'	Drawn by: R.D.B.	8/1974