


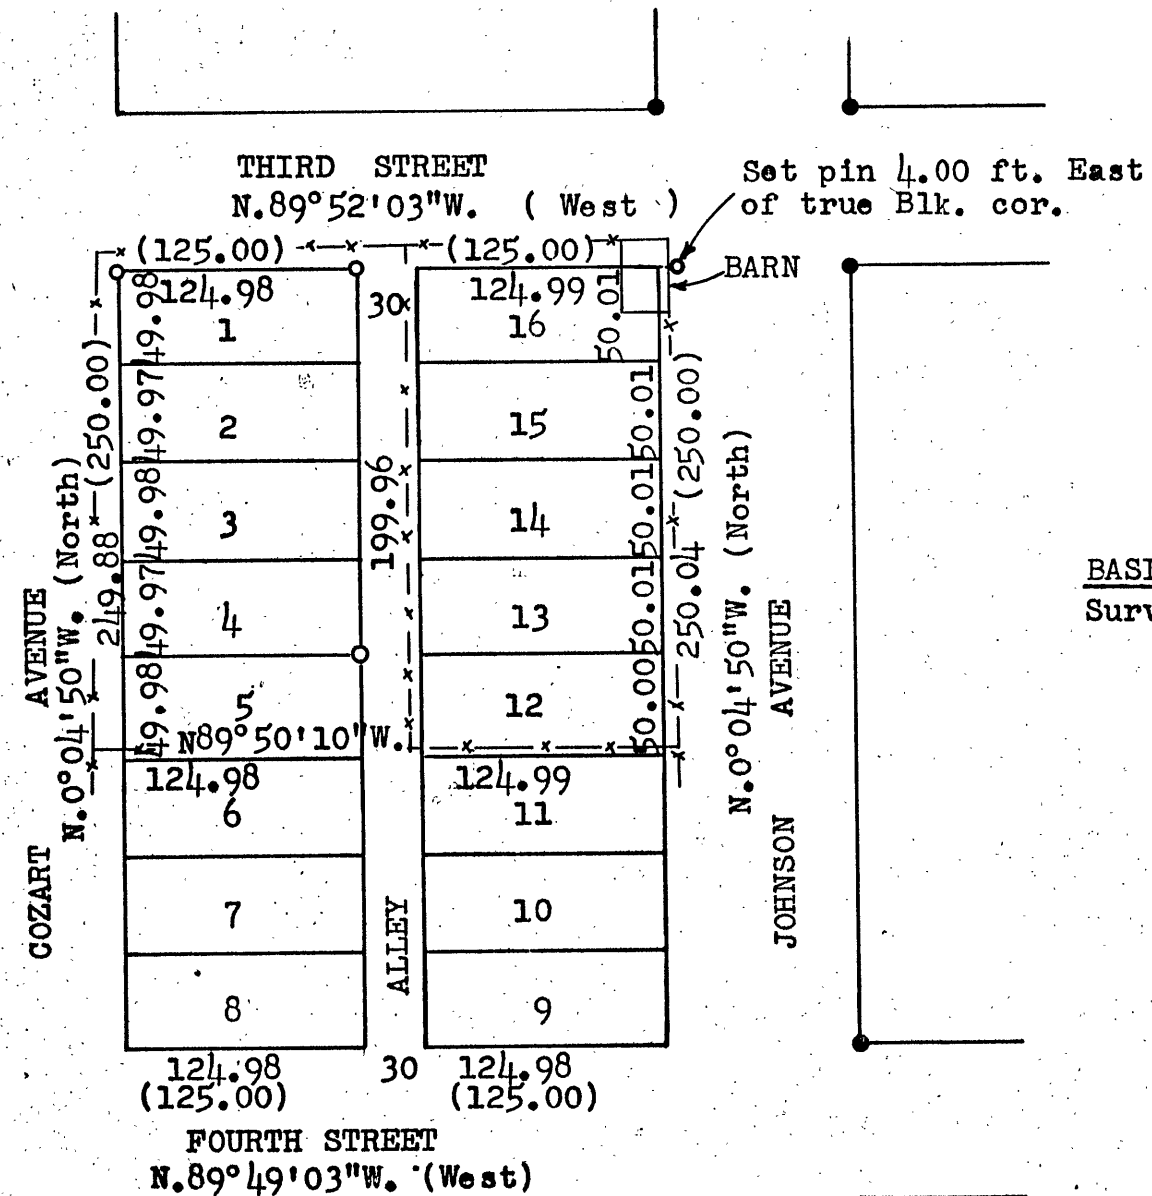

RECEIVED AND
FILED

AUG 28 1974
JOHN LIVEIRA, County Clerk

By _____ Deputy

REGISTERED
PROFESSIONAL
LAND SURVEYOR

Robert D. Baggett

OREGON
JULY 12, 1963
ROBERT D. BAGGETT
598

BASIS OF BEARINGS
Survey No. 138

LEGEND

- () Record bearing & Distance.
- Fd. monument of record.
- Set 5/8"x30"iron pin.
- x- Fence

BAGETT, GRIFFITH & ASSOCIATES

John Day, Oregon

Map of Survey

A PORTION OF BLOCK 14 OF THE
CLEAVER-COZART ADDITION TO THE
CITY OF PRAIRIE CITY,

GRANT COUNTY, OREGON

SURVEYED FOR	HARRY MORRIS	
SURVEYED BY	R.D.B.	8/1974
Scale: 1"=100'	Drawn by: R.D.B.	8/1974