


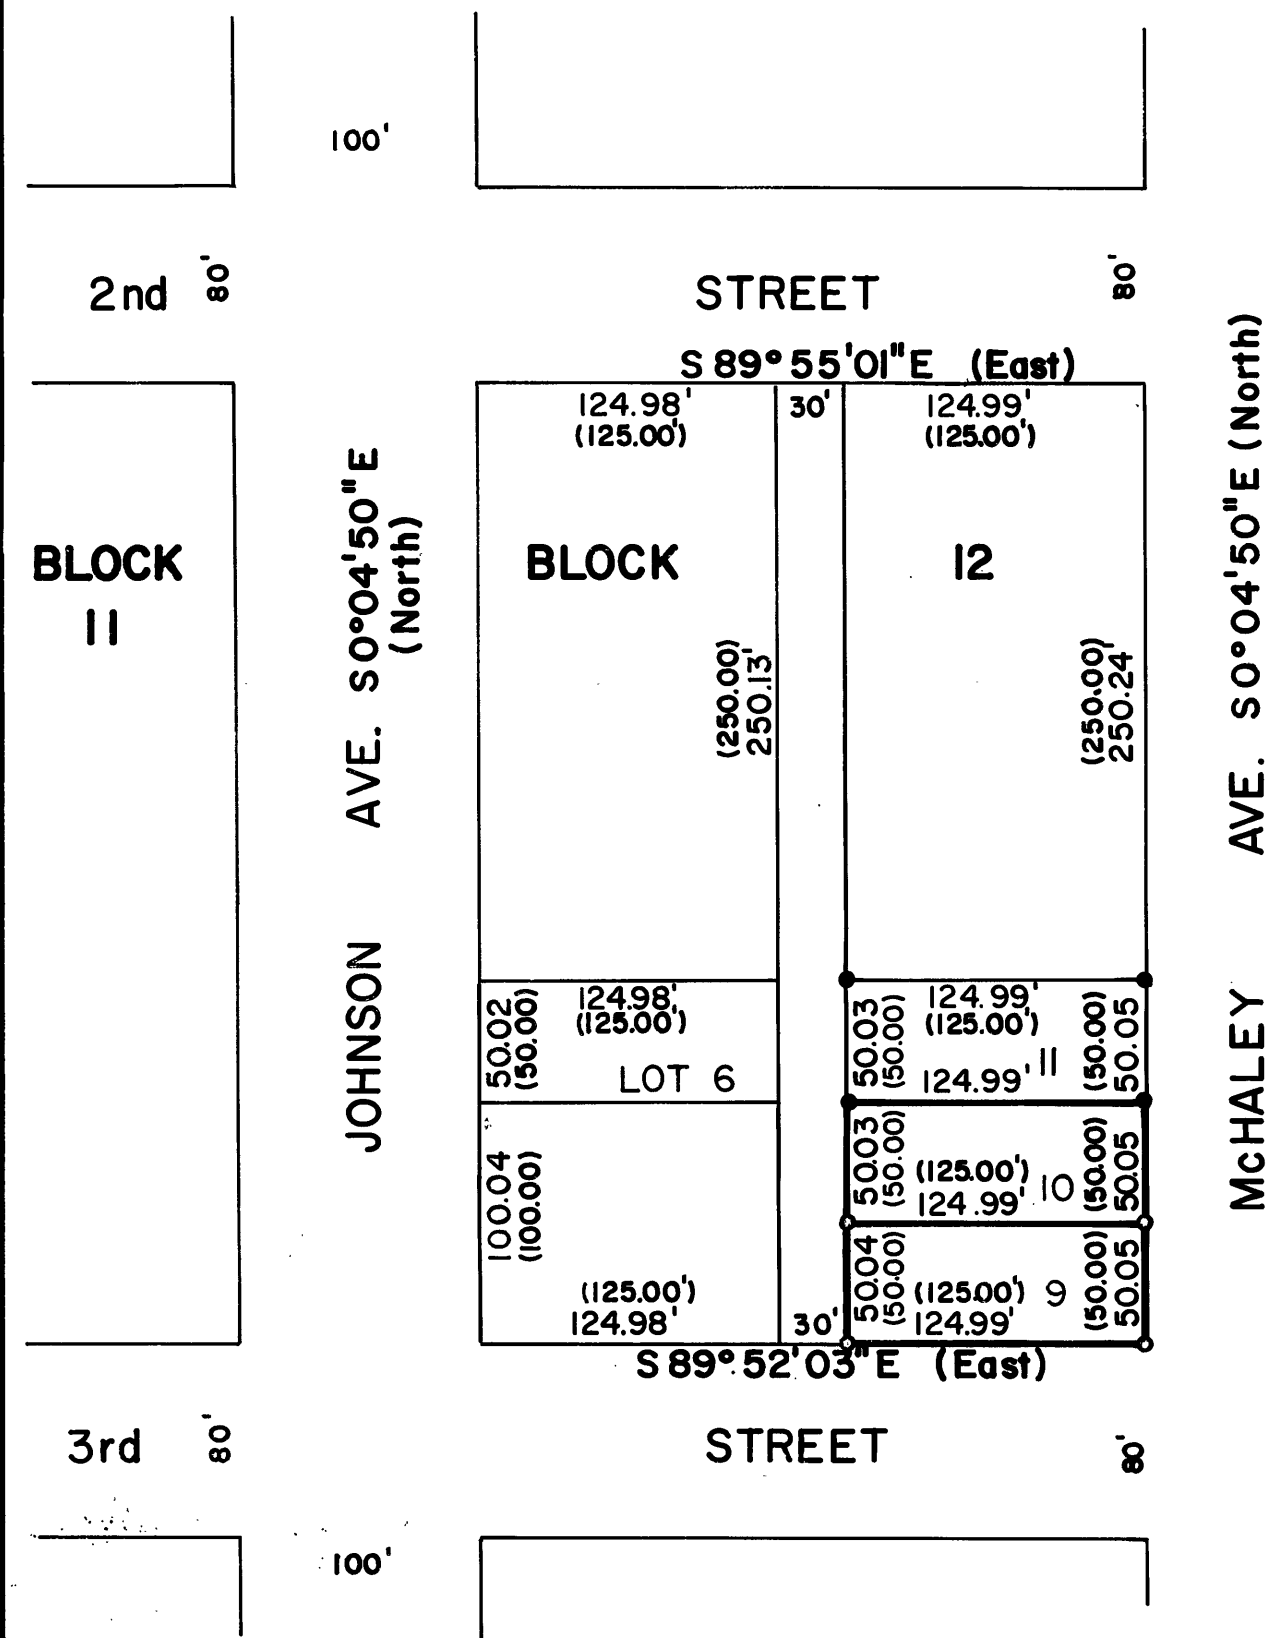


REFERENCE MATERIAL

Map of Survey No. 113
 Map of Survey No. 308

LEGEND

- Found Monument
- Set 5/8" x 30" iron pin
- () Record Bearing & Distance

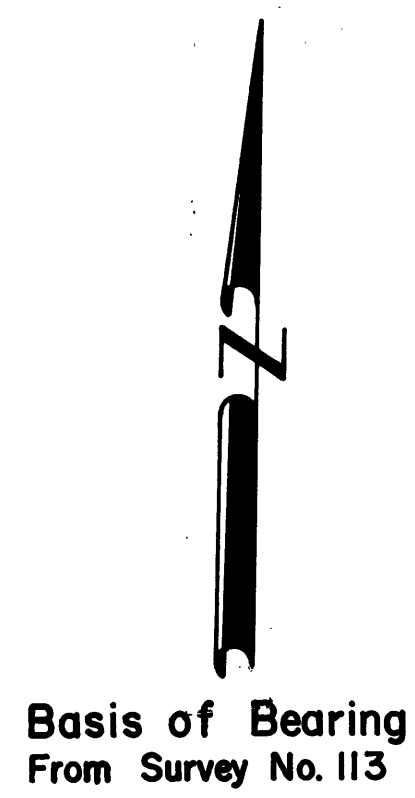

RECEIVED AND
FILED
 AUG 28 1974
John Livera
 JOHN LIVERA, County Clerk
 Deputy

REGISTERED
 PROFESSIONAL
 LAND SURVEYOR
Robert D. Bagett
 OREGON
 JULY 12, 1963
 ROBERT D. BAGETT
 598

BAGETT, GRIFFITH & ASSOCIATES		
John Day, Oregon		
Map of Survey		
LOTS 9 & 10, BLOCK 12		
CLEAVER & COZART ADDITION		
TO PRAIRIE CITY, GRANT COUNTY, OREGON		
SURVEYED FOR	ED LANGSETH	
SURVEYED BY	R.D.B. & R.B.C.	8/19/74
Scale: 1" = 80'	Drawn by: R.B.C.	8/21/74