T. 13 S., R. 33 E., W.M.

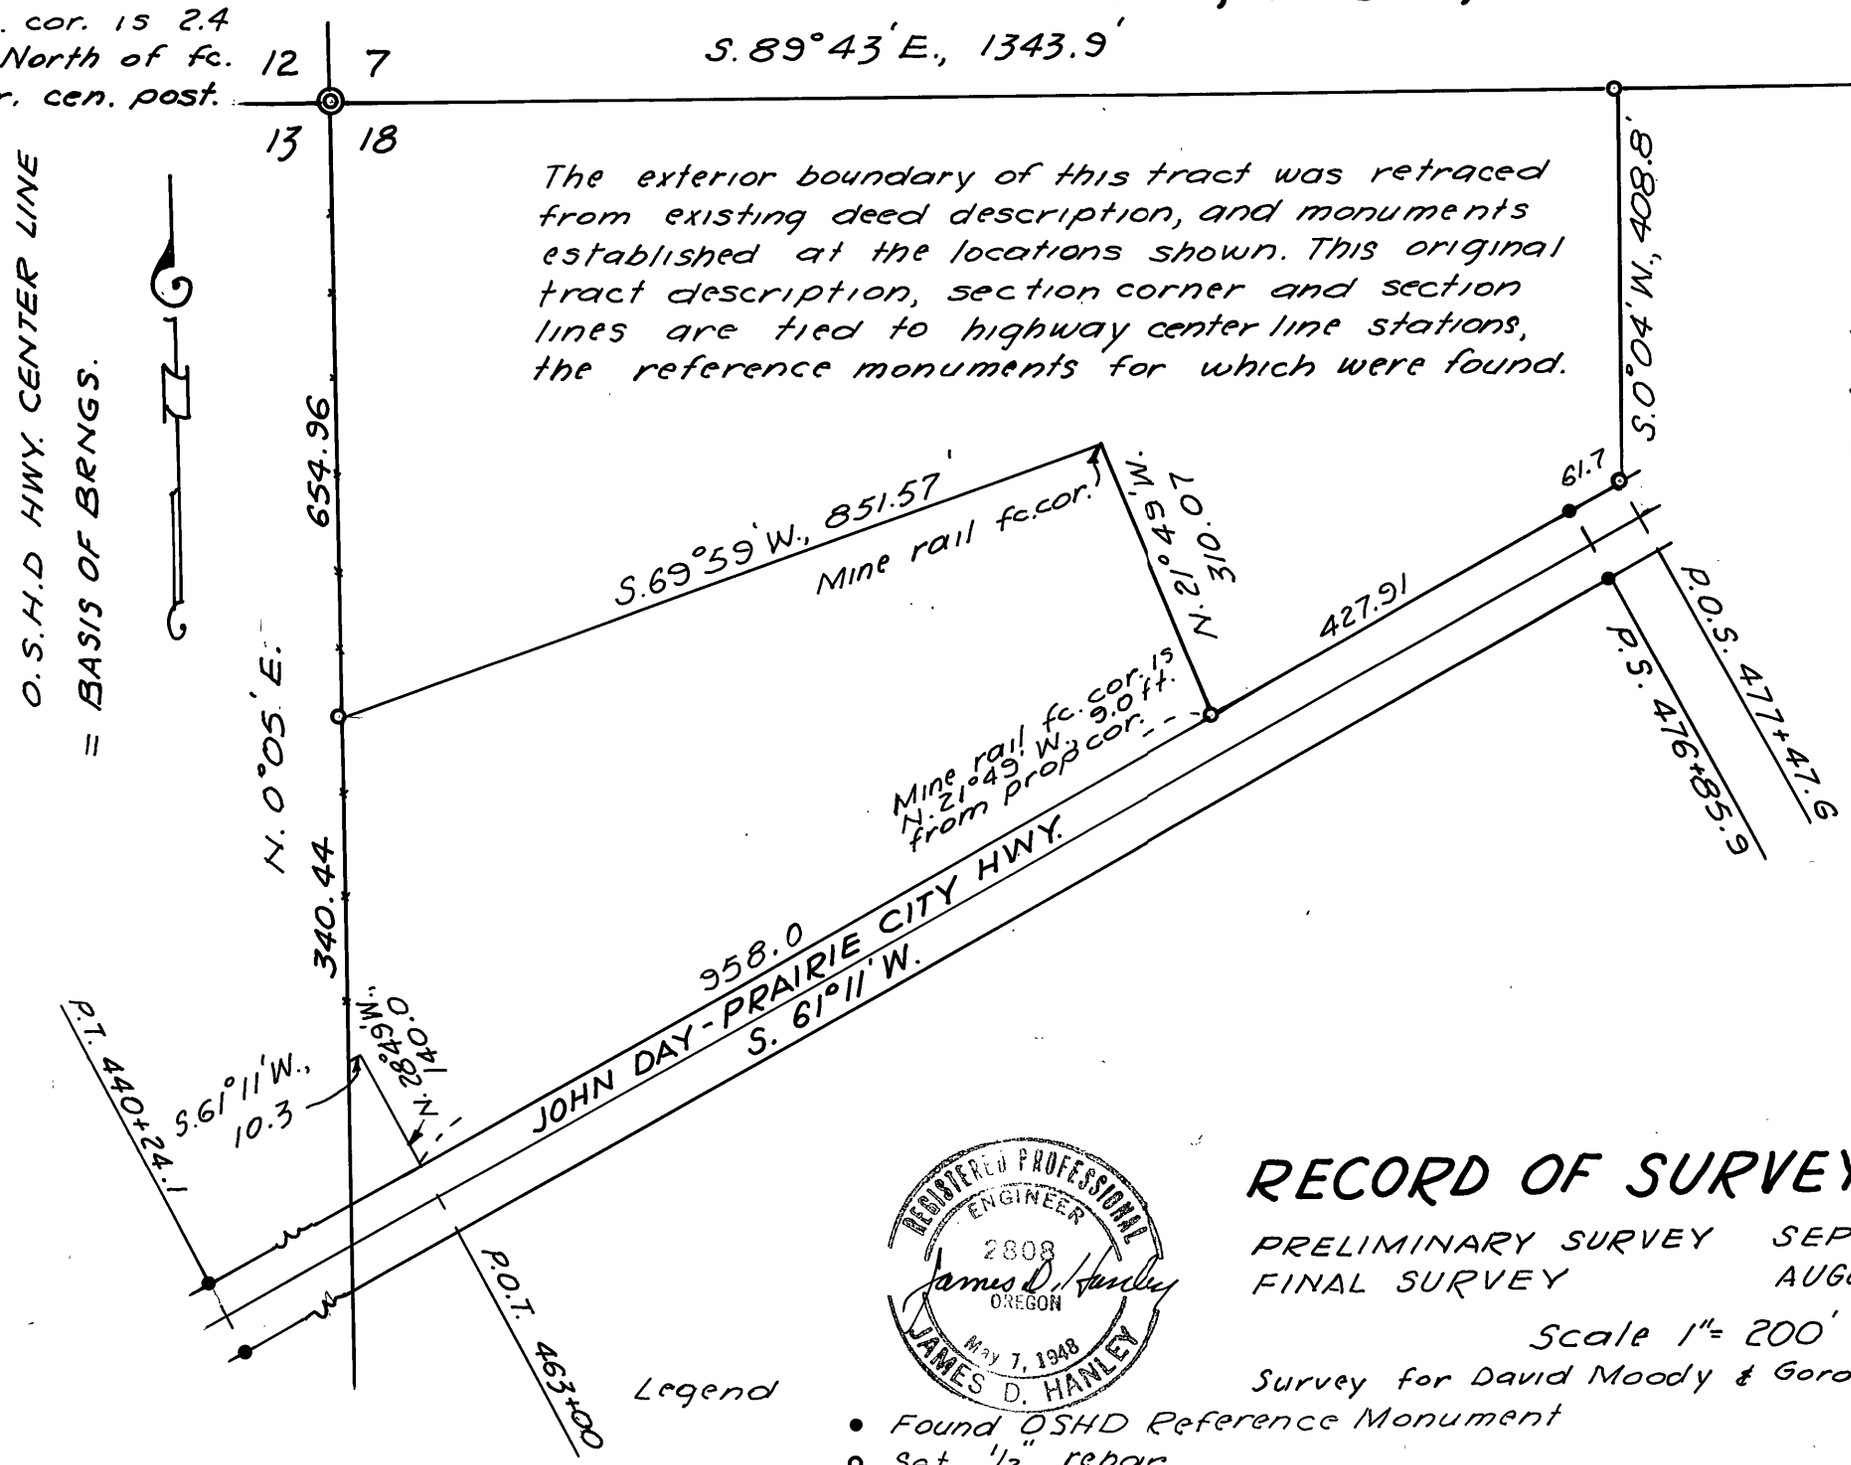

The exterior boundary of this tract was retraced from existing deed description, and monuments established at the locations shown. This original tract description, section corner and section lines are tied to highway center line stations, the reference monuments for which were found.

RECEIVED AND FILED

SEP 9 1974

JOHN LIVEIRA, County Clerk

By Betty Lowery, Deputy

REGISTERED PROFESSIONAL ENGINEER
2808
James D. Hanley
OREGON
May 1, 1948
JAMES D. HANLEY

RECORD OF SURVEY PLAT

PRELIMINARY SURVEY SEPT. 8, 1973
FINAL SURVEY AUGUST 9, 1974

Scale 1" = 200'

Survey for David Moody & Gordon Mitchell

Legend

- Found OSHD Reference Monument
- o Set 1/2" rebar
- ◎ Set 1" iron pipe w/ 2" stamped alum. cap

Map of Survey No. 349