


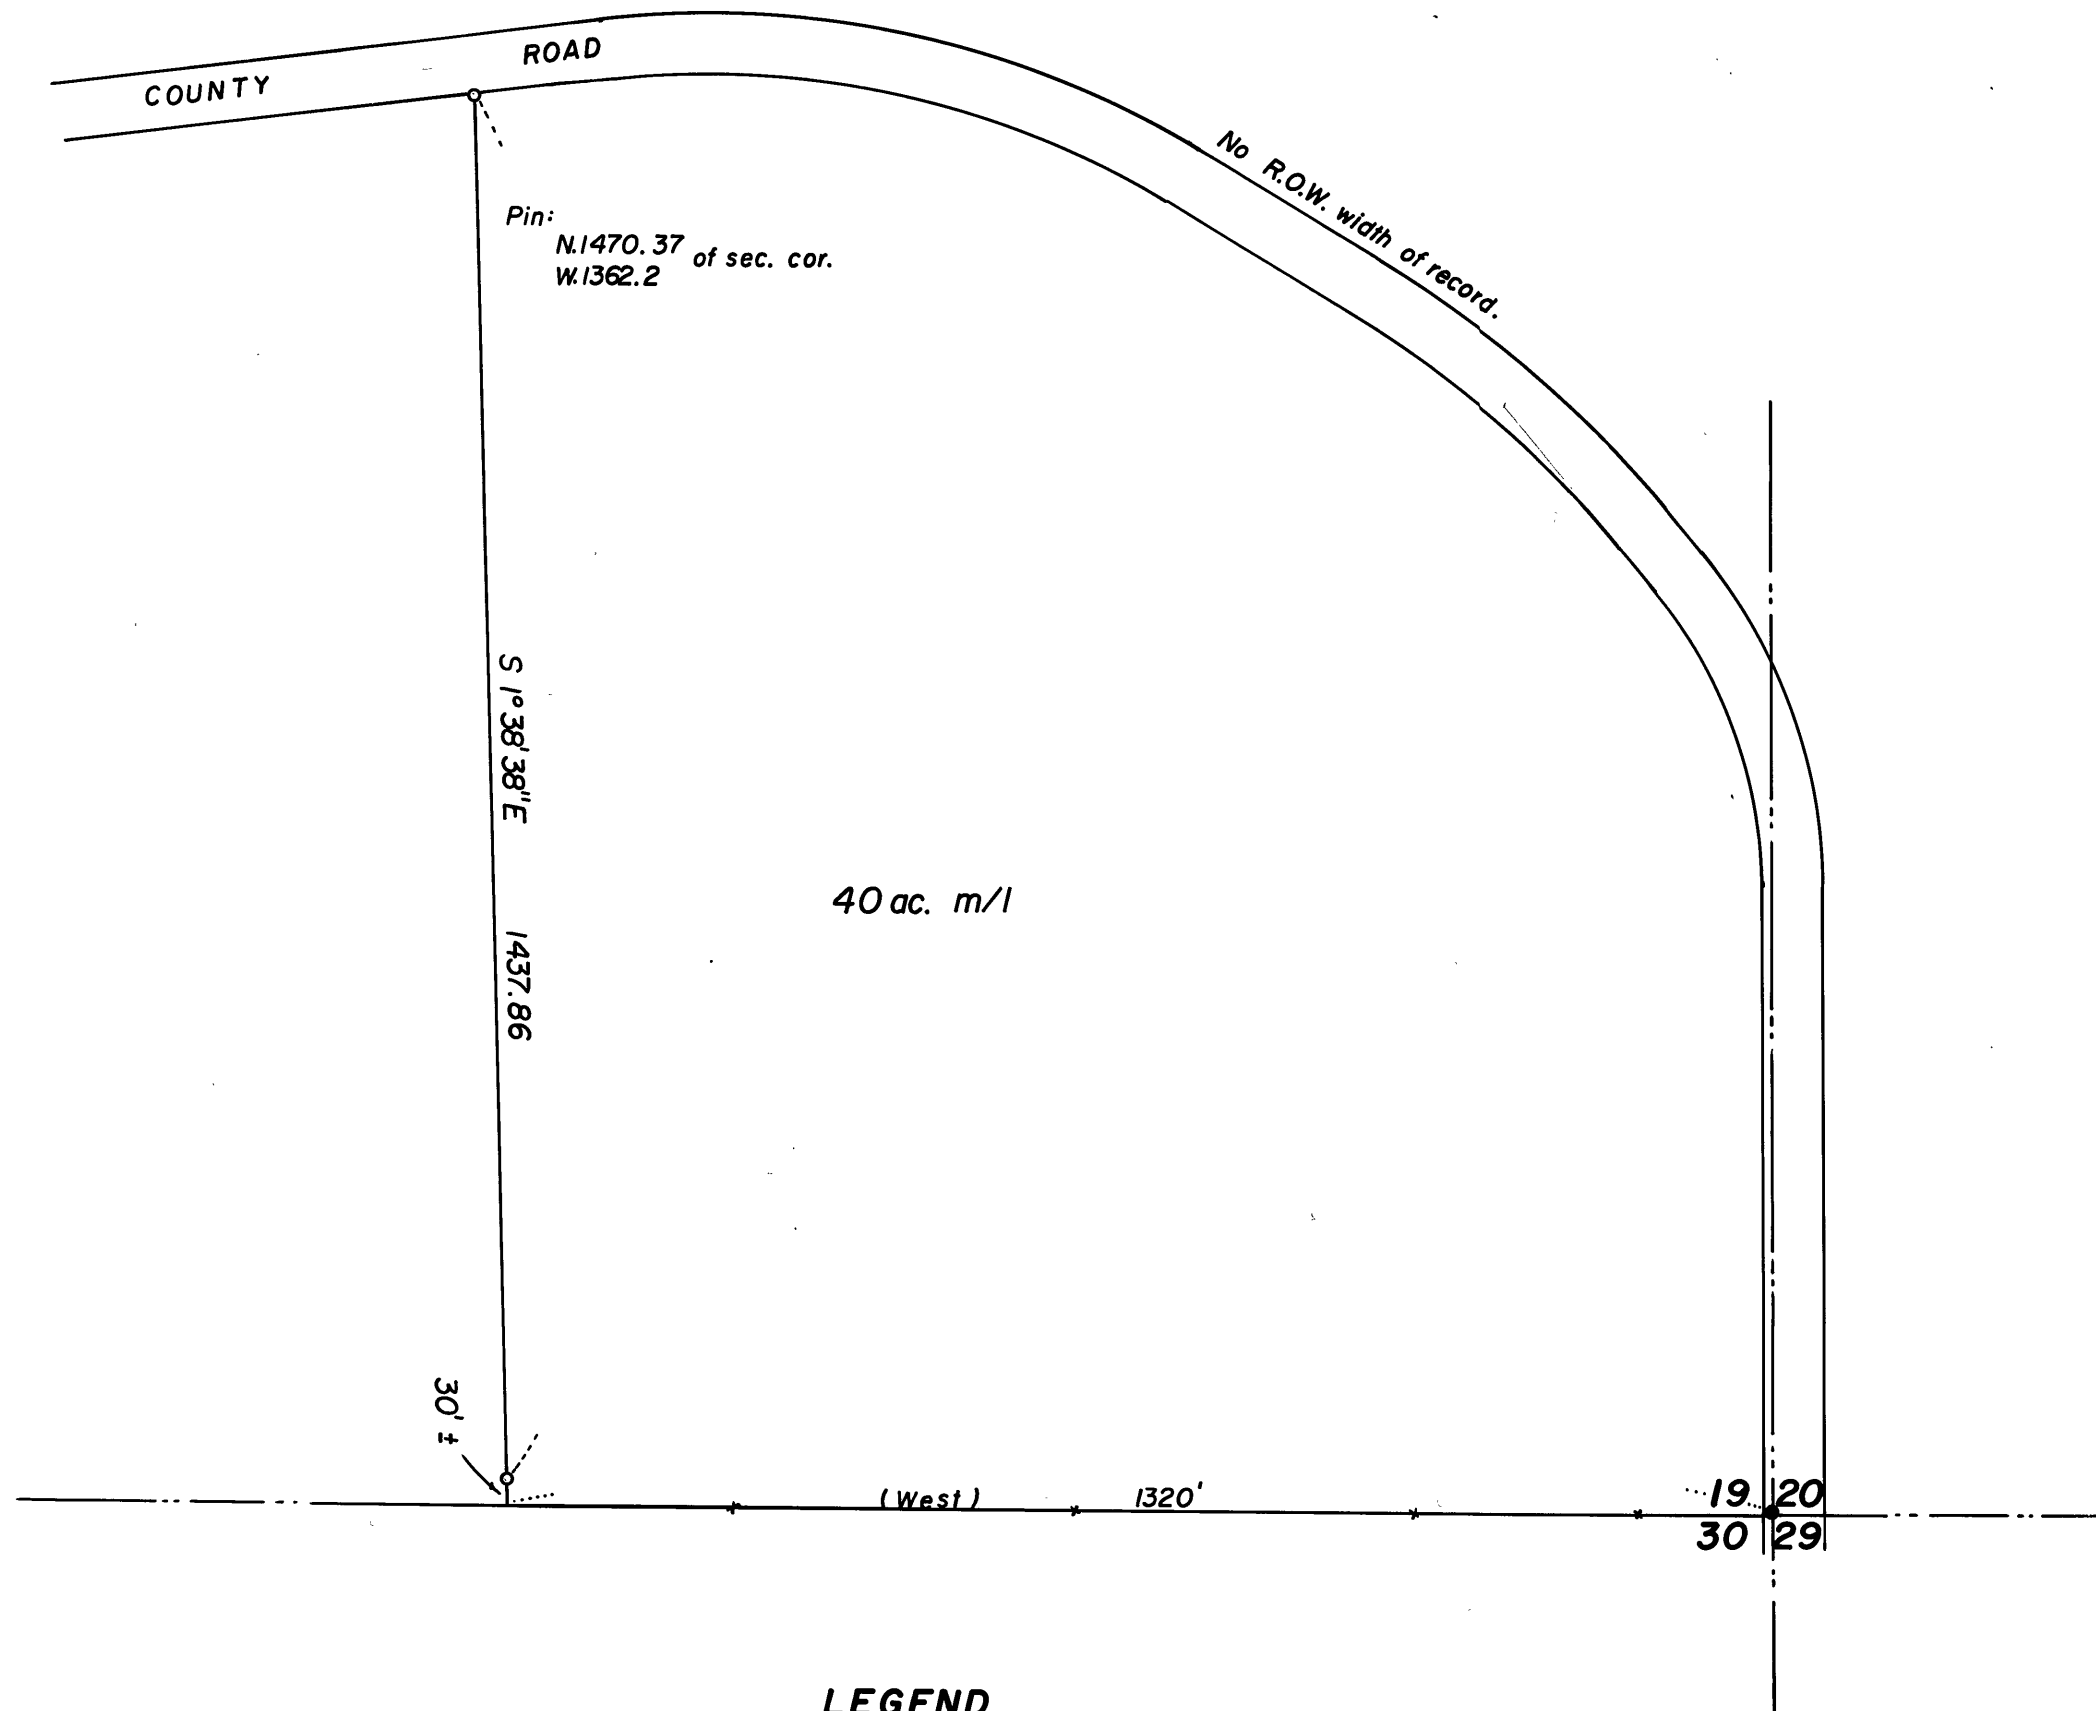

# **BASIS OF BEARINGS**

Solar Observation

REGISTERED  
PROFESSIONAL  
LAND SURVEYOR

*Robert D. Bagett*

OREGON  
JULY 12, 1963  
ROBERT D. BAGETT  
598

RECEIVED AND  
FILED

OCT 2 1974

JOHN LIVEIRA, County Clerk

By *Debra J. J. J.* Deputy

## **LEGEND**

- Set 5/8" x 30" iron pin
- Fd. 2" iron pipe commonly accepted as the cor. common to secs. 19, 20, 29, & 30.

## **BAGETT, GRIFFITH & ASSOCIATES**

John Day, Oregon

Map of Survey

A PARCEL SITUATED IN THE  
SE 1/4 OF SEC. 19

T. 13S., R. 30E., W. 1M.

GRANT COUNTY, OREGON

|                  |                      |         |
|------------------|----------------------|---------|
| SURVEYED FOR     | BOB HOLLAND          |         |
| SURVEYED BY      | R.D.B.—D.I.G.—R.B.C. | 9-6-74  |
| Scale: 1" = 200' | Drawn by: R.D.B.     | 9-12-74 |